


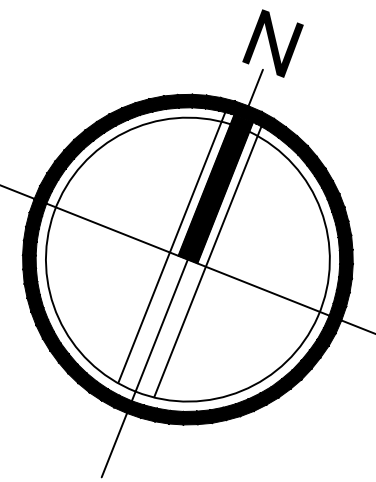


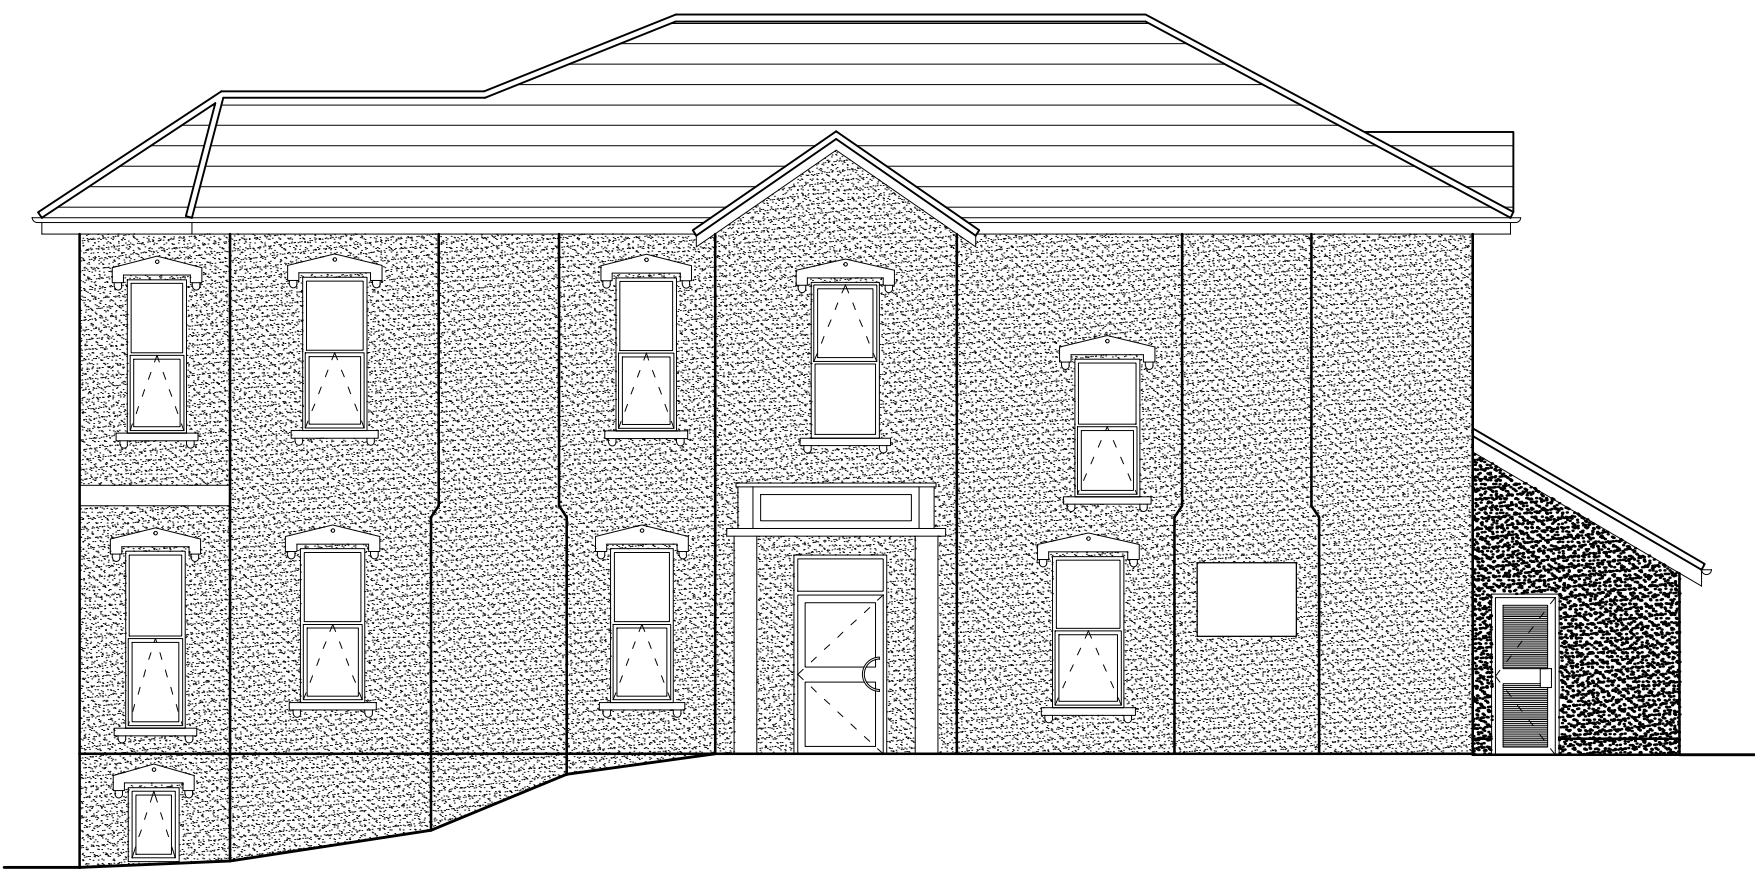


This drawing is not to be scaled or manipulated in any way.  
Any errors or discrepancies should be reported to SDA Architecture.  
Work to given dimensions only which the contractor must check and confirm all dimensions on site.  
Copyright to remain with SDA Architecture and is not to be copied, lent or used by any third party without the express written permission of SDA Architecture.

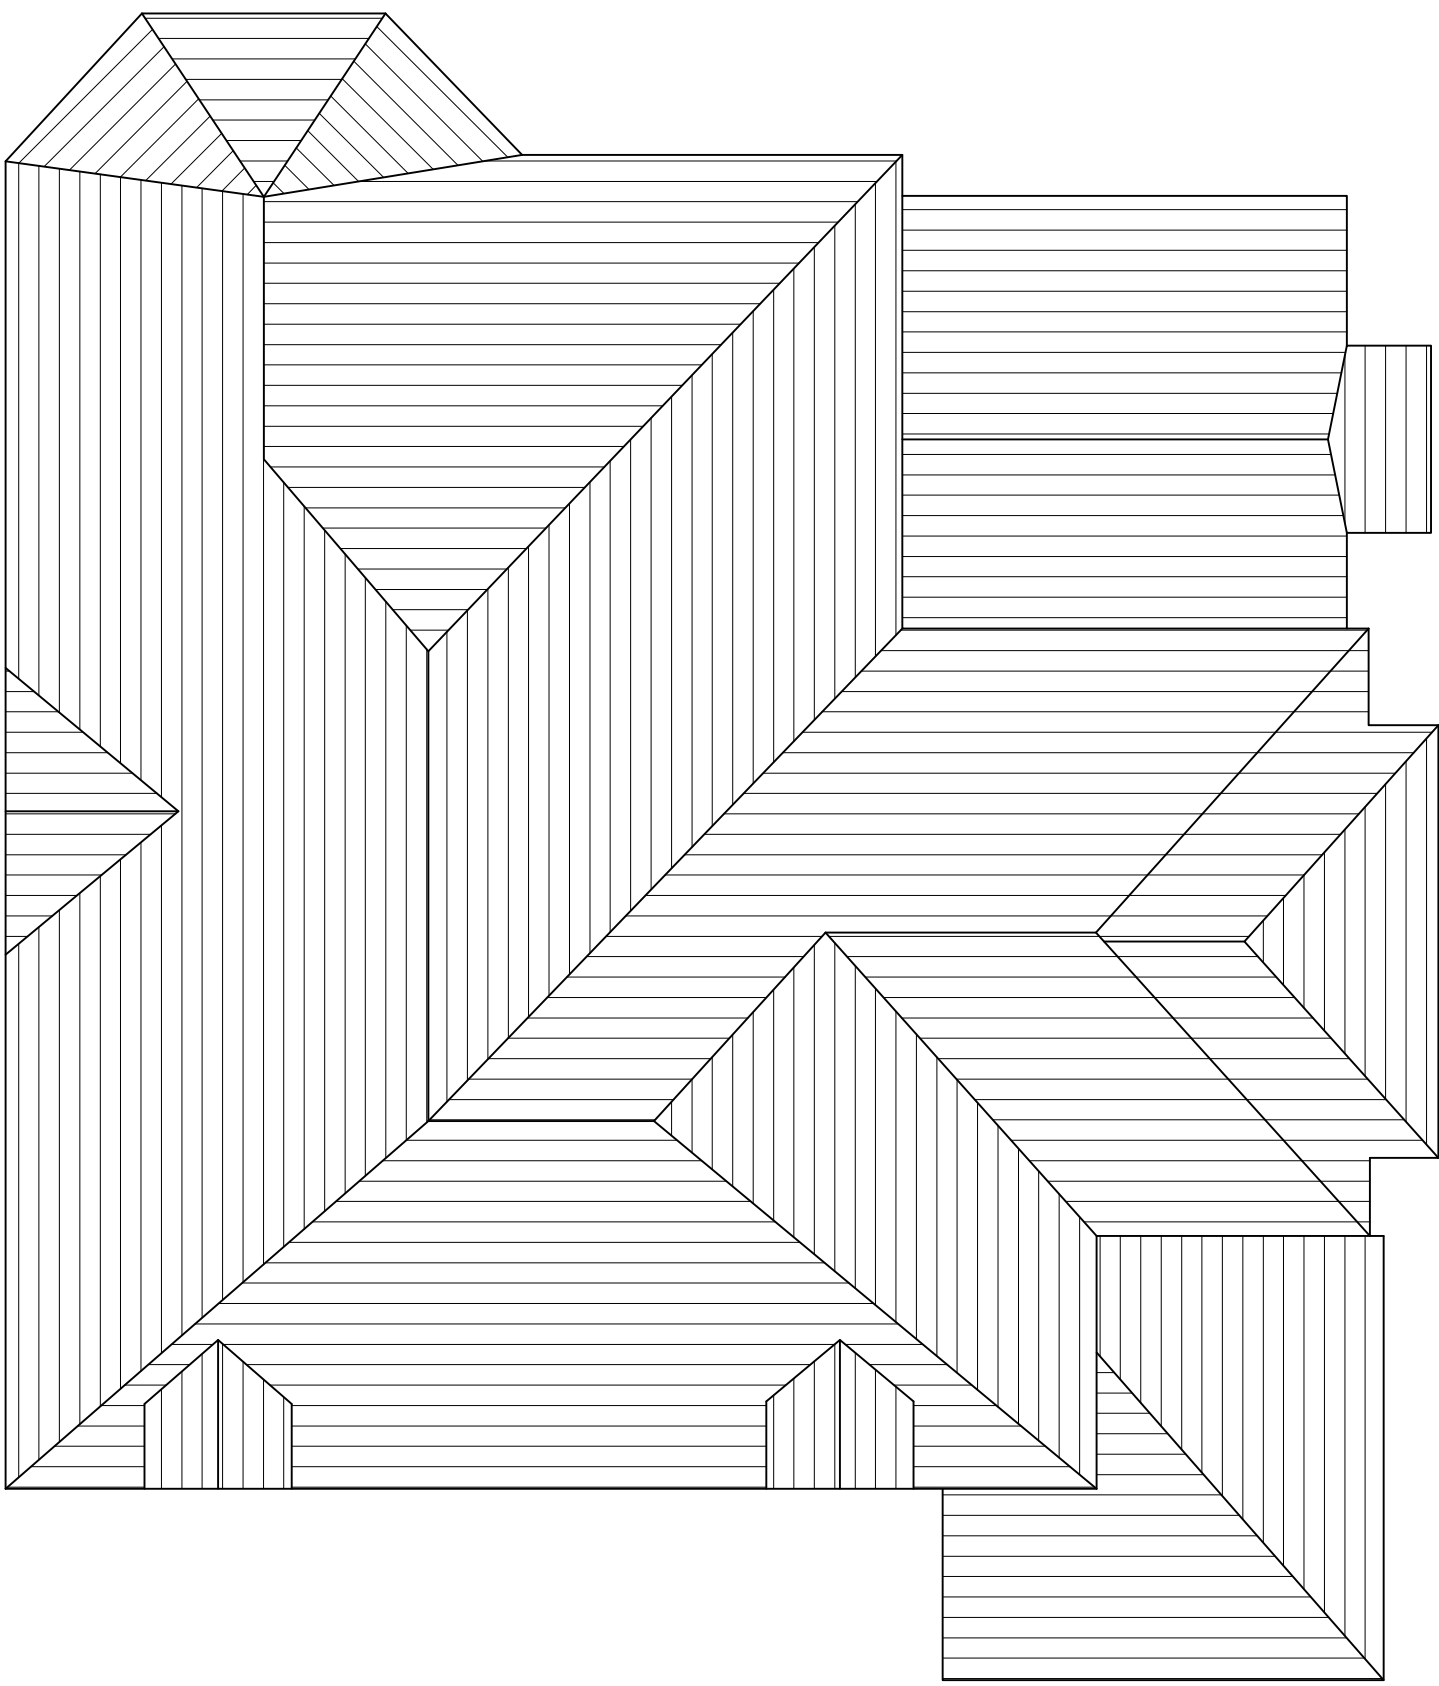

FRONT ELEVATION  
(West)

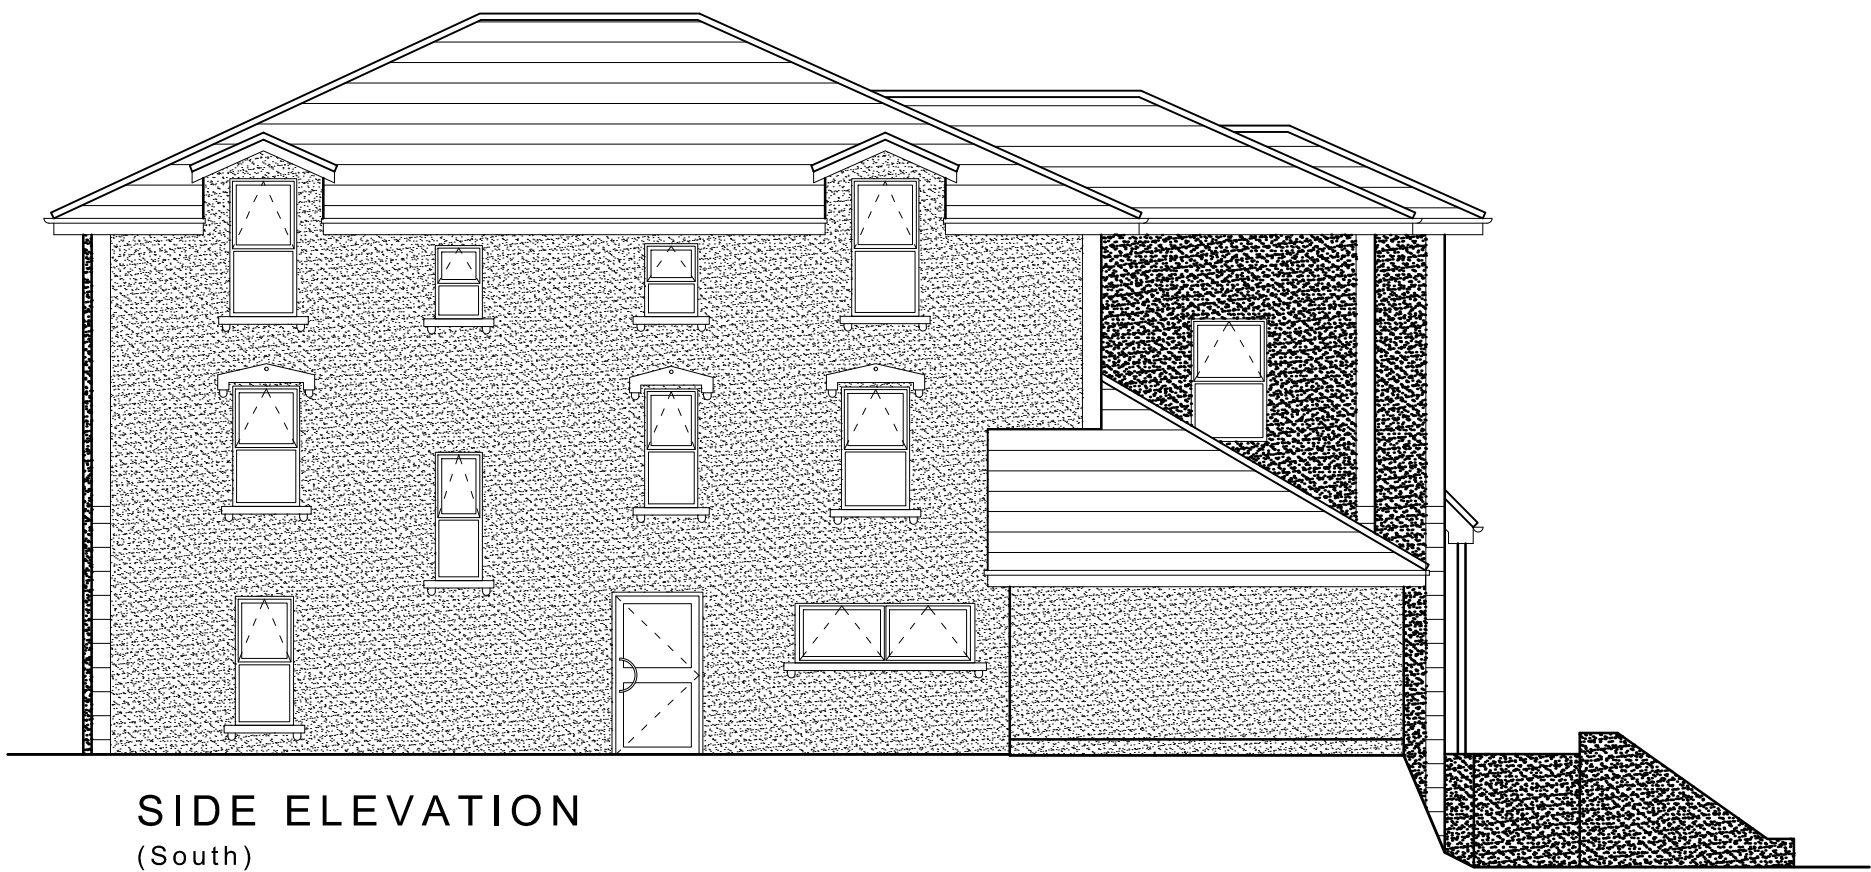


SIDE ELEVATION  
(South)

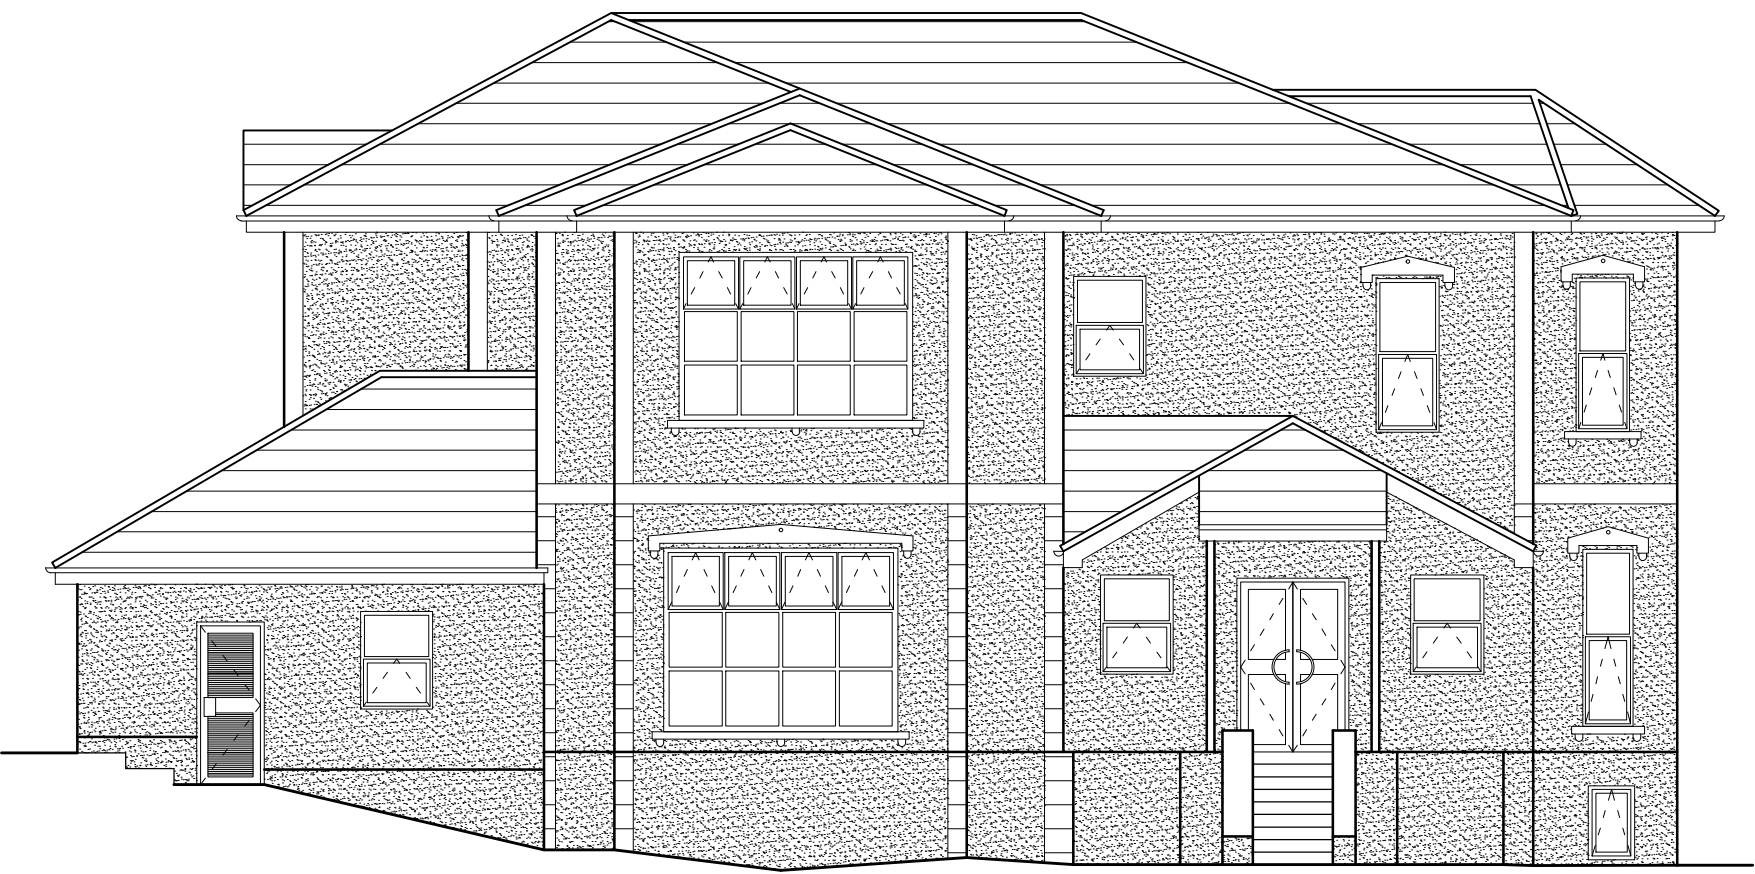

REAR ELEVATION  
(East)



SIDE ELEVATION  
(North)

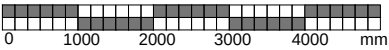

The Old Post Office  
34 Wellington Road  
Oxton  
Wirral  
CH43 2JF

Tel: 0151-651-1789  
e-mail: admin@sdaarchitecture.com  
Web: www.sdaarchitecture.com

## PAIGNTON



| Project Location                        | Project Description |
|-----------------------------------------|---------------------|
| 9 Belle Vue Road<br>Paignton<br>TQ4 6ES | Measured Survey     |

| Drawing Title            |             |
|--------------------------|-------------|
| Elevations And Roof Plan |             |
| Drawn By:                | Scale @ A1: |
| A Dore                   | 1:100       |
| Date:                    | Revision:   |
| 09.06.2016               | --          |
| Project Ref:             | Drawing No: |
| 96_2016                  | 96_2016_13  |