


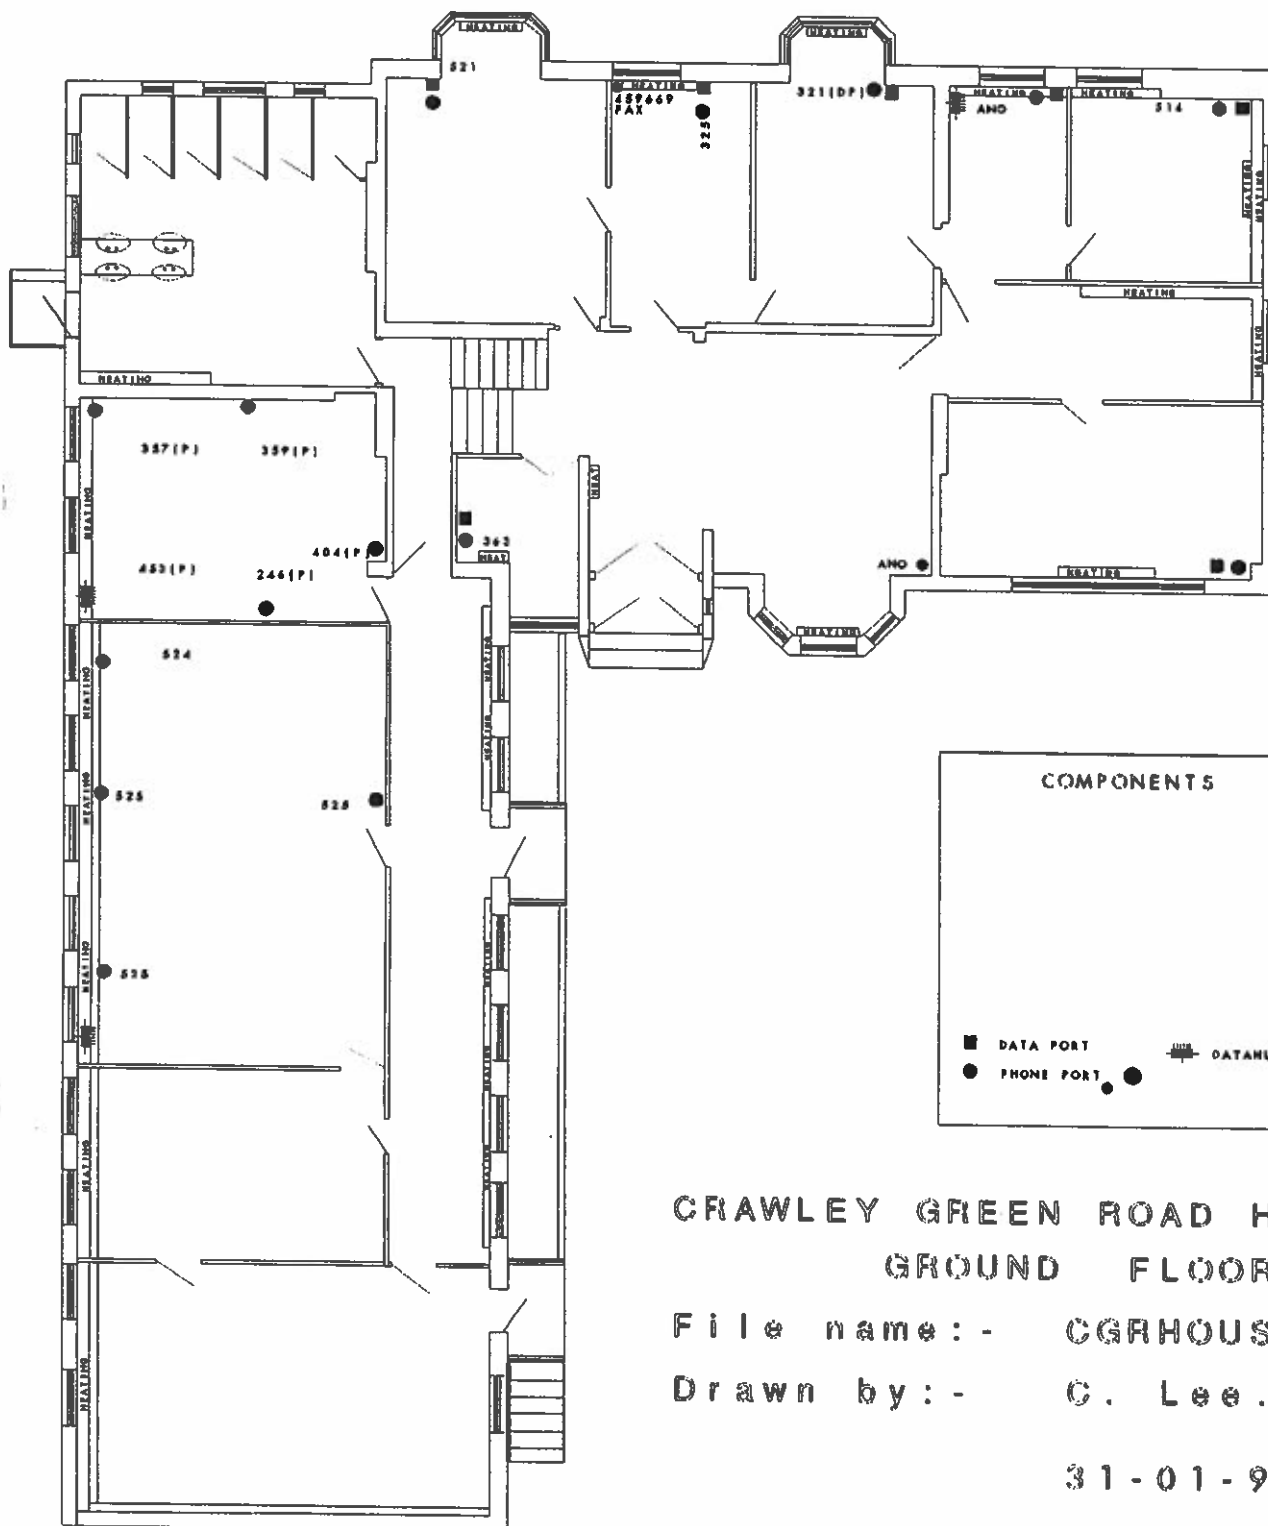



CRAWLEY GREEN ROAD HOUSE GROUND FLOOR

File name:- CGRHOUSE

Drawn by:- C. Lee.

31-01-98

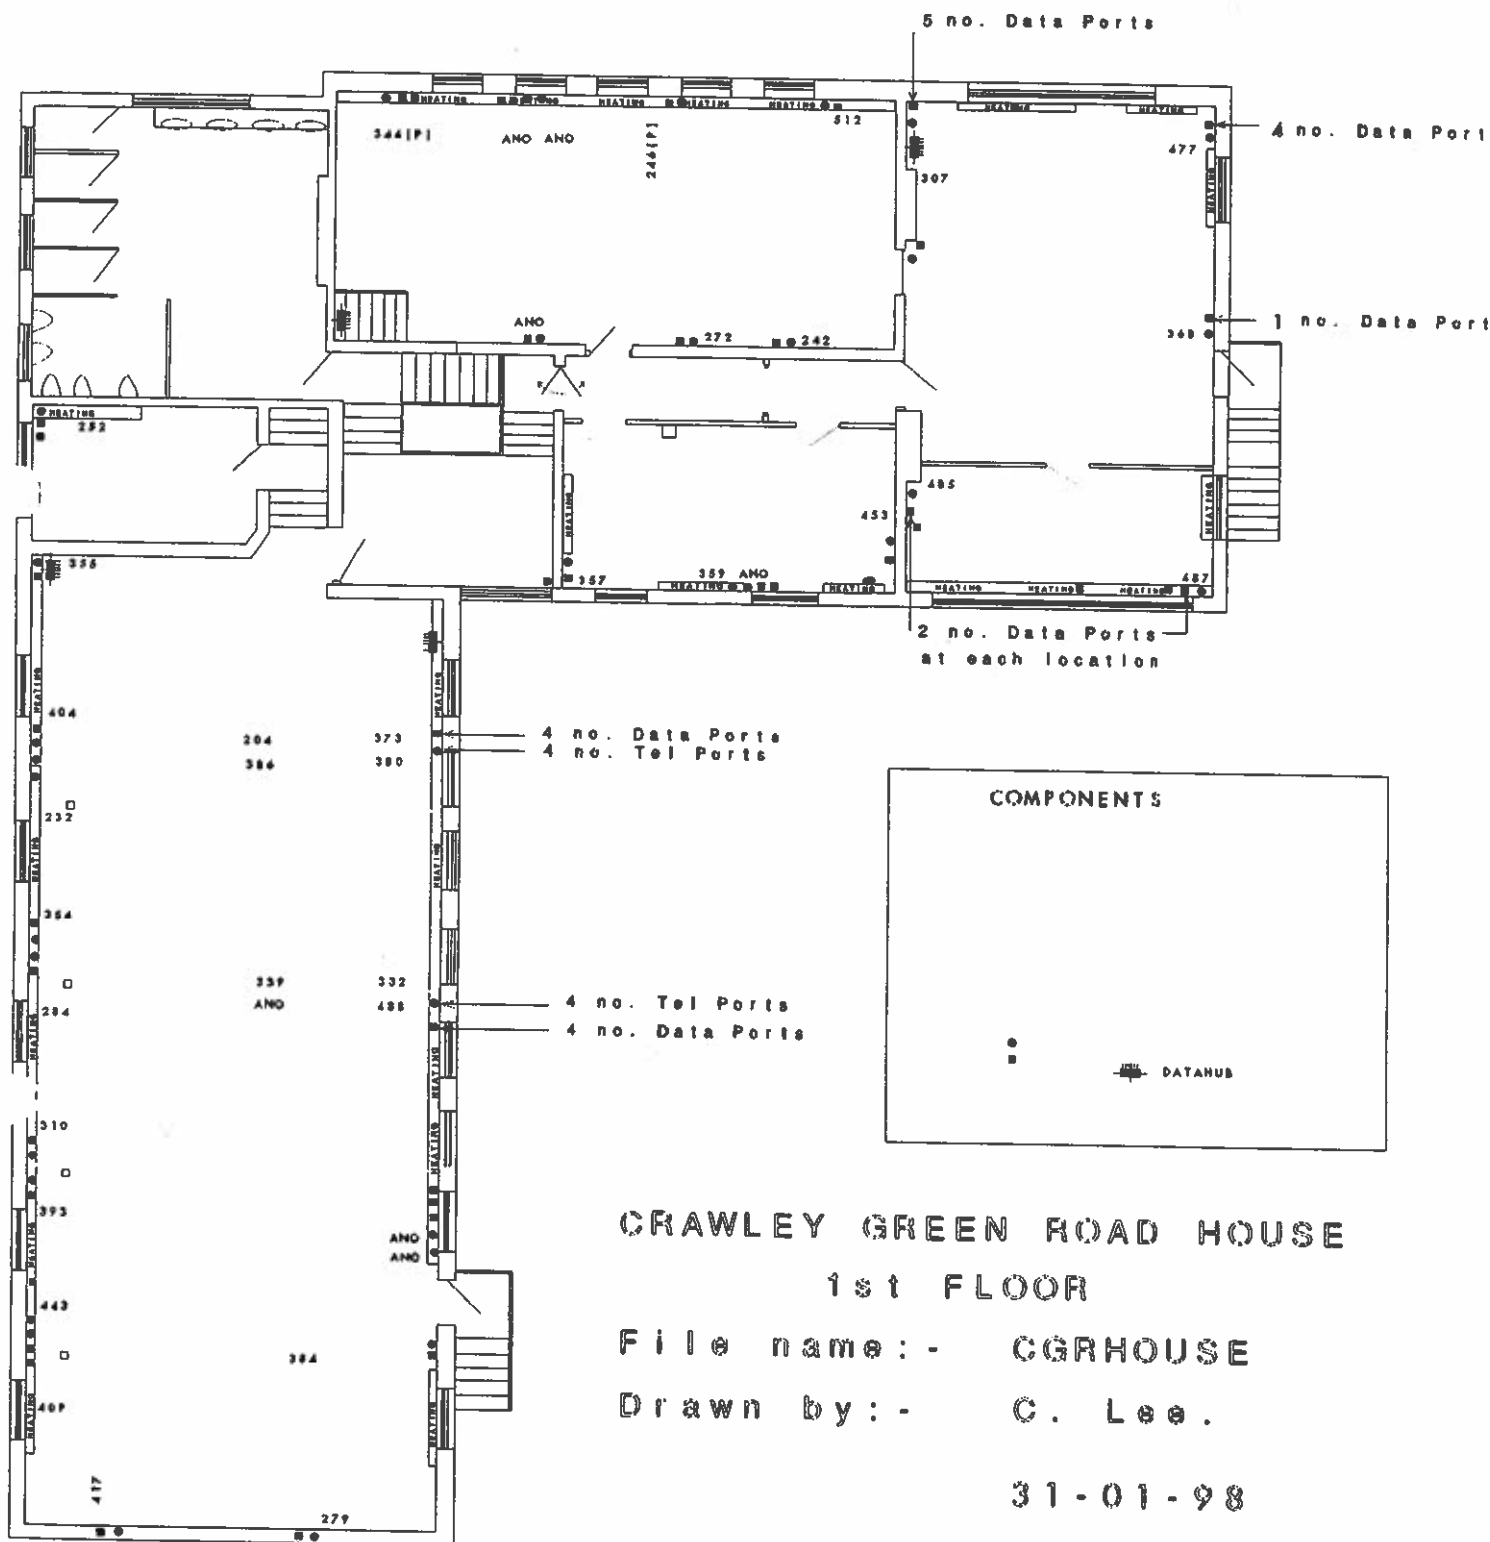

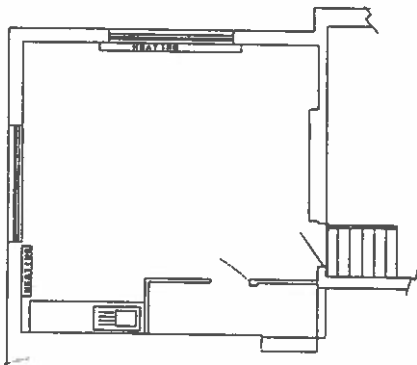


CRAWLEY GREEN ROAD HOUSE
2nd FLOOR

File name: - CGRHOUSE

Drawn by: - C. Lee.

31-01-98

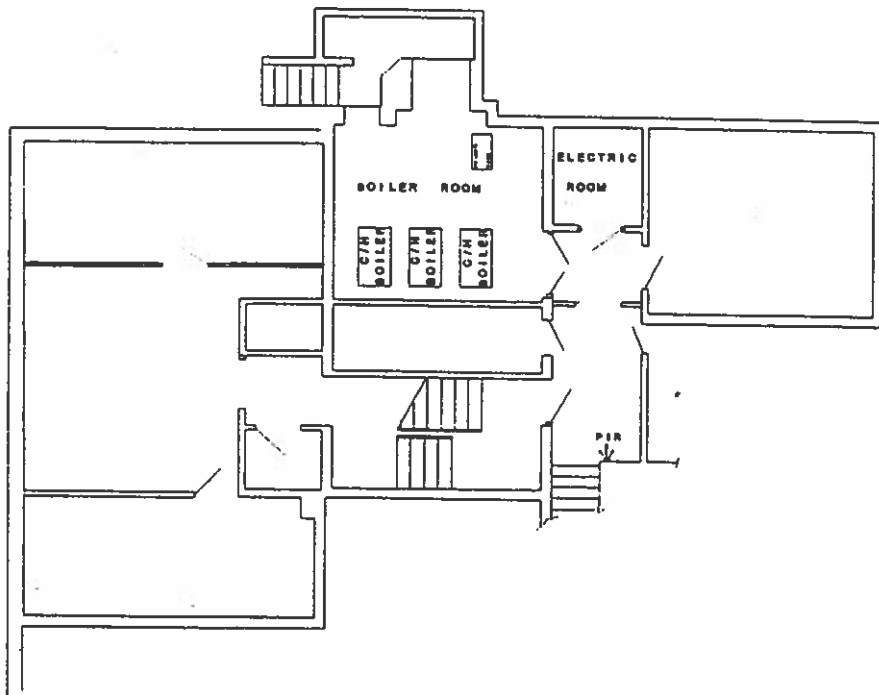

COMPONENTS

**CRAWLEY GREEN ROAD HOUSE
BASEMENT**

File name: - - CGRHOUSE

Drawn by: - C. Lee.

31-01-98