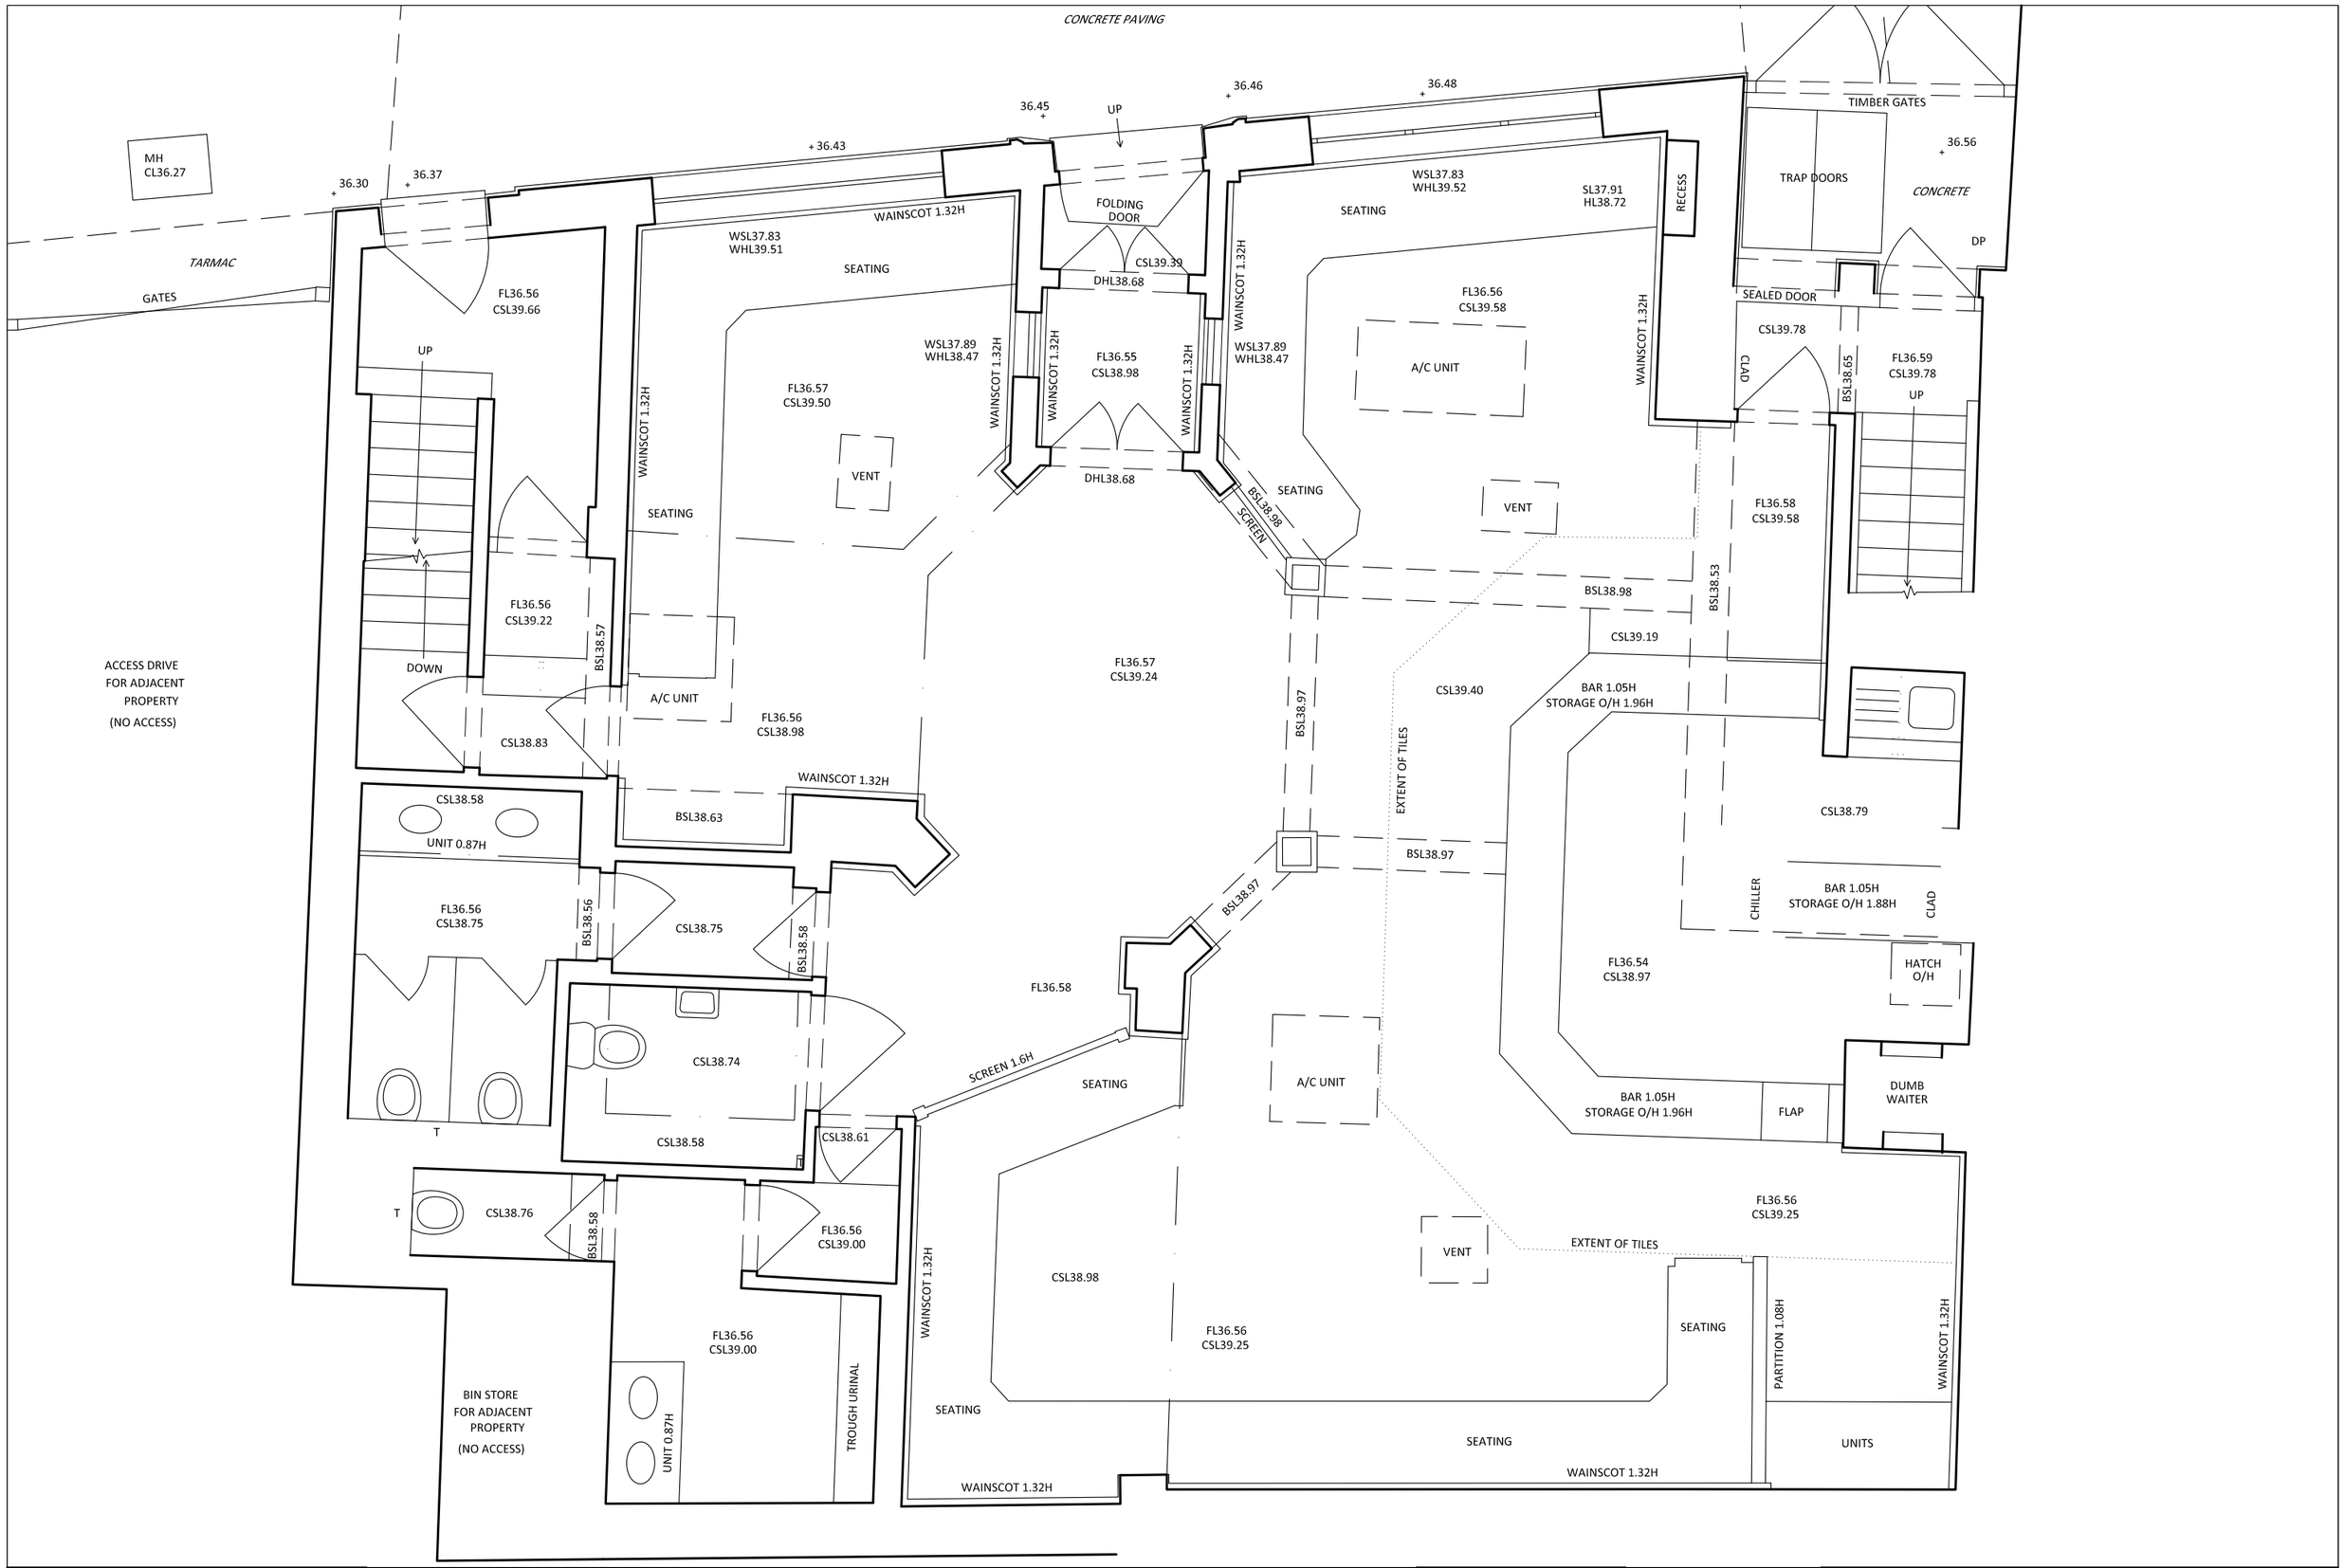

CLIENT	PROJECT	DRAWING	DRAWING NO.	REV		
TIMOTHY TAYLOR & CO. LTD. Knowle Spring Brewery Keighley BD21 1AW	**THE TOWN HALL TAVERN** 17 Westgate, Leeds LS1 2RA	Ground Floor Plan	662-THT-03		SCALE 1:50 @ A3 DRAWN MR DATE NOV 2014	REGAN ASSOCIATES The Fold, Westfield Farm, Tim Lane, Oakworth, Keighley BD22 7SA Tel: 01535 643202 Mob: 07866 731861 Email: mr@mras.co.uk