




Notes

ALL LEVELS ARE IN METRES DERIVED FROM GPS TRANSFORMATION OSGM15  
 THE CO-ORDINATES ARE DERIVED FROM THE ORDNANCE SURVEY ACTIVE STATION NETWORK OSTN15 (BASE STATION ST02)

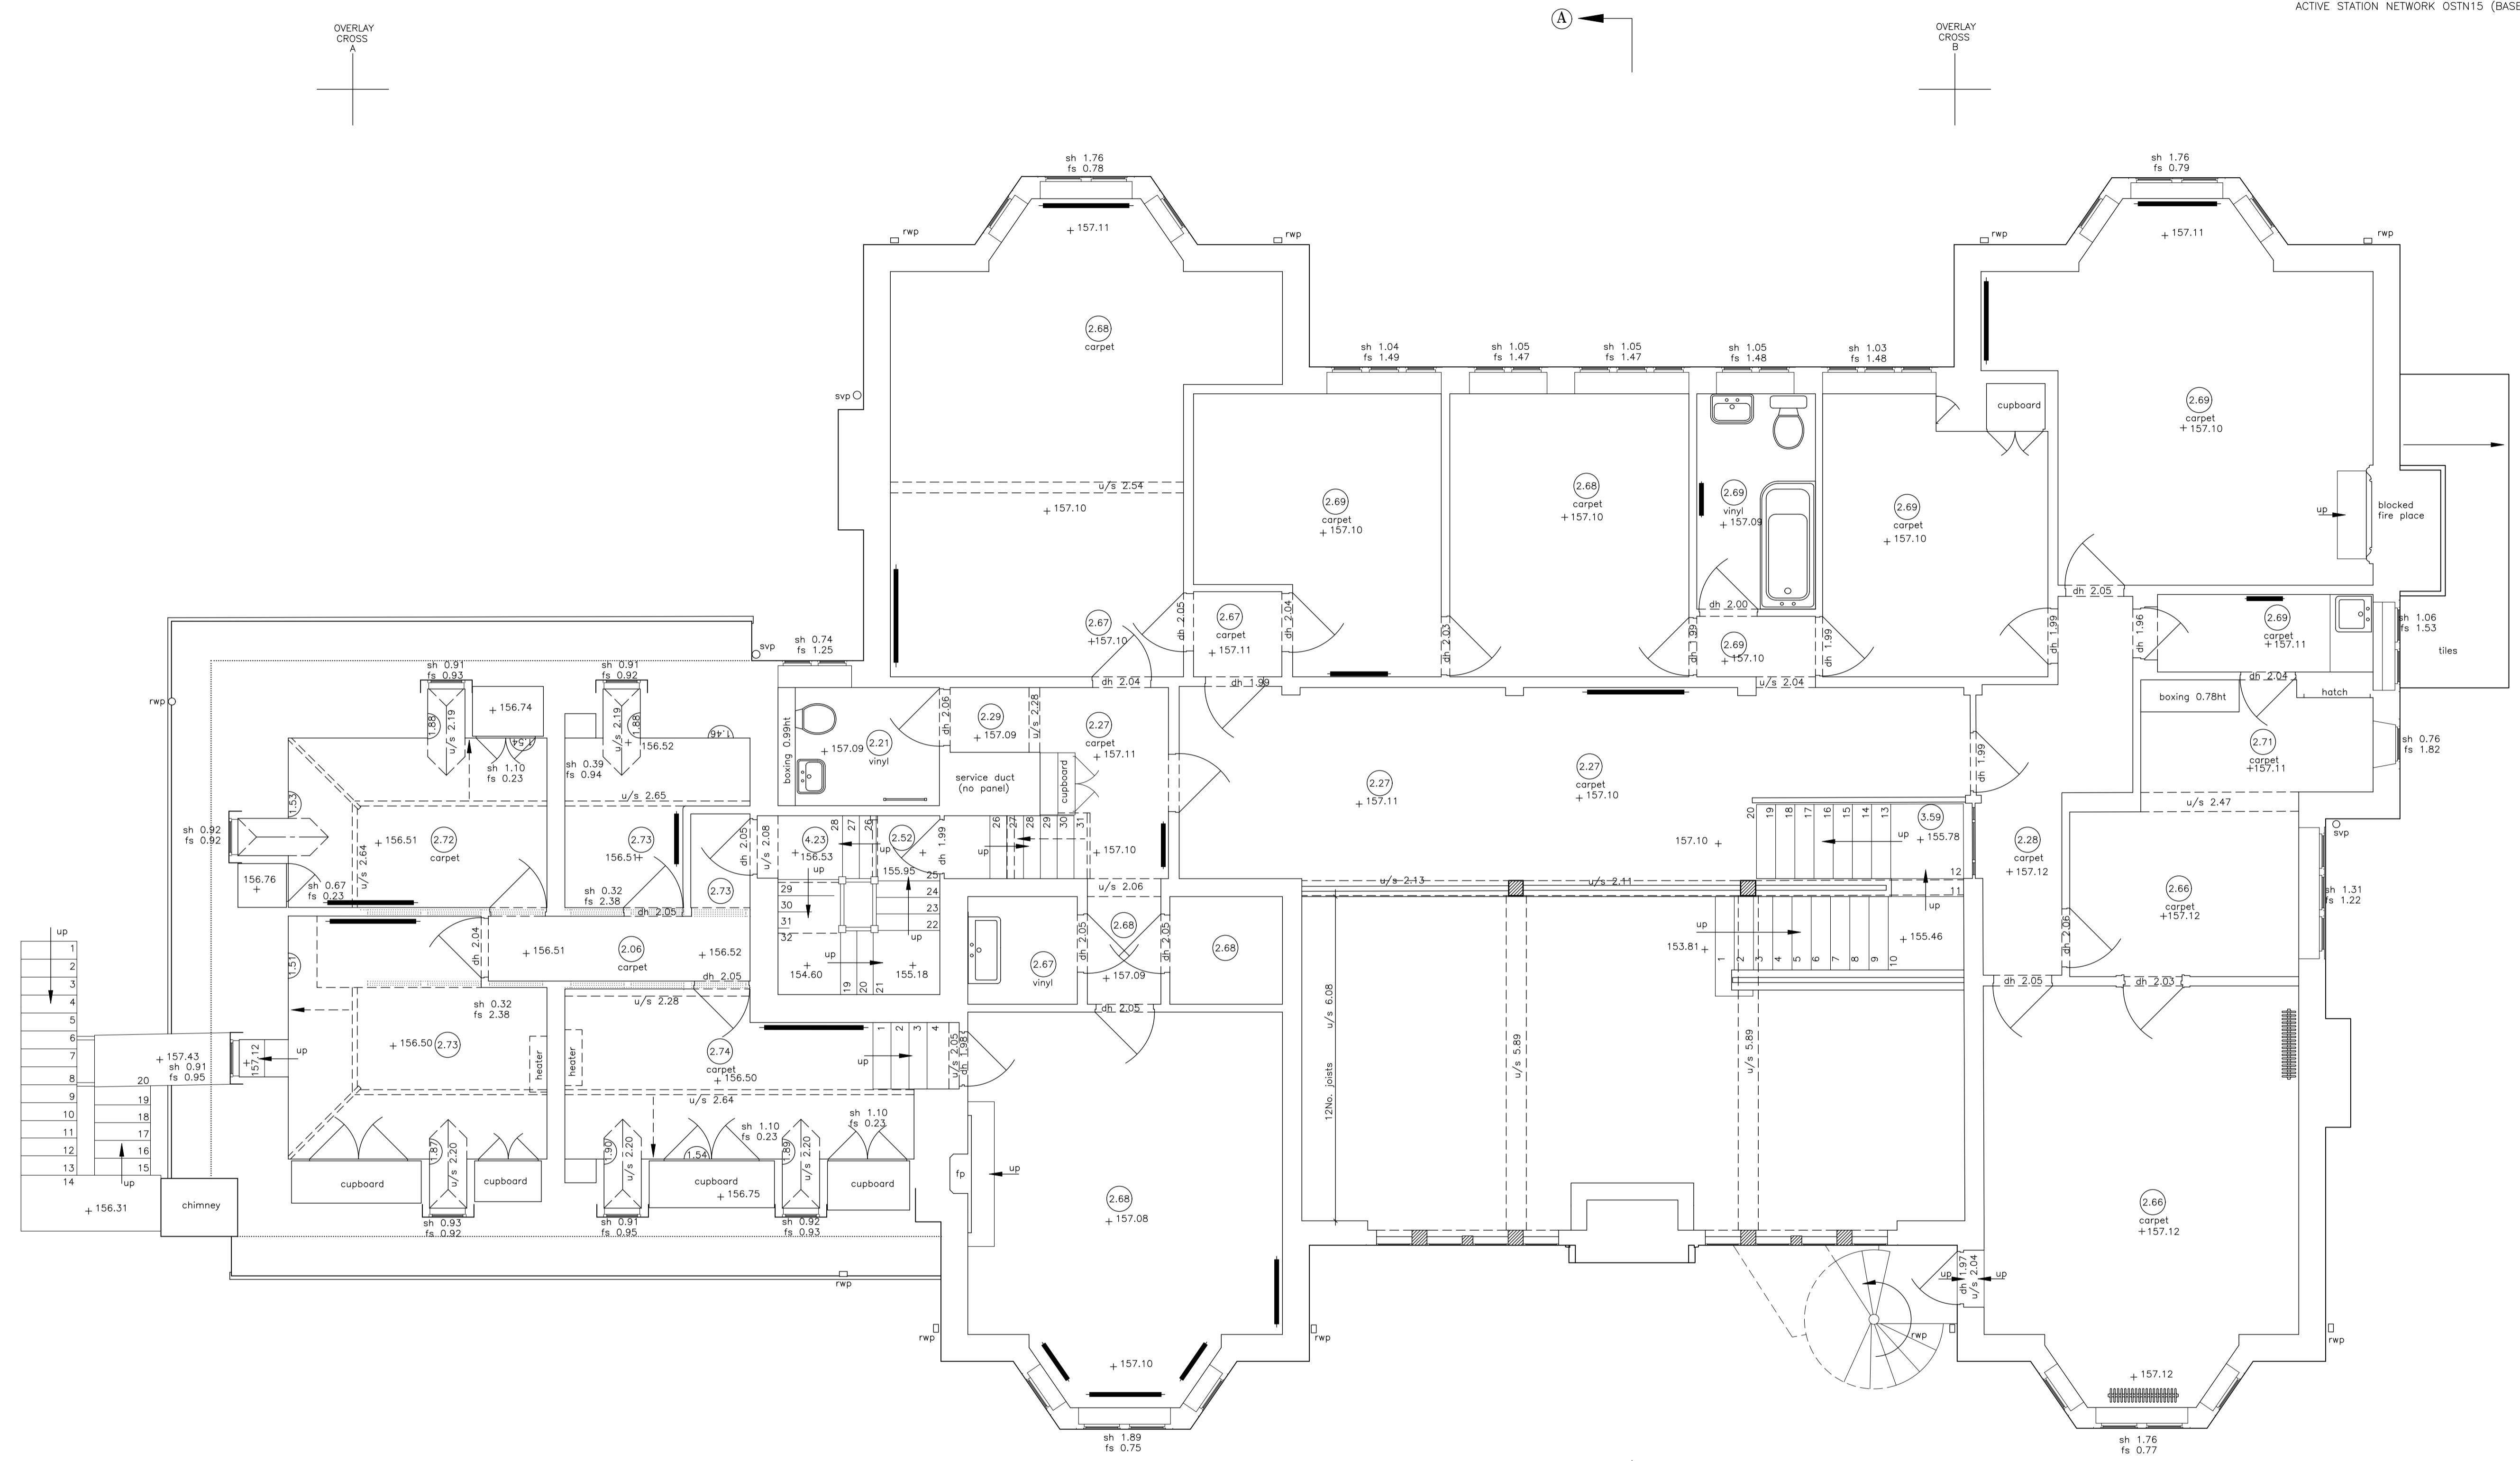

FIRST FLOOR

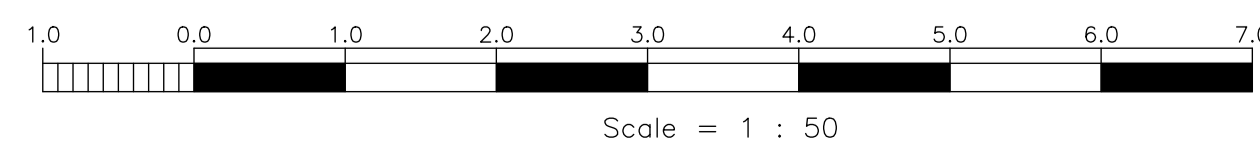

AS/HL/RW © ON CENTRE SURVEYS LTD. 2026	
job <b>BEVAN HOUSE &amp; RAVENSBRURY HOUSE</b> 9 WESTBOURNE ROAD BIRMINGHAM WEST MIDLANDS B15 3TR	
client <b>CALTHORPE ESTATES</b>	
title <b>FIRST FLOOR</b> RAVENSBRURY HOUSE	dwg no. 29785A/5
scale 1/50	date 9th March 2026
 <b>ON CENTRE SURVEYS LTD.</b> LAND & BUILDING SURVEYORS GEODETIC ENGINEERS 2 CHARLES COURT, BUDBROOKE ROAD, WARWICK CV34 5LZ TEL: 01926 494294 E-MAIL: info@oncentre.co.uk A member of The Survey Association	