
2 Euston Place
Leamington Spa
Warwickshire
CV32 4LE




PARTRIDGE
INTERIORS LTD

Partridge Interiors Ltd
4 Ford Farm
Welsh Road West
Southam
Warwickshire
CV47 2BH

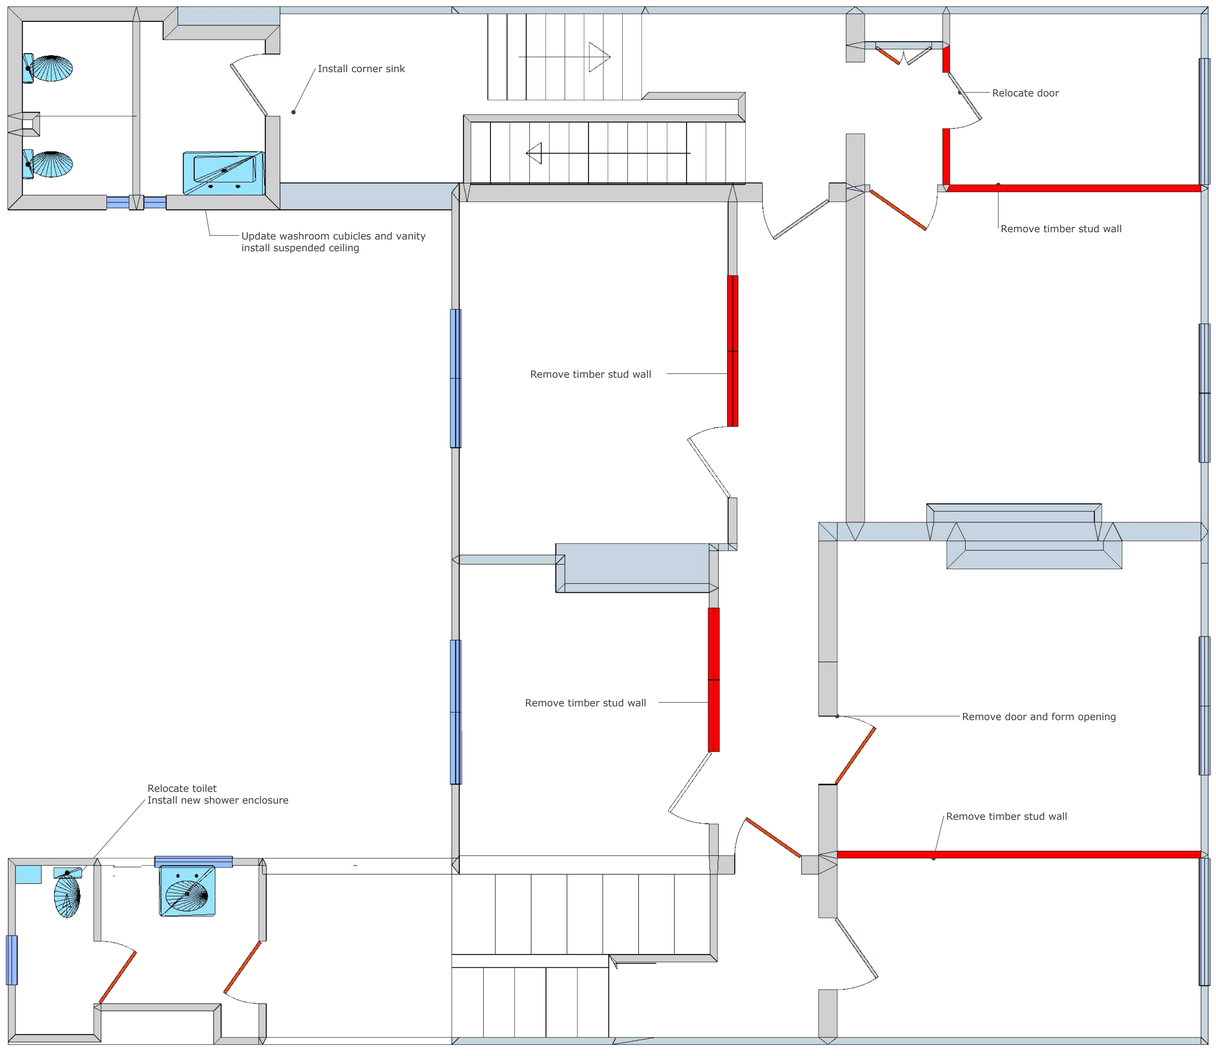

1st Floor existing plan


PARTRIDGE
INTERIORS LTD

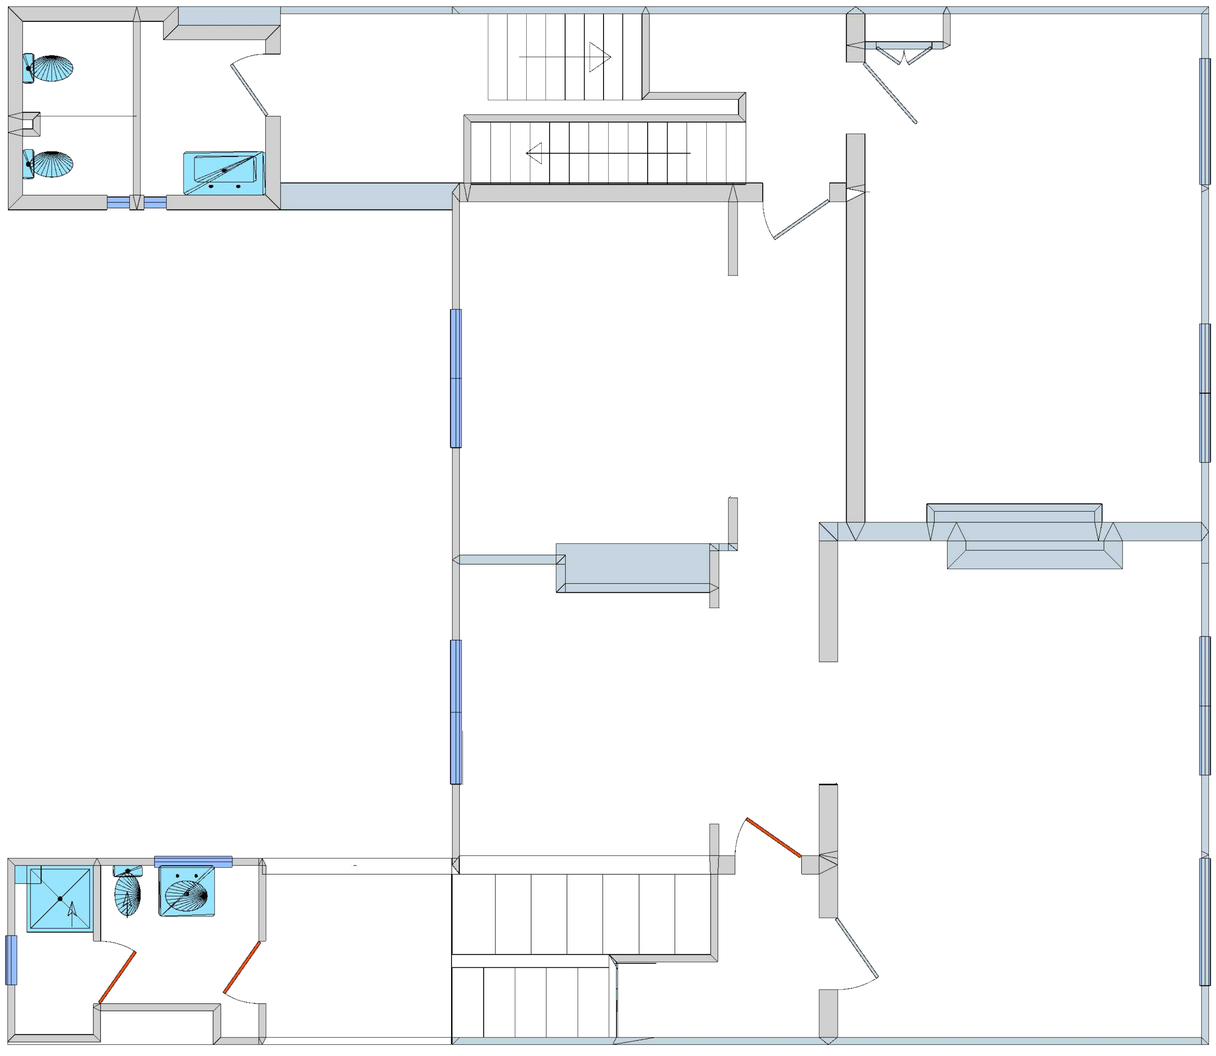

1st Floor New Layout


PARTRIDGE
INTERIORS LTD

Jay Partridge

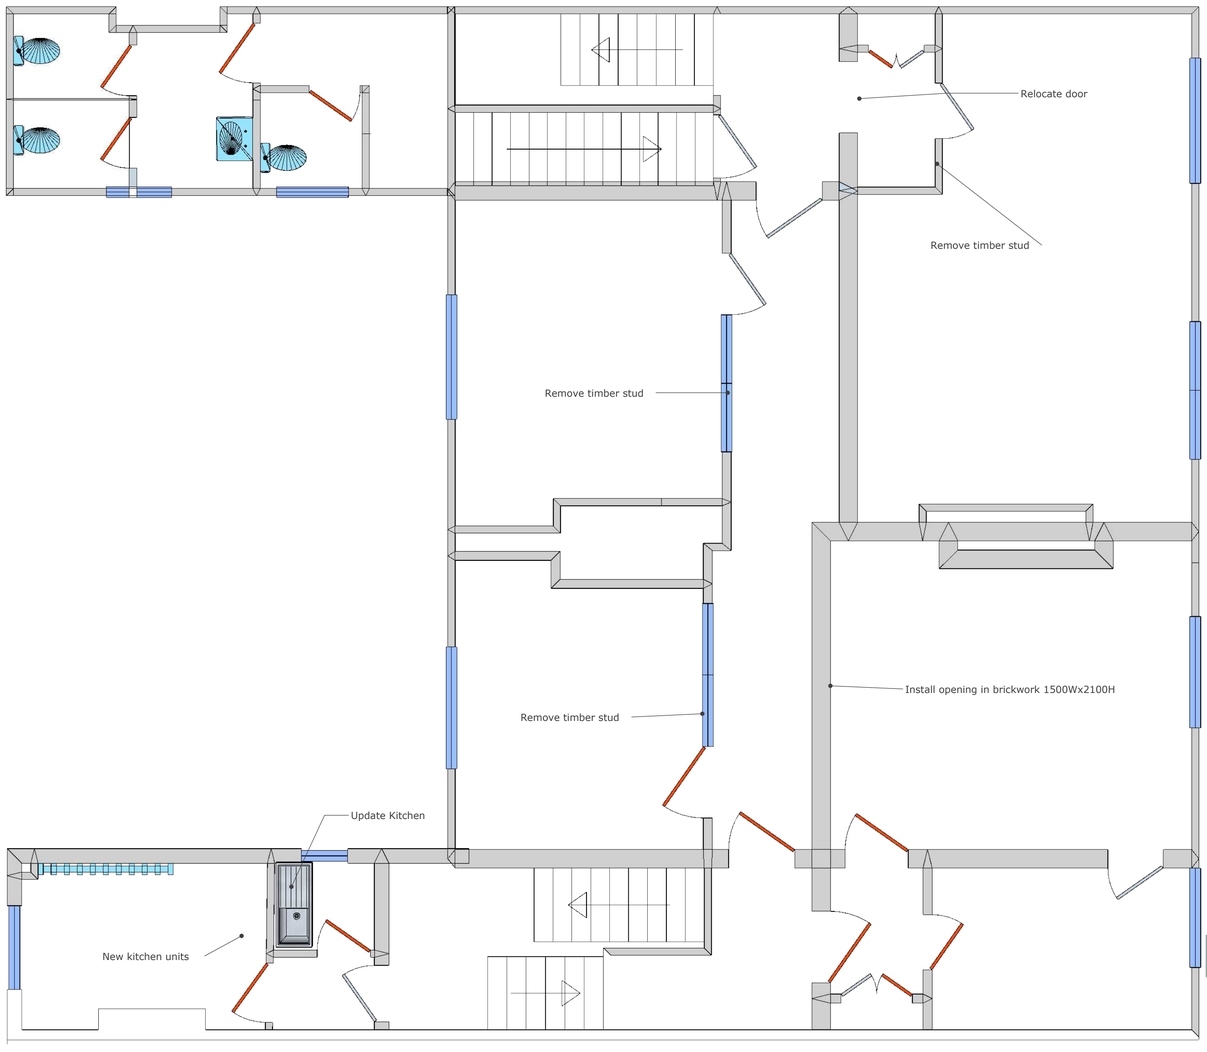

2nd Floor existing plan

PARTRIDGE
INTERIORS LTD

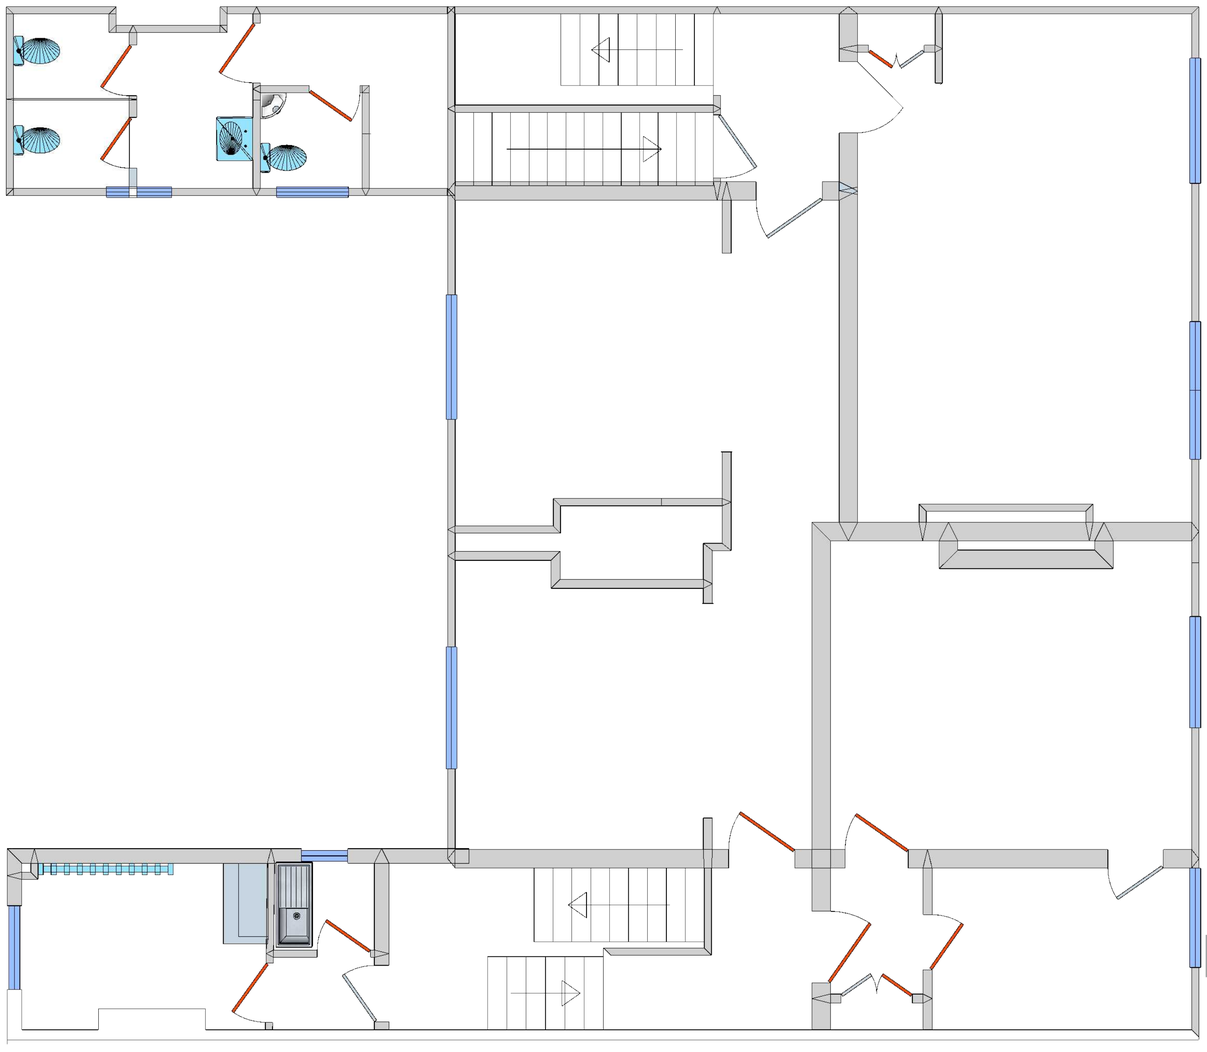

2nd Floor New Layout

PARTRIDGE
INTERIORS LTD

Jay Partridge