


notes

this drawing and design is the copyright of aja architects and must not be reproduced in part or in whole without prior written consent. contractors must verify all dimensions on site before commencing work or preparing shop drawings if in doubt ASK.

Where this drawing contains any Ordnance Survey mapping material, it has been reproduced under license number 100052278.
Ordnance Survey © Crown copyright

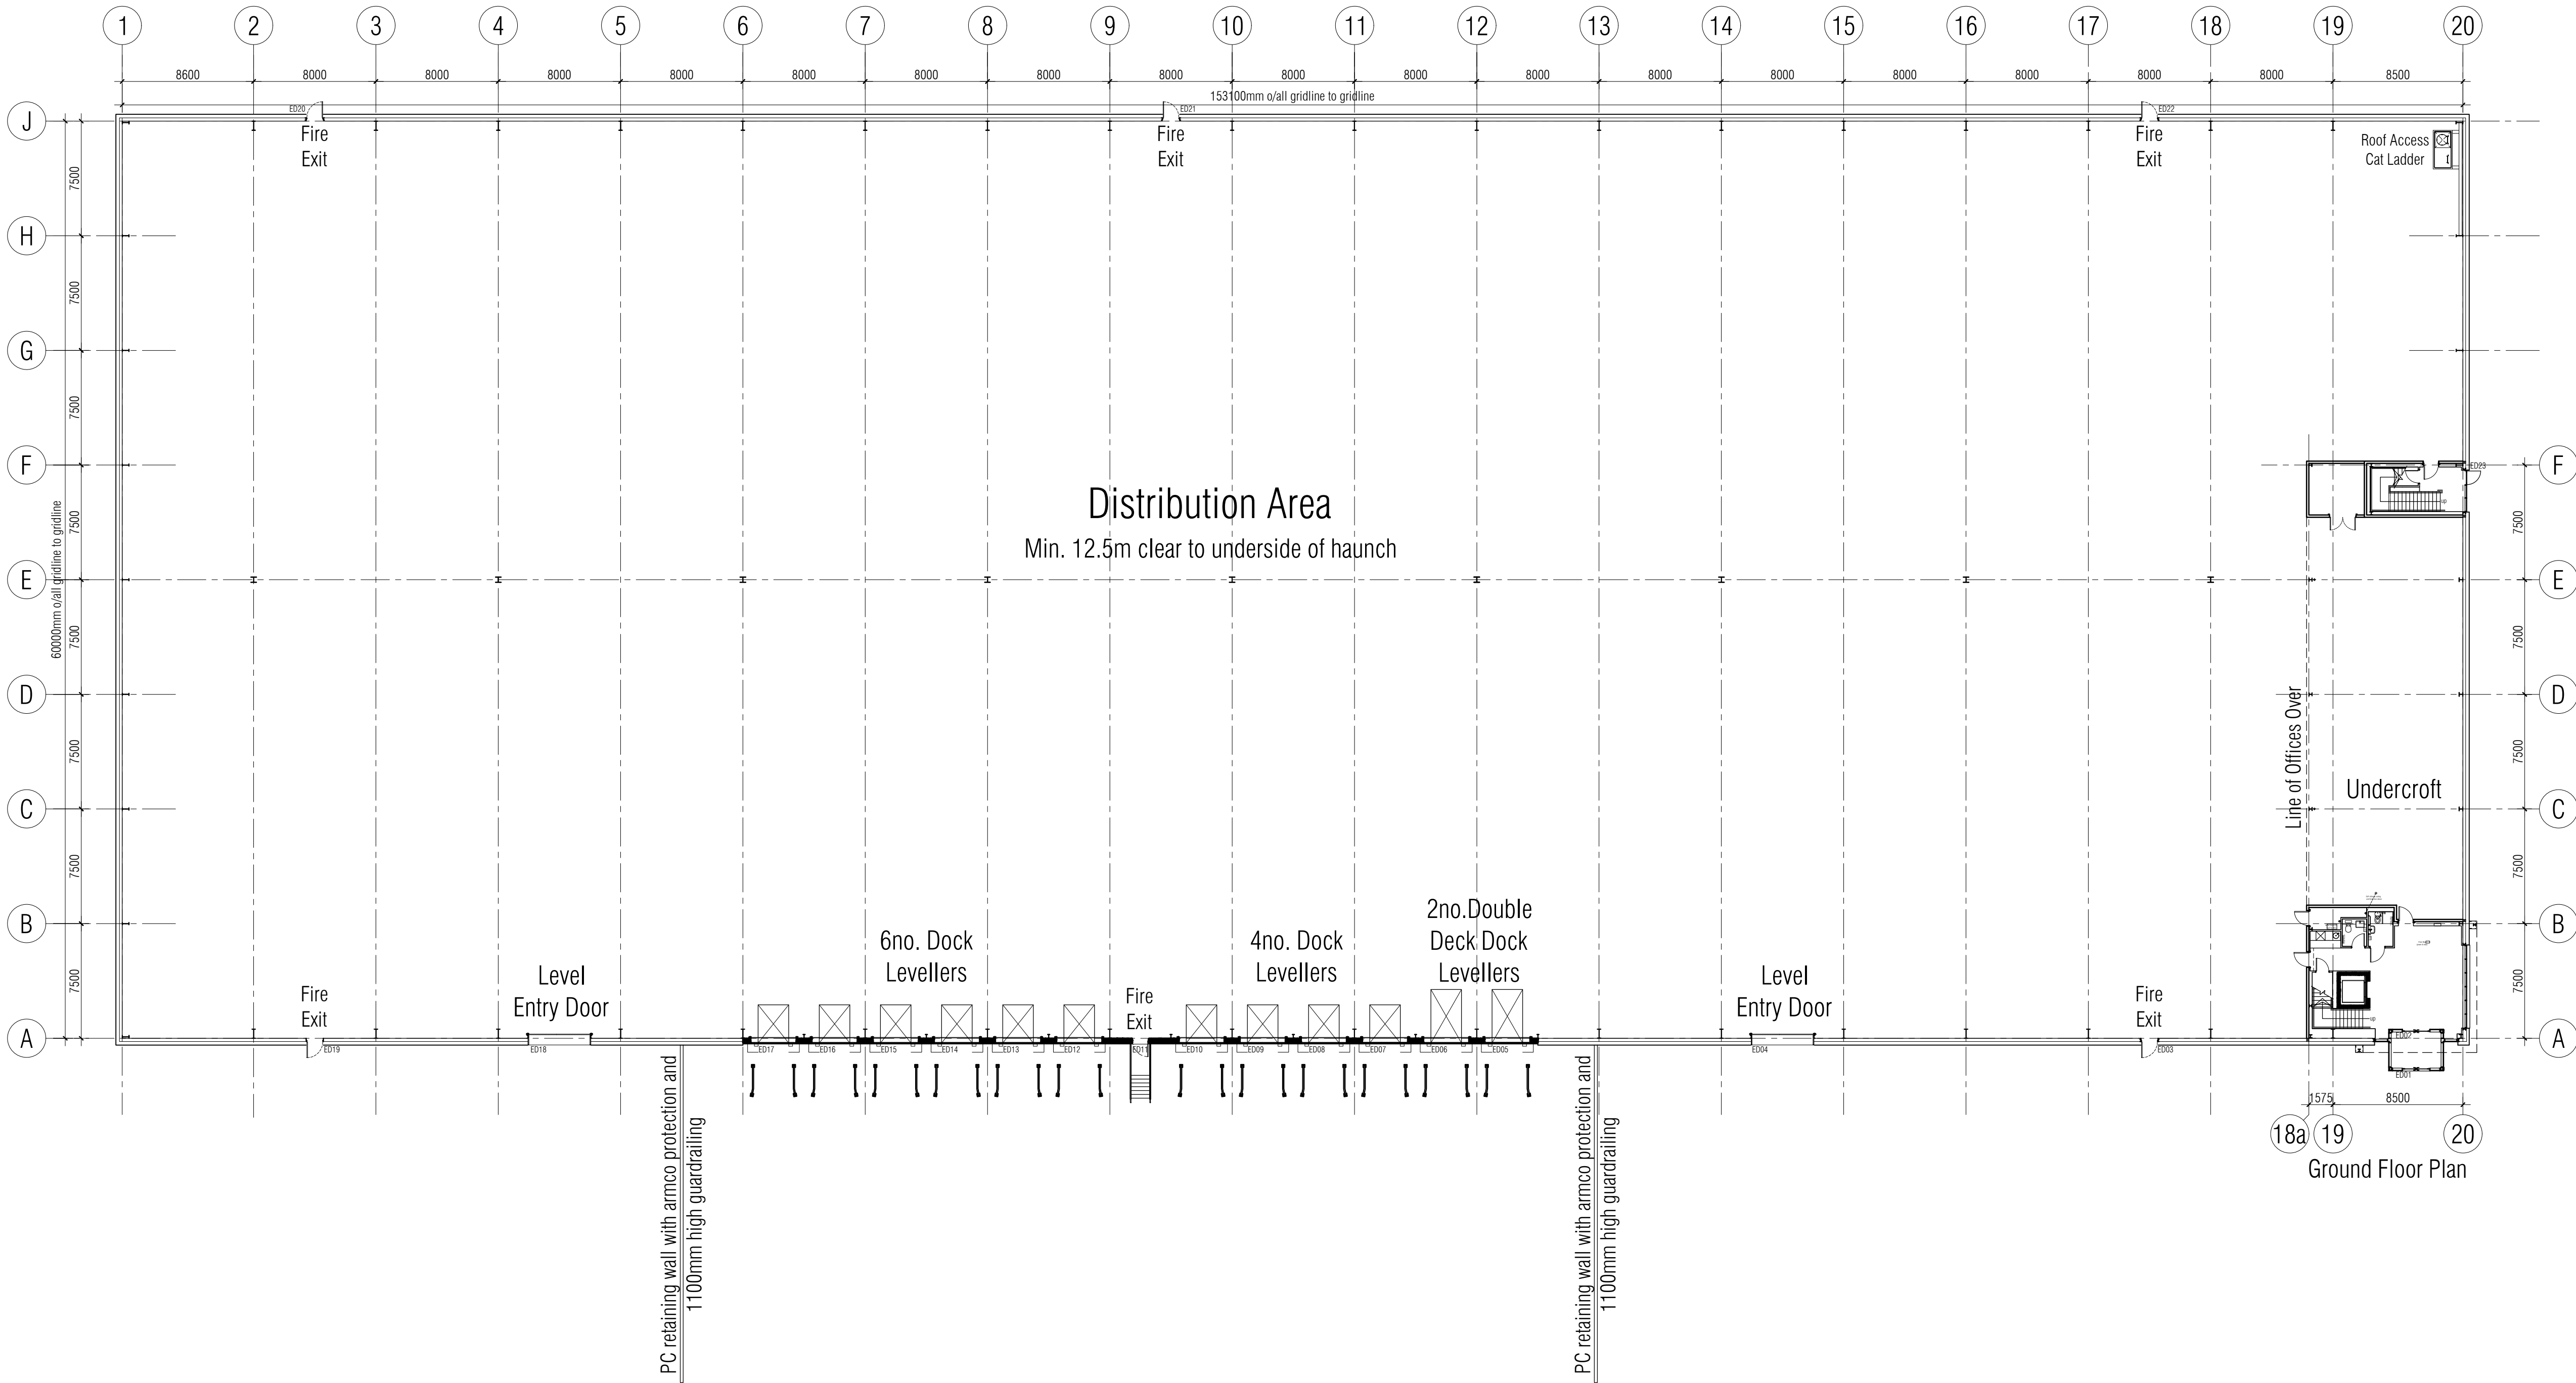

C02 14/02/25	Record Construction Issue	pk
C01 20/11/24	Issued as Construction	KT
P02 14/10/24	Steelwork updated to suit sub-cons drawings	KT
P01 16/07/24	Preliminary Issue	KT
no.	date	revision
		by



aja architects
1170 Elliott Court
Herald Avenue
Coventry Business Park
COVENTRY CV5 6UB
T: 024 7625 3200
E: aja@aja-architects.com
W: www.aja-architects.com

AJA Architects is the trading style of AJA Architects Consulting Limited (a limited company no. 10692793) and AJA Architects LLP (a limited liability partnership registered in England No. OC388721).

client

OREP MK Property Ltd

project

Old Wolverton Road
Milton Keynes

drawing

GA Building Plan

scale	1:250 @ A1	drawn	up
checked	mjl	date	10/11/23

no

7268 - 115 Rev C02

RECORD CONSTRUCTION