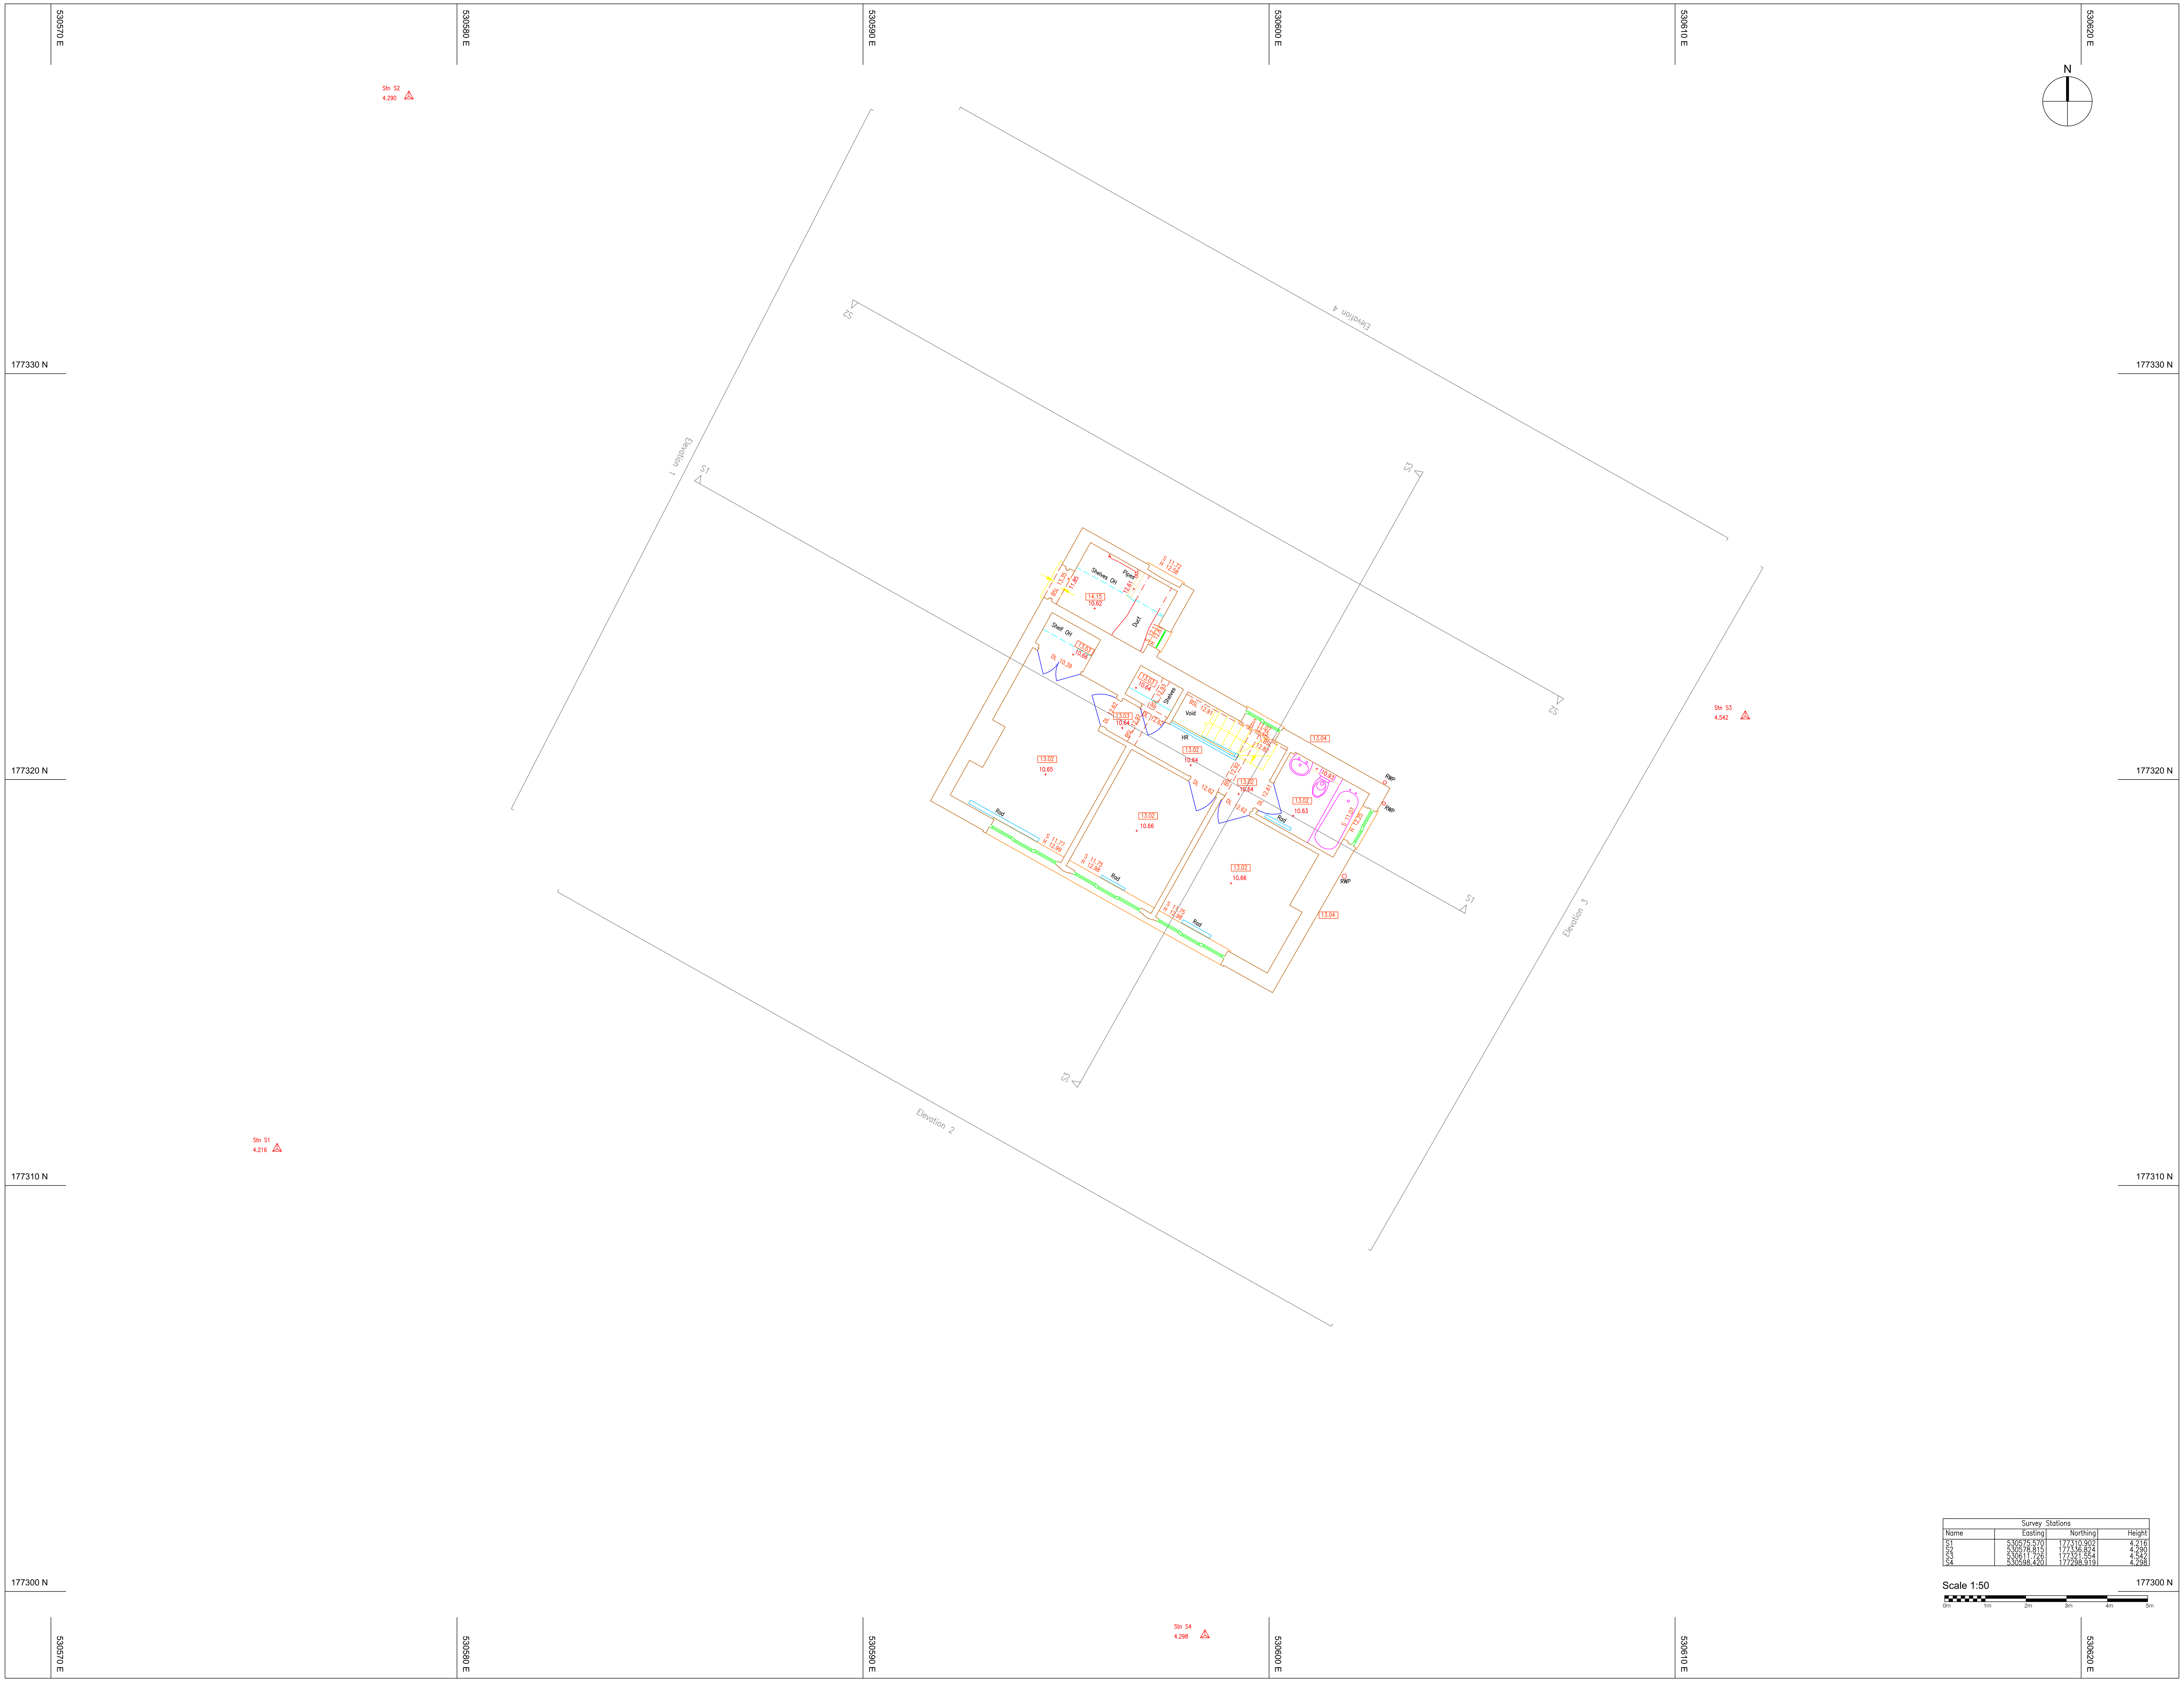

Survey Stations			
Name	Easting	Northing	Height
S1	530575.570	177310.902	4.216
S2	530578.815	177336.824	4.290
S3	530611.726	177321.554	4.542
S4	530598.420	177298.919	4.298

ABBREVIATIONS

A/C	Air Conditioner	LB	Litter Bin
AH	Arch Height	LP	Lamp Post
AL	Arch Level	LS/OW	Light Switch One Way
ASH	Arch Spring Height	LS/TW	Light Switch Two Way
ASL	Arch Spring Level	MD	Infra Red Movement Detector
B	Bollard	Max	Maximum
BGP	Break Glass Point	MH	Manhole
BH	Beam Height	Min	Minimum
Br	Brick	N/A	Not Available
BRW	Brick Retaining Wall	OH	Overhead
BSL	Beam Soffit Level	OSBM	Ordnance Survey
BT	British Telecom	P	Post
BW	Brick Wall	PB	Pillar Box
CBF	Closed Boarded Fence	PLt	Pavement Light
CCTV	Closed Circuit Television	PS	Paving Stones
Chy	Chimney	Rad	Radiator
CL	Cover Level	RDM	Recessed Door Mat
CLF	Chain Link Fence	RE	Rodding Eye
Col	Column	RS	Road Sign
Conc	Concrete	RSJ	Rolled Steel Joist
CPS	Concrete Paving Slabs	RWP	Rain Water Pipe
CT	Cable Tray	s	Spread (Diameter)
CTV	Cable Television IC	S	Window Sill Level/Height
Cup	Cupboard	SBM	Site Bench Mark
DO	Data Outlet	SC	Stop Cock
DP	Down Pipe	SD	Smoke Detector
DrC	Drainage Channel	SH	Spring Height
DS	13A Twin Socket Not Switched	SL	Sump Level
DS/S	13A Twin Socket Switched	Slt	Skylight
EIC	Electrical Inspection Cover	SO	Smoke Outlet
EJB	Electrical Junction Box	SP	Sign Post
EL	Emergency Light	SpO	Spur Outlet
EM	Electricity Meter	Sp	Speaker
ER	Earthing Road	Spr	Sprinkler
ESG	Electrical Switchgear	SS	13A Single Socket Not Switched
FA	Fire Alarm	SS/S	13A Single Socket Switched
FB	Flower Bed	SeS	Security Sensor
FE	Fire Extinguisher	SV	Stop Valve
FHR	Fire Hose Reel	T	Telephone
FL	Floor Level	Tac	Tactile Paving
Flt	Floodlight	TBM	Temporary Bench Mark
g	Girth (Circumference)	TCB	Telephone Call Box
G	Gully	TIC	Telephone Inspection Cover
GC	Gas Cock	TJB	Telephone Junction Box
GM	Gas Meter	TL	Traffic Light
GV	Gas Valve	TLCB	Traffic Light Control Box
H	Window Head Level/Height	TLIC	Traffic Light Inspection Cover
h	Height	TO	Telephone Outlet
HB	Hand Basin	TP	Telephone Pole
HR	Hand Rail	TV	TV Outlet
IC	Inspection Cover	Typ	Typical
IL	Invert Level	U	Unknown
IRF	Iron Railing Fence	V	Vent
IRS	Illuminated Road Sign	VP	Vent Pipe
JB	Junction Box	WH	Water Heater
L	Light	WM	Water Meter
L/DS	Light/Dimmer Switch	WV	Water Valve

SURVEY CAVEATS

The survey is commensurate with band D accuracy, as specified in the RICS survey detail accuracy banding table.
All levels are above OS Newlyn Datum and the survey grid shown on the drawing in only referenced to OS National Grid at the following point: 530591.133E, 177317.050N, obtained by multiple network RTK GPS observations.
Drawing units are metres.
All quoted dimensions and levels are in metres.

Rev	Date	By	Details

MBS SYMBOLS

51.80	Ceiling Level	1.80	Ceiling Height
F52.30	False Ceiling Level	F2.30	False Ceiling Height
BSL 60.00	Beam Soffit Level	BH 2.30	Beam Soffit Height
S 50.80	Sill Level	S 0.80	Sill Height
H 52.40	Head Level	H 1.60	Head Height
Min 56.50 Max 57.00	Ceiling Sloping Level	Min 1.50 Max 2.00	Ceiling Sloping Height
ASL 52.00 AL 52.30	Arch Levels	ASH 2.00 AH 2.30	Arch Heights
DL 52.00	Door Level	DH 2.00	Door Height
+ 50.00	Spot Level	h 0.90	Feature Height
21.37 ▼	Spot Level Elevation		Roof Arrows Point Down
	Stair/Step Arrows Point Up		Stair Cutline
	Sloping Ceiling Arrows Point Up		Assumed Position

RED LASER
www.redlaserscanning.co.uk
enquiry@redlaserscanning.co.uk
London Head Office
23 Sussex Street
SW1V 4RR
0207 477 2175

Project
47–49 Dorset Road
London
SW8 1EX

Description
Second Floor Plan

Survey Date	Drawing Date
14/07/2025	05/08/2025

Sheet	Scale
A0	1:50

Drawing No.
3753–FP–01–M2–01

Checked	Revision
PS	P01