


Metres
0 20 40
Scale 1:1250

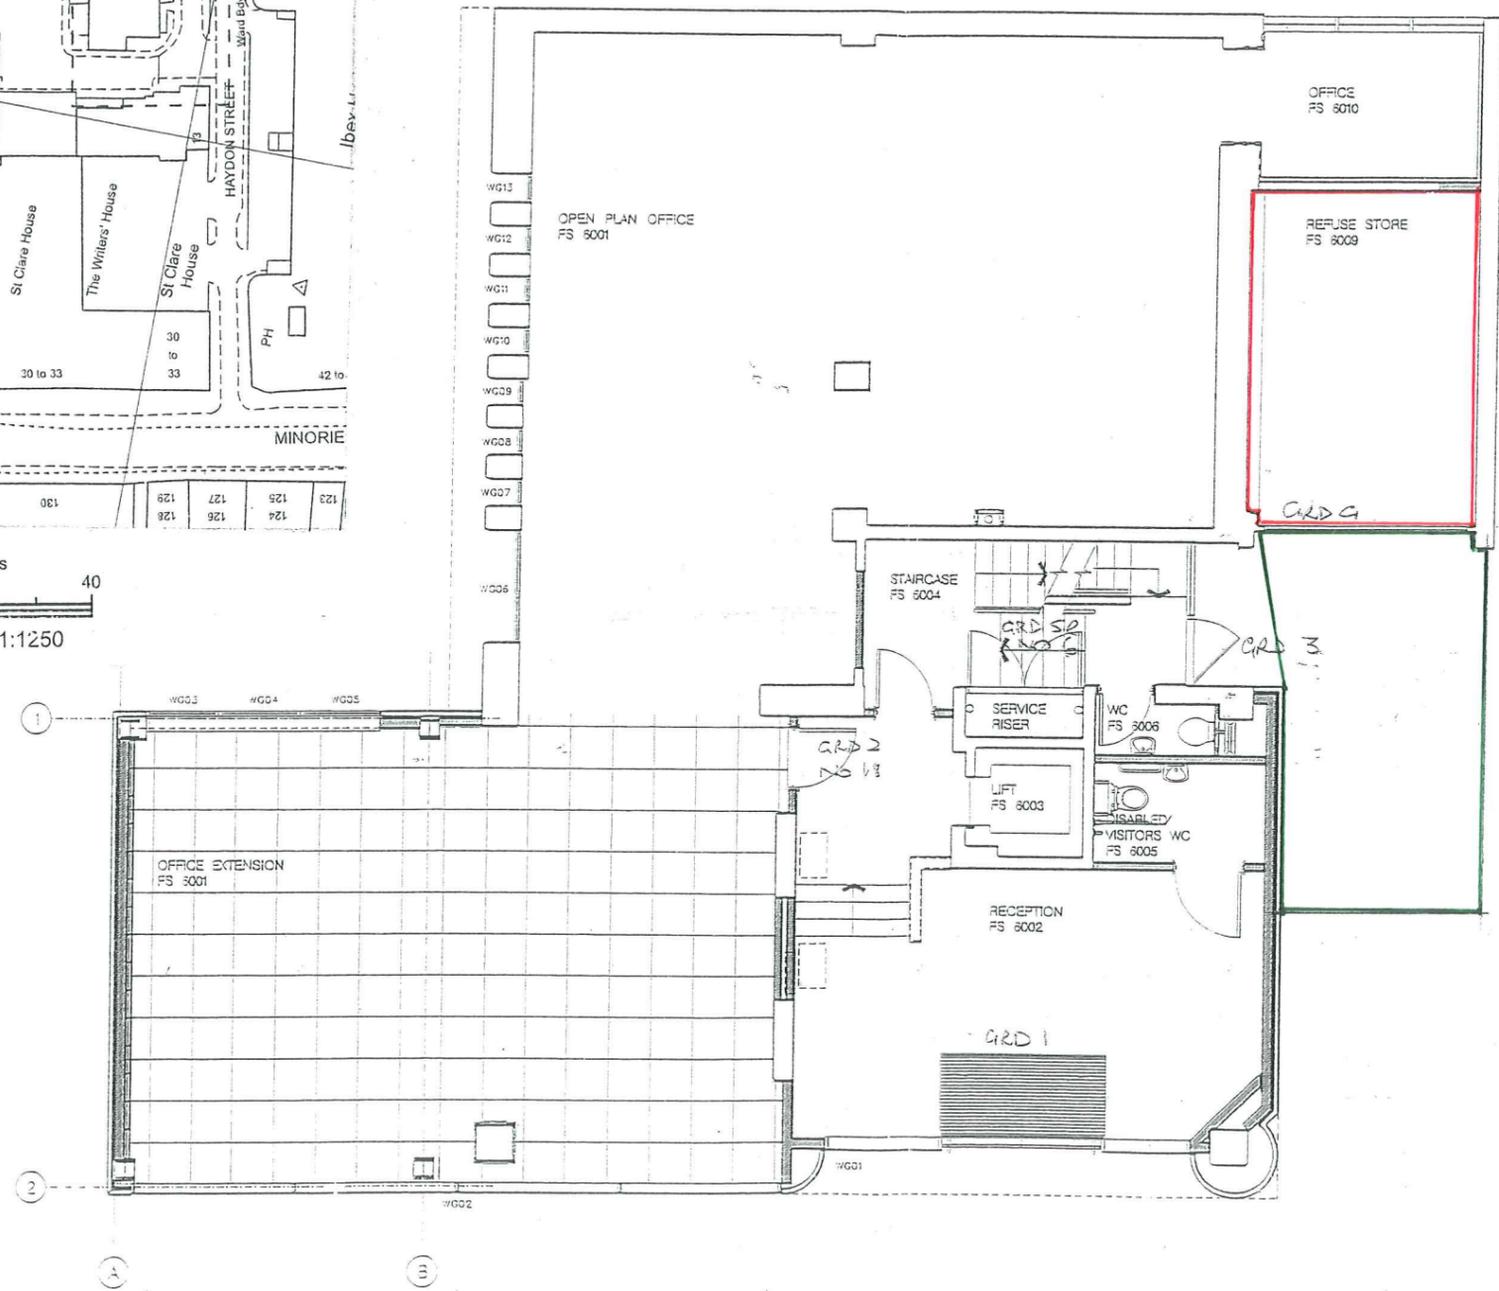

"FOR CONSTRUCTION"

REV 1: DOOR 5003 & BLOCK HBS OMITTED.
 REV 2: REFUSE STORE INDICATED IN LIEU OF GARAGE. MFG 24.06.2001
 REV 3: 1400mm BLOCKWORK CHANGED TO 100mm BLOCKWORK AT
 LOCATIONS 0004, 0005 & 0006. 01.10.2001
 REV 4: DOOR TO 0006 TOILET REPOSITIONED AND INNER BLOCK WALL TO
 EXTERNAL WALL OMITTED. 01.10.2001
 REV 5: 0006 TOILET ADJUSTED TO SUIT SITE CONDITIONS. 01.10.2001
 REV 6: COLLUM TO REAR OFFICE TO BE RETAINED. 01.10.2001
 REV 7: 0005 ROOM COMPLETED AND OFFICE SPACE. 01.10.2001
 REV 8: ENTRANCE & RECEPTION AREA REVISED CURTAIN WALLS &
 WINDOWS HANGING REVEALS HANGING GROUP RELOCATED OFF
 LIVING ADDED TO 0001 & 0002 EXTENSION STEELWORK REPOSITIONED
 WINDOW NUMBERS ADDED (C)

CMC ARCHITECTS
 11 Cannon House, 37-41 Bunhill Street, Cannon Row, London EC3A 3DF
 Telephone: 02022 332222 Fax: 02022 332155
 Email: cma@cmc-arch.com

Client
 LIONRANGE LIMITED

Project
 16-18 ST. CLARE STREET,
 LONDON, EC3.

The
 GROUND FLOOR PLAN.

Scale	Drawn	Date
1:100 @ A3	MPG	12.02.2001
Drawn	MPG	
1:100 @ A3	3	

Client Reference: CANNON HOUSE LTD.
 The Architect's Copyright is the property of the Architect.