


PETER STREET

BOOTLE STREET

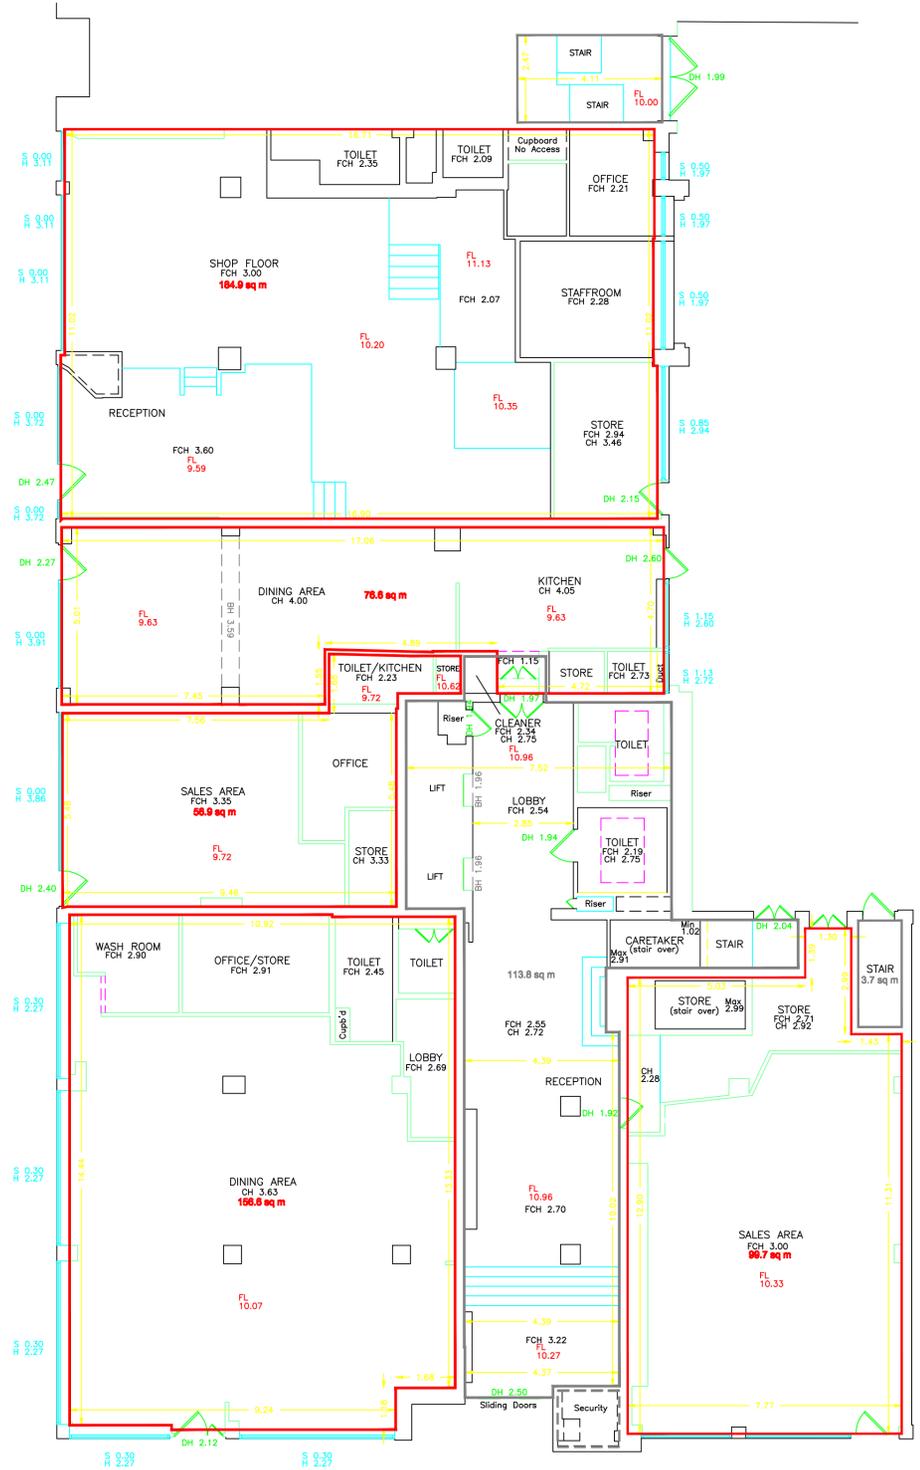

MOUNT STREET

ABBREVIATIONS

AB	Air Brick	DH	Duct Height	PRF	Post & Rail Fence
B	Balford or Bottom Heights	DP	Down Pipe	PWF	Post & Wire Fence
BB	Balustrade	EDB	Electricity Control Box	R	Radiator
BD	Back Drop	ELEC	Electricity	RA	Ramp or Step Rise
BH	Borehole or Beam Height	EP	Electricity Pole	RE	Rodding Eye
BL	Bed Level	FCH	False Ceiling Height	RG	Rough Ground
BP	Brick Paviors	FCL	False Ceiling Level	RS	Road Sign
BR	Brick Retaining Wall	FL	Floor Level	RSL	Roofed Steel Joist
BS	Bus Stop	G	Gully	RWP	Rain Water Pipe
BT	British Telecom	GV	Gas Valve	S	Floor to Window Sill Height
BTB	BT Control Box	H	Height in Metres	SC	Stop Cock
BW	Brick Wall	H	Floor to W Head Height	SL	Skiff Level or Skylight
BWF	Barbed Wire Fence	HT	Height	SP	Arch Springing Height
CONC	Concrete	IC	Inspection Cover	SPS	Stone Paving Slabs
CB	Control Box	IL	Invert Level	SW	Stone Wall
CBF	Close Boarded Fence	IR	Iron Rolling Fence	TCSU	Traffic Control
CSW	Concrete Block Wall	IF	Interweave Fence	T	Top Heights
COB	Cable TV Control Box	KO	Kerb Outlet	TL	Traffic Light
CH	Ceiling Height	L	Light	TP	Telephone Pole
CLF	Chain Link Fence	LP	Lamp Post	TPS	Tactile Paving Slabs
CLSF	Chain Link Security Fence	MH	Manhole	U/L	Unable To Lift
CPF	Concrete Panel Fence	MKR	Marker	V	Vent
CPS	Concrete Paving Slabs	OV	Over Flow Pipe	W	Window
CS	Arch Crown Height	O/H	Overhead	WL	Water Level
CRW	Concrete Retaining Wall	P	Post	WM	Water Meter
CSU	Ceiling Slopes Up	PALF	Palisade Fence	WMF	Wire Mesh Fence
CTV	Cable Television	PF	Picket Fence	WPF	Wooden Panel Fence
CW	Concrete Wall	PIT	Pit	WV	Water Valve
D	Diameter or Doors	PL	Pavement Light	WV	Water Valve
		PM	Parking Meter	Ø	Diameter

NOTES

PLAN GRID IS BASED UPON ARBITRARY GRID
 ALL LEVELS ARE IN METRES BASED UPON ARBITRARY DATUM
 ALL MEASUREMENTS ARE TO TAKEN TO THE WALL FINISH
 AT THE TIME OF SURVEY
 ALL DIMENSIONS ARE IN METRES
 ALL QUOTED AREAS ARE GROSS INTERNAL

LEGEND

All Arrows Point Up, Unless Stated

Issue	Details	By	Chk'd	Date

AREA

GIA XXX sq m

The following areas have been excluded from the above GIA:

Core - Lift, Lobby, Stair & Toilet	116.6 sq m
Rear Fire Escape Stair	10.2 sq m
Basement Stair	3.7 sq m



SURVEYED BY SA	DRAWN BY SA	SCALE 1:100
DATE OF ISSUE DECEMBER 2008	© A1	

THE LEXICON MANCHESTER

GROUND FLOOR GIA PLAN	
DRAWING No. PS-0499-GD	ISSUE 00
SHEET 1 OF 1	

PARAGON SURVEYS
 Chartered Surveyors
 GEOMATICS: Land & Engineering Surveyors

292 Wood Lane
 Heskin, Chorley
 Lancashire
 PR7 5NT
 Tel: (01257) 453200
 Fax: (01257) 453211
 Email: post@ParagonSurveys.co.uk