


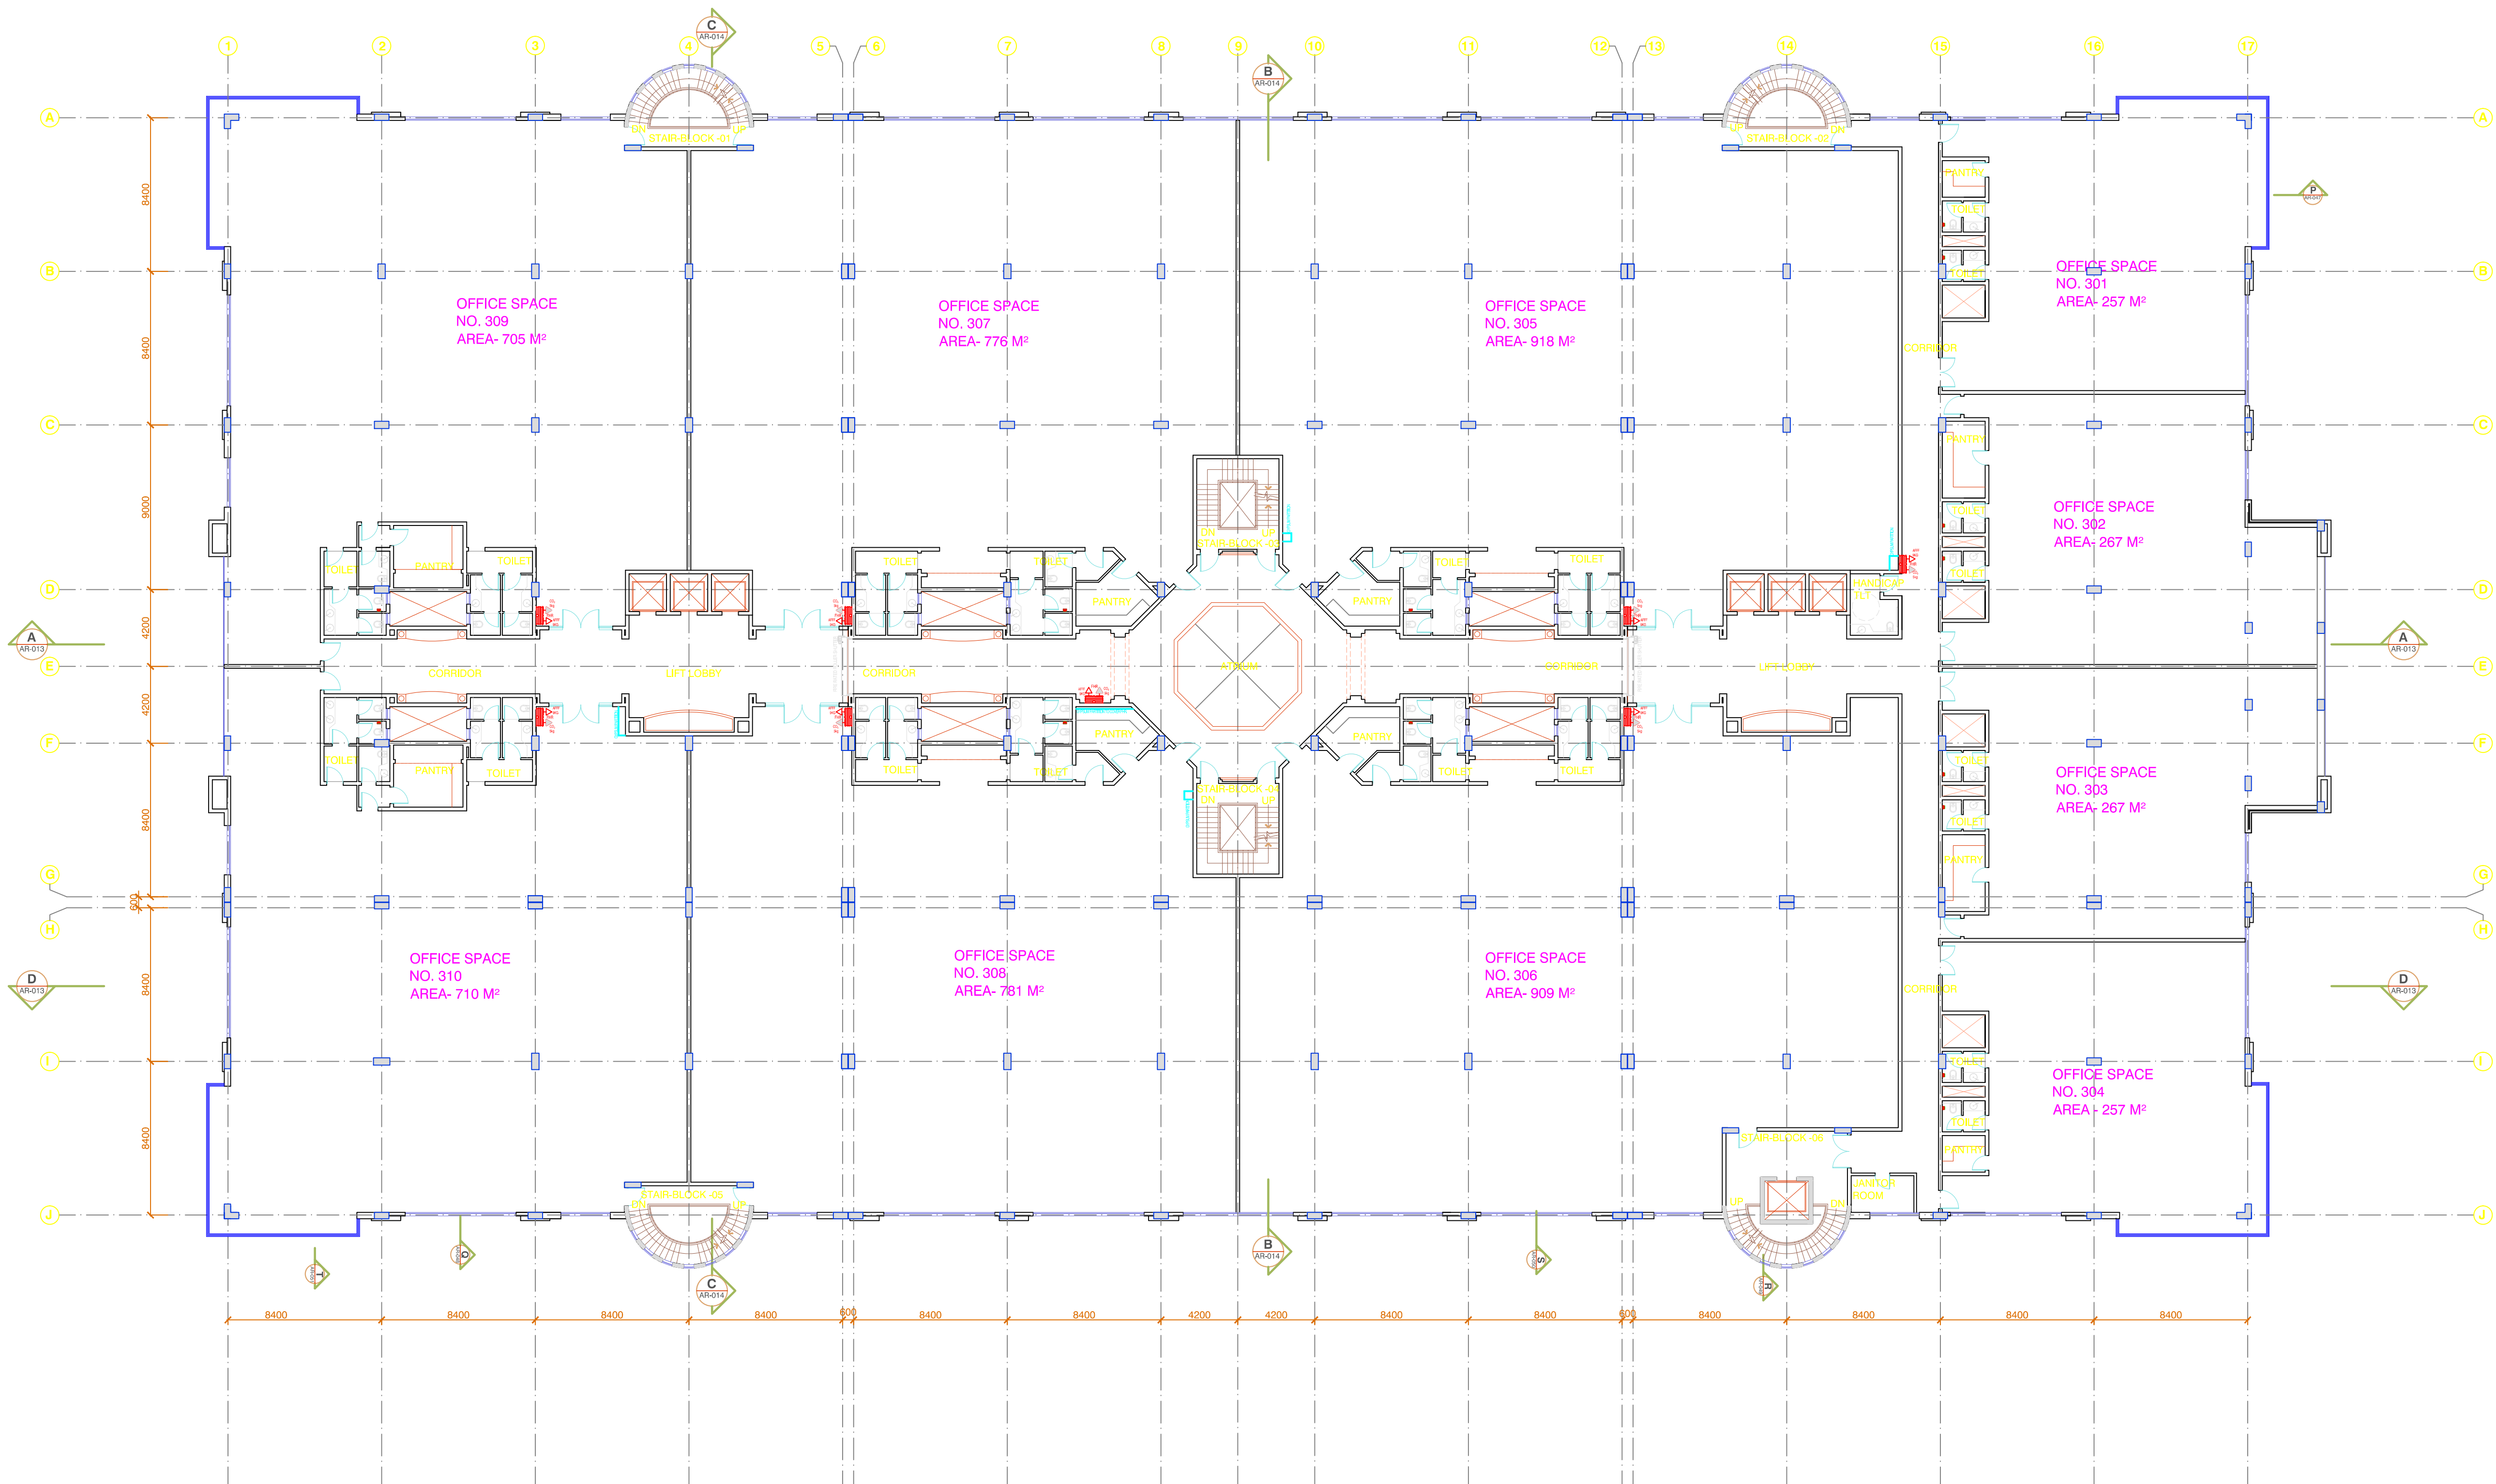

- NOTES:**
1. COPYRIGHT OF THIS DRAWING IS THE PROPERTY OF TRIAD OMAN CONSULTANTS INTERNATIONAL (TOCI). IT MUST NEITHER BE REPRODUCED NOR AMENDED NOR USED FOR THE EXECUTION OF ANY WORKS WITHOUT THE WRITTEN CONSENT OF TOCI.
 2. ALL DIMENSIONS ARE IN MILLIMETRES UNLESS OTHERWISE STATED.
 3. DRAWINGS ARE NOT TO BE SCALED.
 4. ALL DIMENSIONS ARE TO BE VERIFIED PROPERLY AT SITE BEFORE COMMENCING WORKS.
 5. ALL DRAWINGS ARE TO BE READ IN CONJUNCTION WITH ALL OTHER RELEVANT DRAWINGS.
 6. ALL THE ABOVE MENTIONED NOTES ARE APPLICABLE TO ALL ARCHITECTURAL DRAWINGS.
 7. ANY DISCREPANCY IN DRAWINGS TO BE CLARIFIED WITH ARCHITECT BEFORE COMMENCEMENT OF WORKS.

AREAS OF OFFICES ARE DERIVED FROM AUTOCAD

REV. NO.	DATE	DESCRIPTION	BY
R2	30-05-10	REVISED AS SHOWN	AM
R1	30-08-09	FLOOR EXTENT CHANGED, JANITOR ROOM ADDED, OFFICE TOILETS, CENTRAL CORRIDOR REVISED	AM

MUSCAT MUNICIPALITY REGISTRATION No. 2006/

CONSULTANT
ترياد عمان الاستشارات
الهندسية ش.م.م


**TRIAD OMAN CONSULTANTS INTERNATIONAL
ENGINEERING CONSULTANTS L.L.C.**
P.O.Box : 1397, Postal code : 112, Muscat, Sultanate of Oman
Tel : +968 247002509 Fax : +968 24793540 e-mail : mail@tocieng.com

SCALE:
1:200 @A1

DESIGN BY: MKS	DRAWN BY: AMIT	DATE: 28-11-07
CHECKED BY: MKS	APPROVED BY:	

CLIENT
H.E. SAYYID BADR BIN SAUD BIN HAREB AL BUSAIDI

PROJECT NAME
COMMERCIAL COMPLEX AT QURAM

DWG. TITLE:
KEY PLAN - THIRD FLOOR

PROJECT NO.: ON 862	DRAWING NO.: AR-WD-006	REV. NO.: R2
------------------------	---------------------------	-----------------

