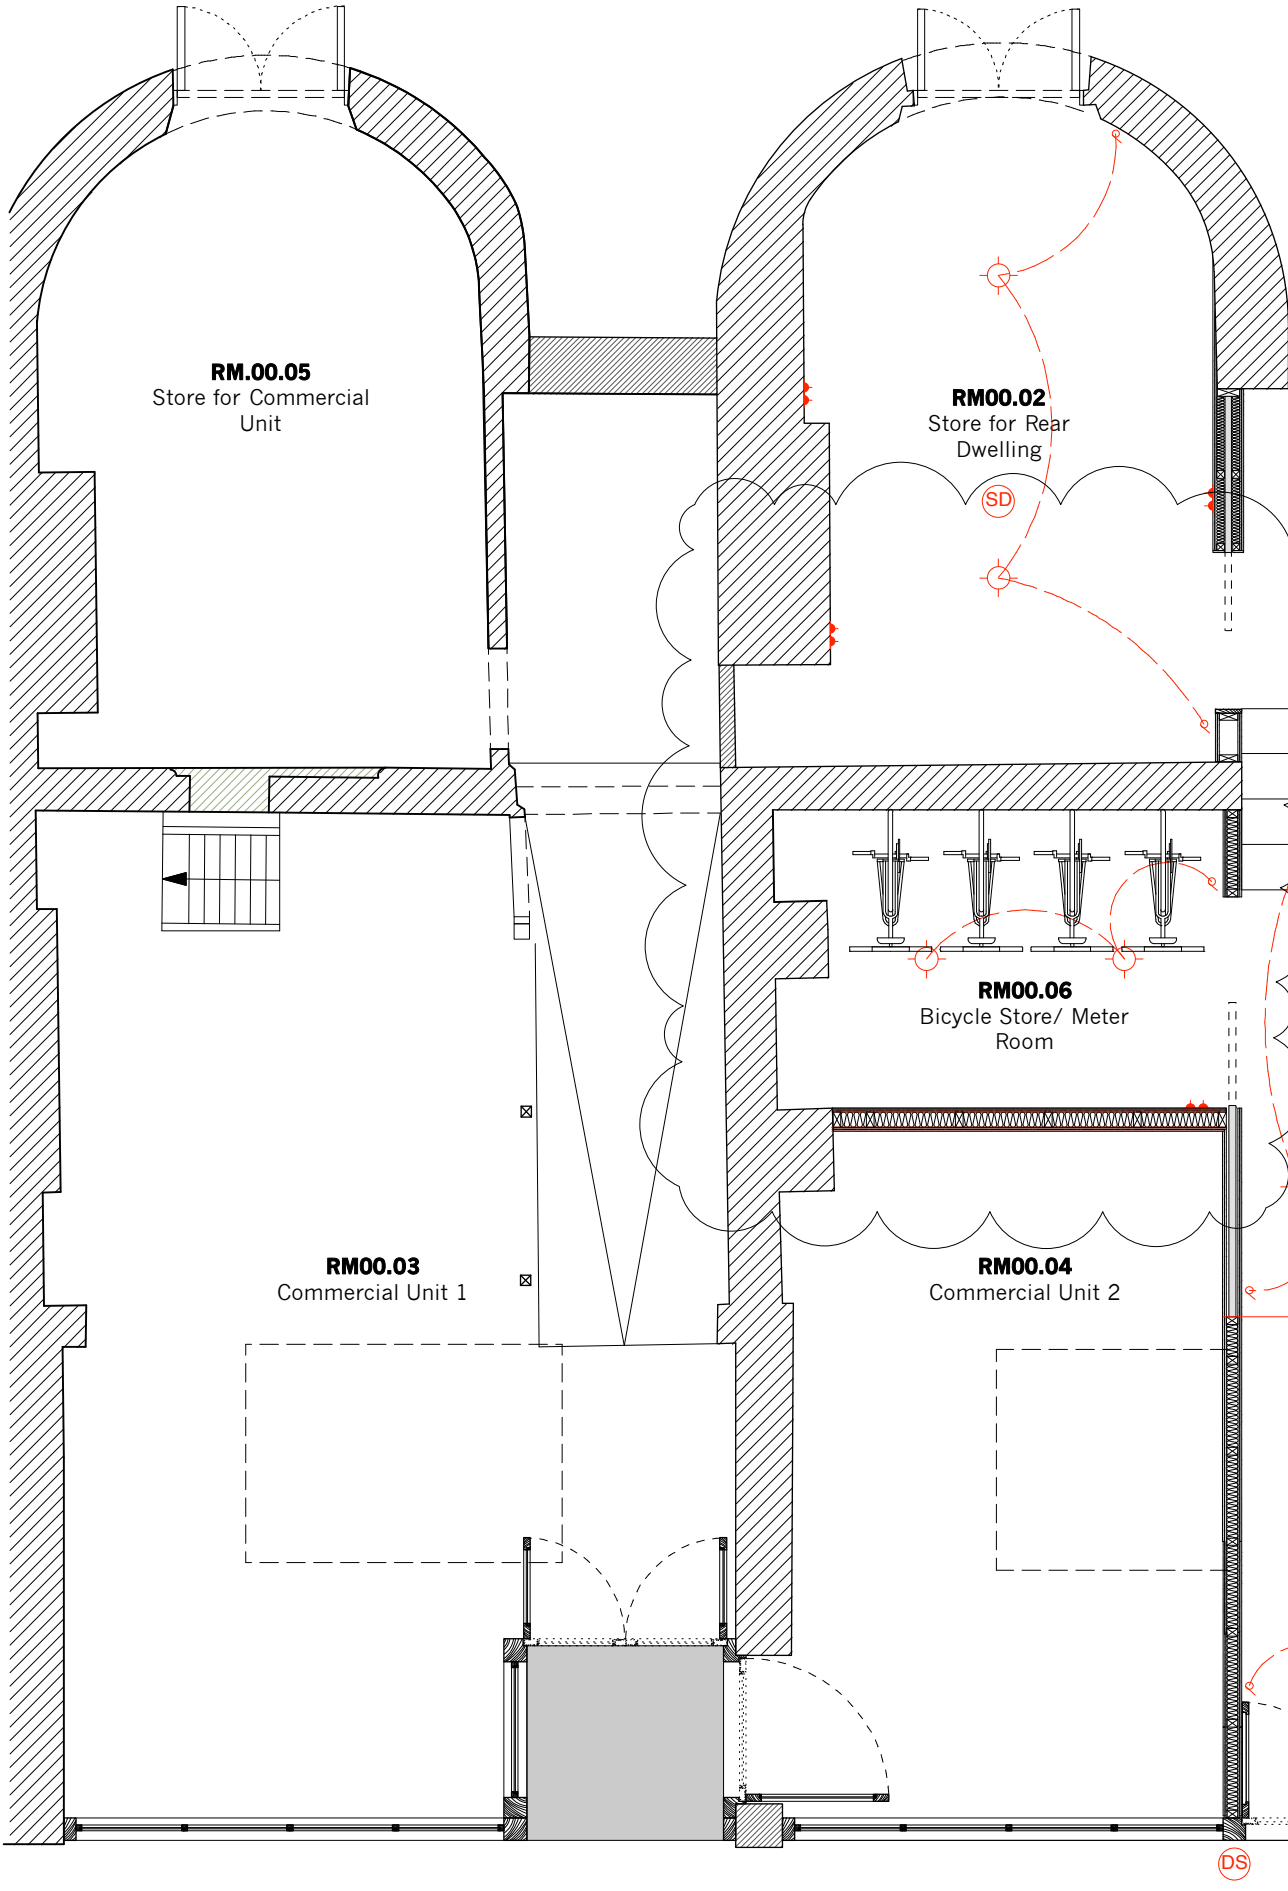
RM.00.05
Store for Commercial Unit
RM00.02
Store for Rear Dwelling
SD
RM00.06
Bicycle Store/ Meter Room
RM00.03
Commercial Unit 1
RM00.04
Commercial Unit 2
DS