INDICATIVE

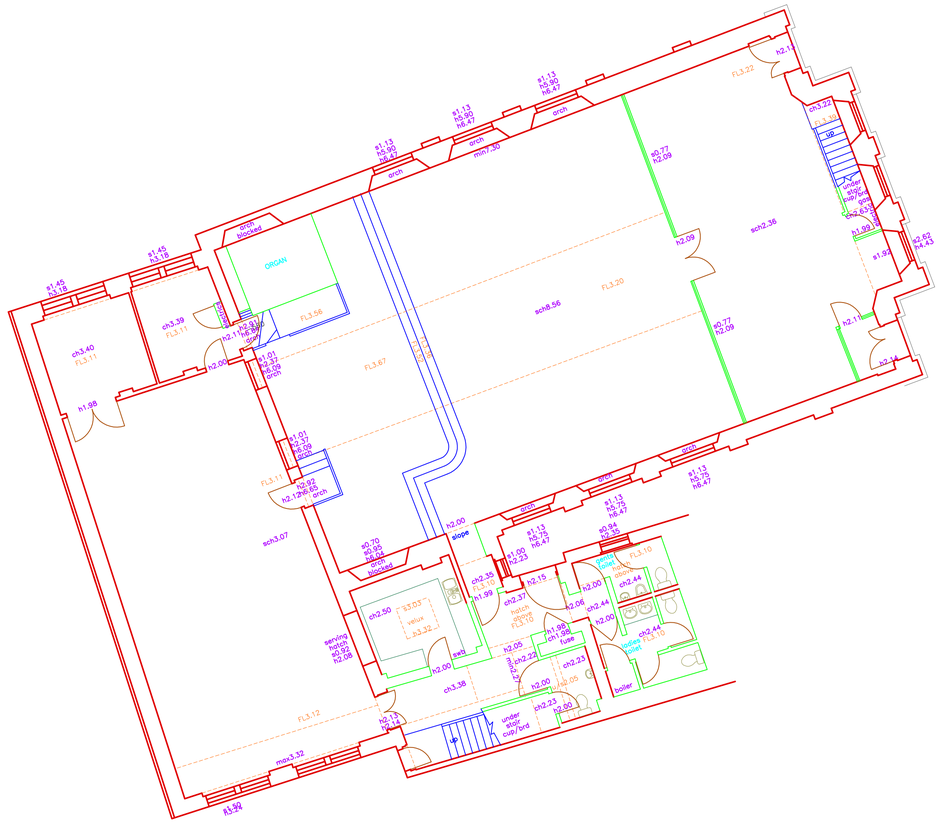

GROUND FLOOR PLAN
GIA 399.7 SQM

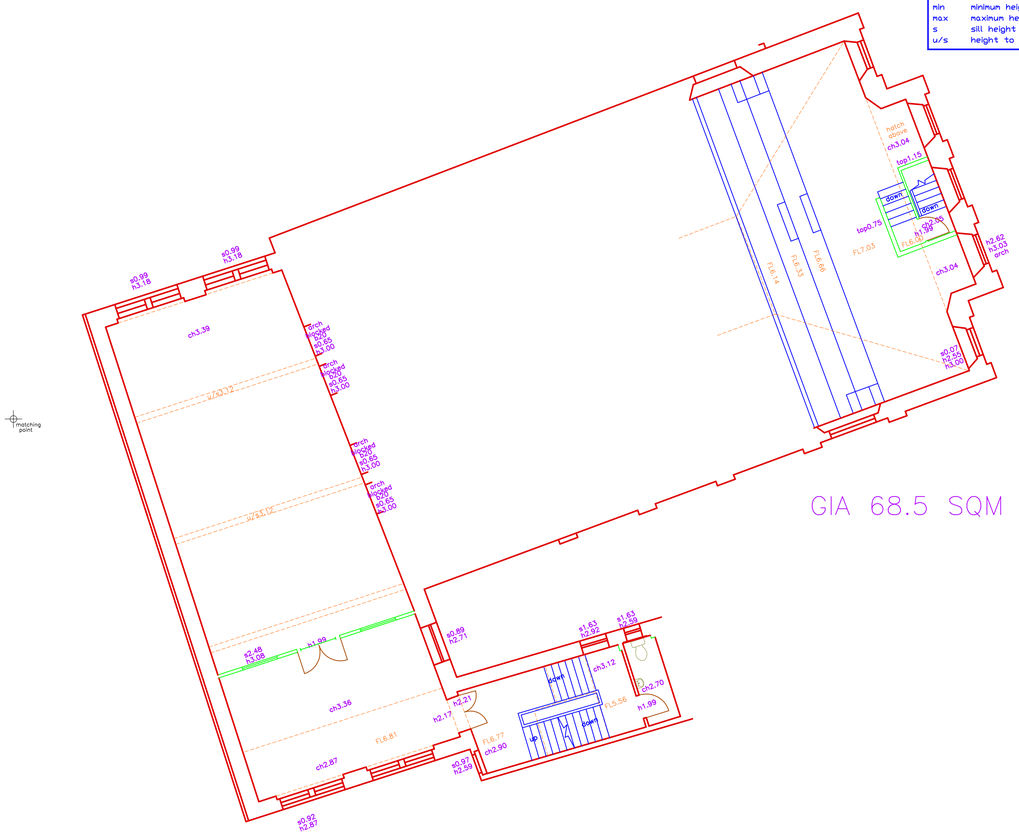

FIRST FLOOR PLAN
GIA 125.1 SQM

GIA 68.5 SQM

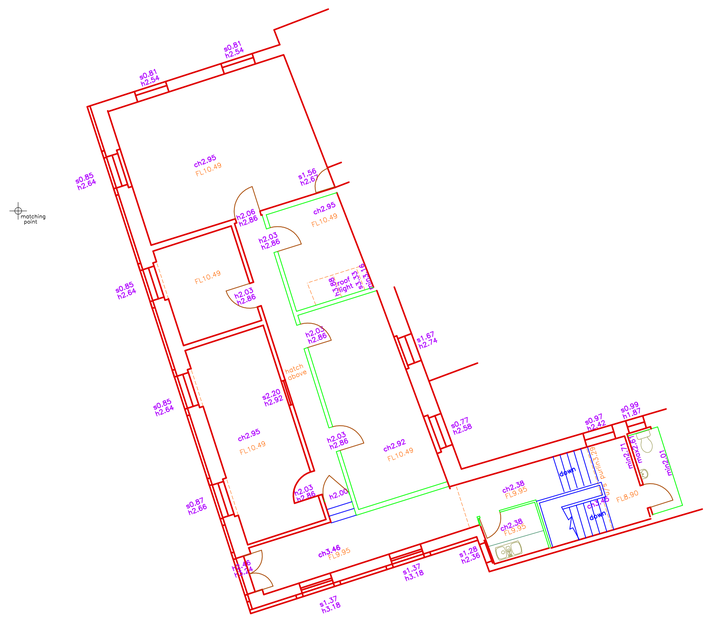
matching point
ch2.95
FL10.49
FL10.49
ch2.95
FL10.49
3.03 roof slope
ch2.95
FL10.49
ch2.92
FL10.49
ch2.38
ch3.46
FL9.95
FL8.90
UP
DOWN
