


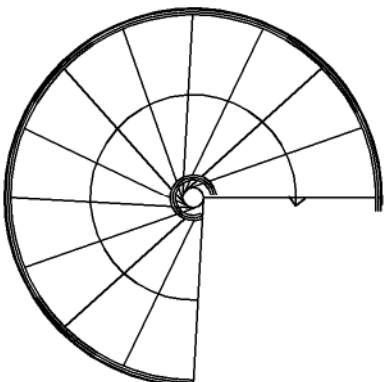

Rev.	Description	Date / Finish
A	ADDED DATA	10.08.15 jpw
B	REVISED TO WATCH GROUP	13.08.15 jpw
	MAKER jpw	

DRAWING STATUS

Rev.	Description	Date / Initial
A	ADDED DATA	10.08.15 JPW
B	REVISED TO WELCH GROUP MARK UP	13.08.15 JPW



The Workplace
Zebra Court
Greenside Way
Manchester
M24 1JN

T 0161 655 0290
F 0161 655 0291
E info@adtlworkplace.com
W www.adtlworkplace.com

Development	KIM JONES	
Project Manager		
Design	Initial	Drawn By
Scale & A1		JPW
Date	1:50	
	02.10.15	
Project	DGS FINANCE	
	HERCULES BUSINESS PARK	
	BIRCHDALE	
	STOCKPORT	
	SK3	

GF AS FITTED DATA LAYOUT