




Ground Floor

 

First Floor

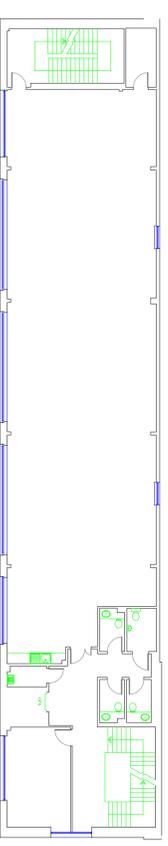

Second Floor

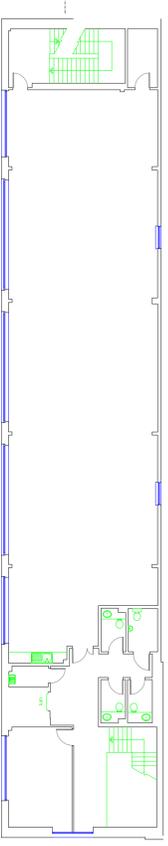

Roof access



Bridge Industrial

Collett Way
Southall
UB2 4SE

Ross Laird


measured surveys
5 Lower King Street
Royston, Herts SG8 5AL
01763 249949
surveys@rosslaird.co.uk
www.rosslaird.co.uk

title: Floor Plans

ref: 3646-01

scale: 1:200 on A1

date: December 2023

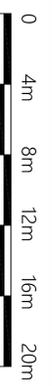

all dimensions taken to face of dry lining or wall cladding if applicable
drawings are not to scale unless otherwise stated
drawings are not to be used for construction purposes
inaccessible areas will be shown using a broken line