A0

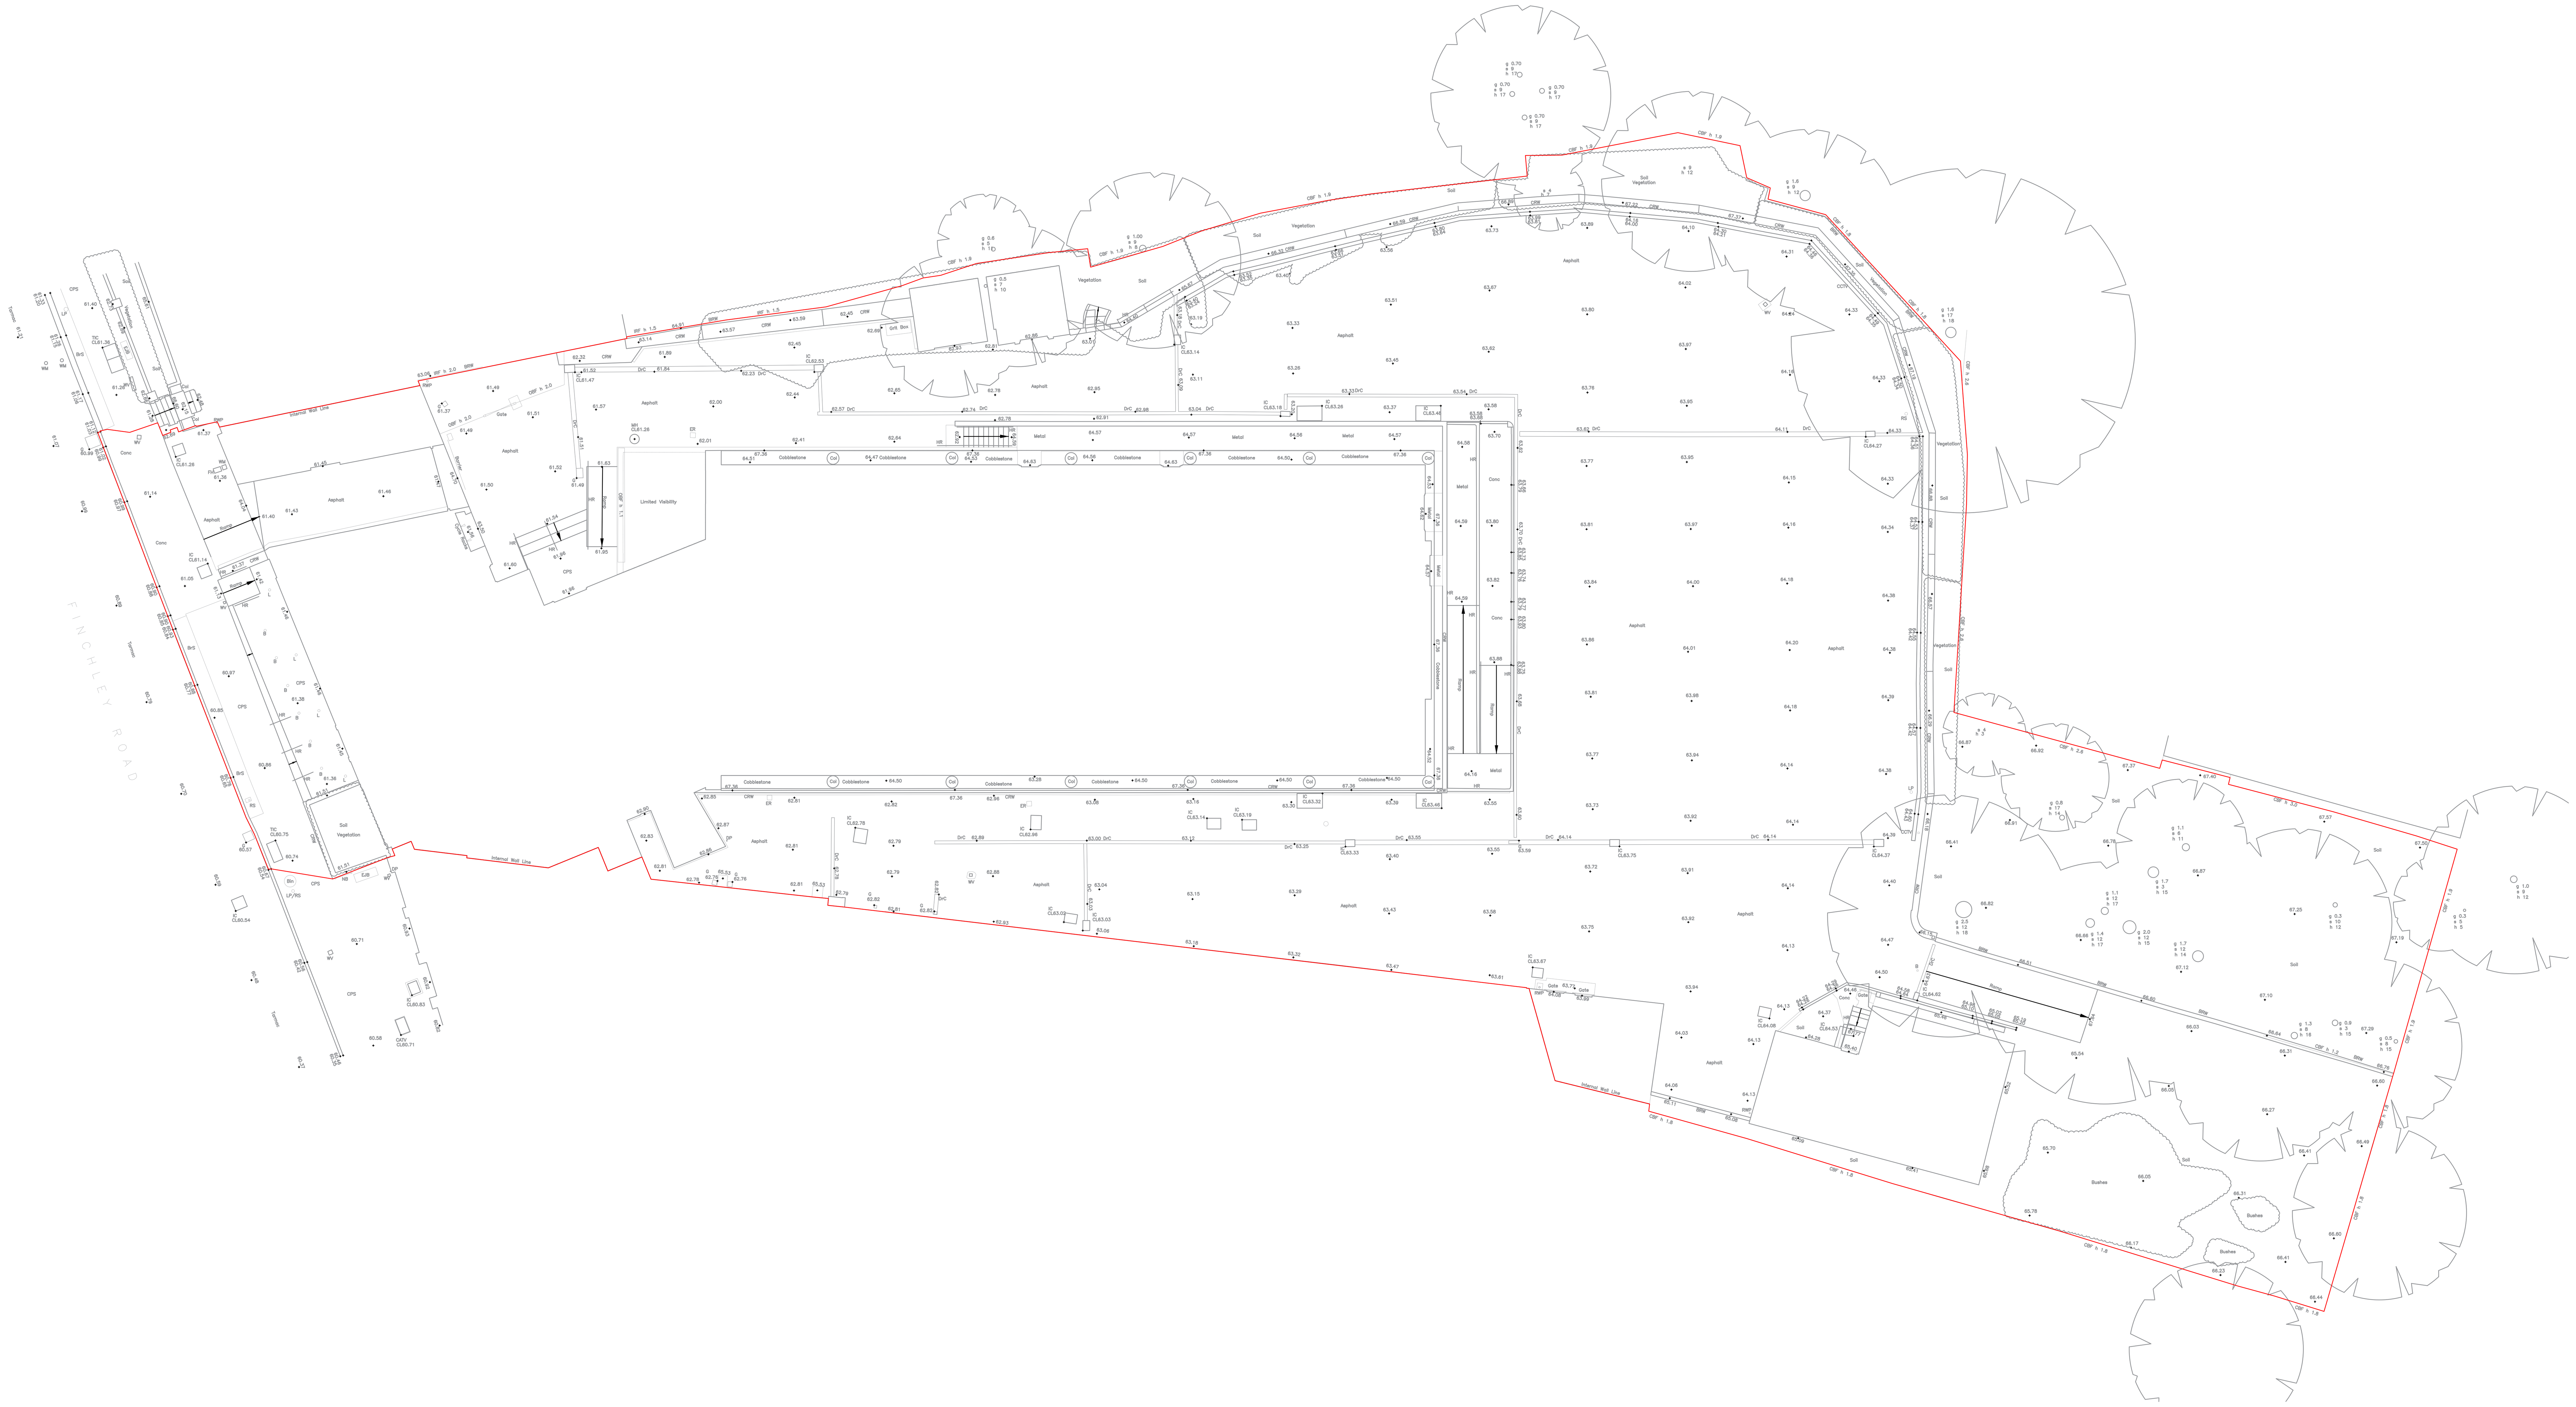

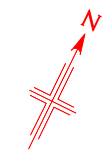

ALL DIMENSIONS, LEVELS AND CLEARANCES TO BE CHECKED ON SITE PRIOR TO WORKS COMMENCING

THIS DRAWING SHOULD BE READ IN CONJUNCTION WITH ALL OTHER PROJECT RELATED DRAWINGS, SPECIFICATIONS AND DOCUMENTS AS PART OF A SINGLE PROJECT PACKAGE.

ANY DISCREPANCY BETWEEN THIS DRAWING, OTHER DRAWINGS FORMING PART OF THIS CONTRACT, OR THE SPECIFICATION / BILLS OF QUANTITIES MUST BE CLARIFIED BEFORE COMMENCEMENT OF ANY WORK OR ORDERING OF ANY MATERIALS.

PLEASE CONSULT THE AUTHOR OR PROJECT MANAGER SHOULD THE READER REQUIRE CLARIFICATION ON ANY PART OF THIS DRAWING.

THE COPYRIGHT OF THE DRAWING AND DESIGN IS THE PROPERTY OF THE COMPANY. THIS INFORMATION HAS BEEN ISSUED UNDER SPECIFIC TERMS FOR THIS PROJECT AND MAY ONLY BE USED AND REPRODUCED ACCORDINGLY.

NOTES

STANDARD ABBREVIATIONS

A/C	Air Conditioner	IRF	Iron Railing Fence
AH	Arch Height	IRS	Illuminated Road Sign
AL	Arch Level	JB	Junction Box
ASH	Arch Spring Height	L	Light
ASL	Arch Spring Level	LB	Litter Bin
B	Bollard	LP	Lamp Post
BGP	Break Glass Point	Max	Maximum
BH	Beam Height	MH	Manhole
Br	Brick	Min	Minimum
BRW	Brick Retaining Wall	O/H	Overhead
BSL	Beam Soffit Level	OSBM	Ordnance Survey Bench Mark
BT	British Telecom	P	Post
BW	Brick Wall	PB	Pillar Box
CBF	Close Boarded Fence	PLt	Pavement Light
CCTV	Closed Circuit Television	PS	Paving Stones
Chy	Chimney	Rad	Radiator
CL	Cover Level	RDM	Recessed Door Mat
CLF	Chain Link Fence	RE	Rodding Eye
Col	Column	RS	Road Sign
Conc	Concrete	RSJ	Rolled Steel Joist
CPS	Concrete Paving Slabs	RWP	Rain Water Pipe
CTV	Cable Television IC	s	spread
Cup	Cupboard	S	Window Sill Level/Height
DP	Down Pipe	SBM	Site Bench Mark
DrC	Drainage Channel	SC	Stop Cock
EIC	Electrical Inspection Cover	SH	Spring Height
EJB	Electrical Junction Box	SL	Sump Level
EM	Electricity Meter	Slt	Skylight
ER	Earthing Rod	SO	Smoke Outlet
ESG	Electrical Switchgear	SP	Sign Post
FA	Fire Alarm	SS	Security Sensor
FB	Flower Bed	SV	Stop Valve
FE	Fire Extinguisher	T	Telephone
FH	Fire Hydrant	Tac	Tactile Paving
FHR	Fire Hose Reel	TBM	Temporary Bench Mark
FL	Floor Level	TCB	Telephone Call Box
Flt	Floodlight	TIC	Telephone Inspection Cover
g	girth	TJB	Telephone Junction Box
G	Gully	TL	Traffic Light
GC	Gas Cock	TLCB	Traffic Light Control Box
GM	Gas Meter	TLIC	Traffic Light Inspection Cover
GV	Gas Valve	TP	Telephone Pole
H	Window Head Height/Level	Typ	Typical
h	height	V	Vent
HB	Hand Basin	VP	Vent Pipe
HR	Handrail	WH	Water Heater
IC	Inspection Cover	WM	Water Meter
IL	Invert Level	WV	Water Valve

Rev	Date	By	Chk	Apr	Comment
R01	26/08/25	CV	GO	NC	Final Issue

Lane & Frankham

info@laneandfrankham.com
www.laneandfrankham.com

The Independent Measurement Choice

SIDCUP OFFICE
Irene House
Five Arches Business Park
Maidstone Road
Sidcup, Kent DA14 5AE
T: 020 8309 7777

OXFORD OFFICE
Citibase Oxford
New Barclay House
234 Botley Road
Oxford OX2 0HP
T: 01865 322500

LONDON OFFICE
First Floor
Bridge House
181 Queen Victoria Street
London EC4V 4EG
T: 020 7651 0790

STEVENAGE OFFICE
Suite 237, Second Floor
Kings Court Business Centre
London Road, Stevenage
Hertfordshire SG1 2NG
T:020 3714 7063

Client:

Dutch & Dutch

Project Title:

202 Finchley Road
Hampstead
NW3 6BX

Drawing Title:

Boundary Plan

Status:

RECORD

Drawn By:	Designed By:	Checked By:	Approved By:
CV	CV	GO	NC

Original Issue Date:	Scale @ A0:
28/08/2025	1:150

Job No/ File Ref	Originator	Zone	Level
LF6552	LAF	XX	ST

Type	Discipline	Number	Suitability	Revision
DR	G	1001	S2	R03