


NOTES
ALL DIMENSIONS ARE IN MILLIMETERS UNLESS NOTED OTHERWISE.
ALL LEVELS ARE IN METERS UNLESS NOTED OTHERWISE.
ANY DISCREPANCY TO BE BROUGHT TO THE NOTICE OF CONSULTANT
PRIOR TO COMMENCEMENT OF WORK

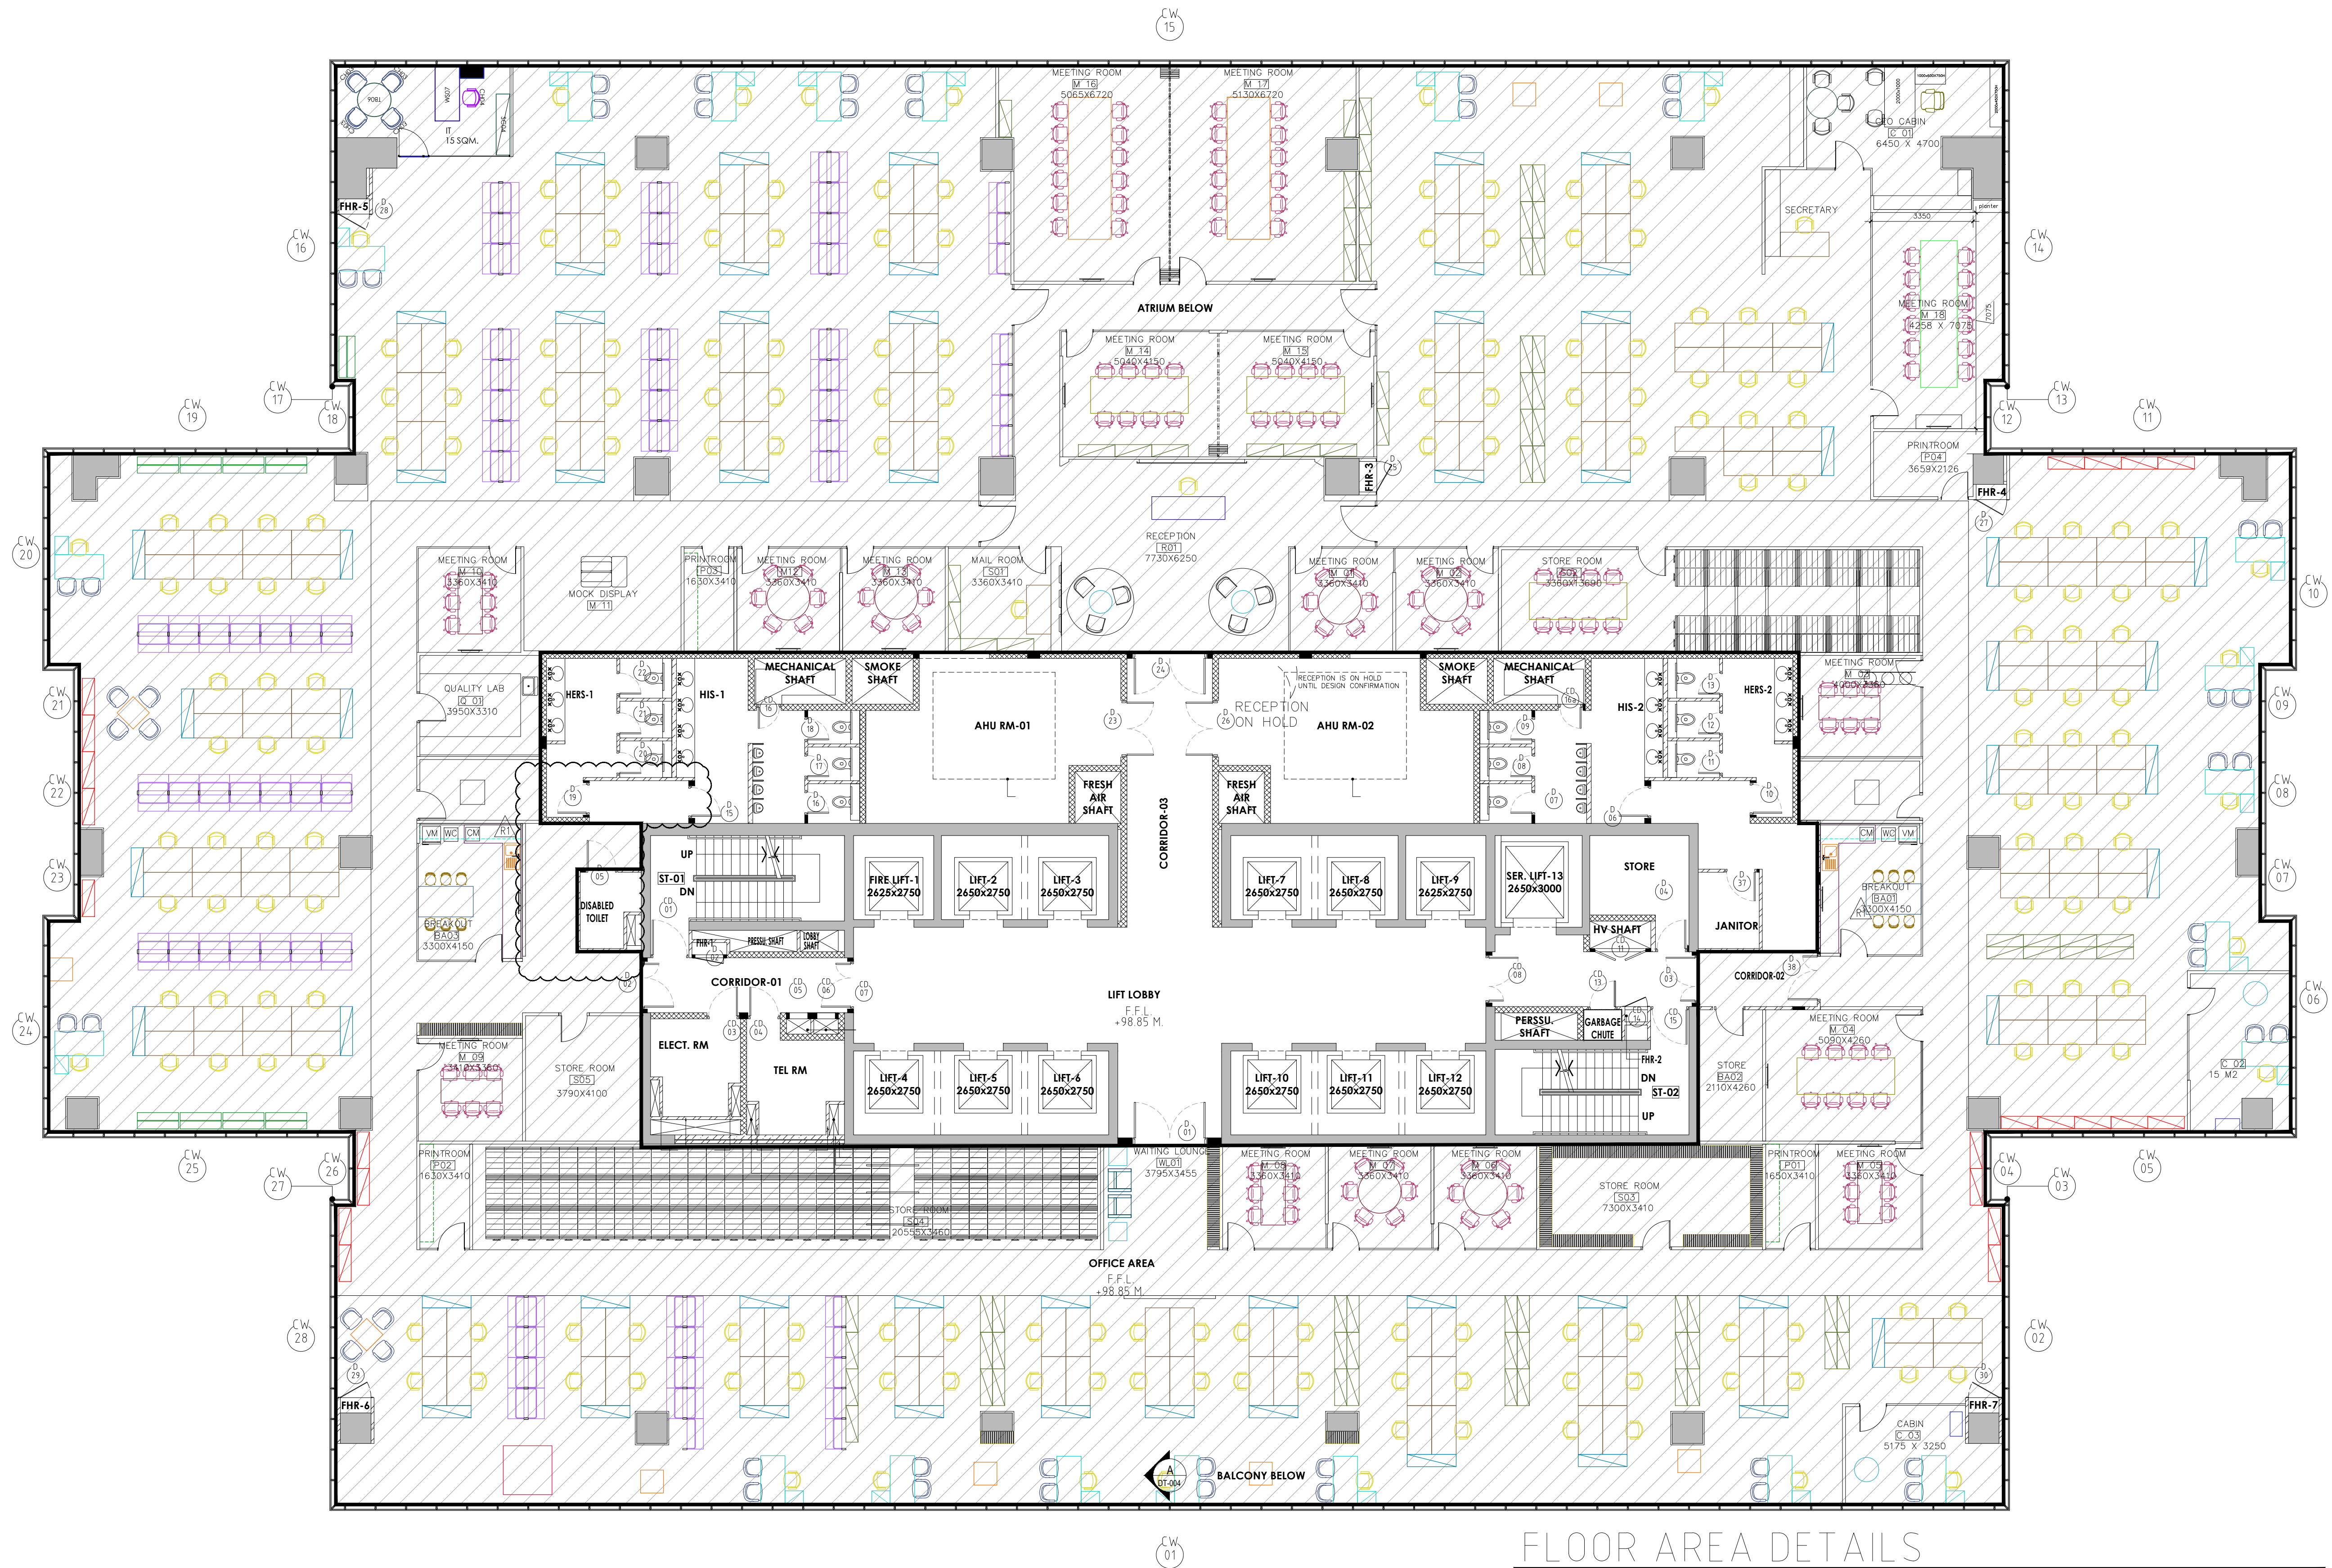

FLOOR AREA DETAILS

	DESCRIPTION	AREA IN M2	AREA IN SQFT.
1.	TOTAL FLOOR AREA	2,966.07	31,915.0
2.	COMMON AREA	613.38	6,600.0
3.	BABY SHOP	2,352.69	25,315.0
4.			

REVISION AS MARKED	10	10/25/23
PURPOSE OF ISSUE	REV.	DATE

CLIENT

LANDMARK ASSET HOLDING LIMITED



P.O. BOX 25000, DUBAI - U.A.E
TEL: 04 - 8044000, FAX: 04 - 8044211

PROJECT NAME:

**3B + GR + 7P + 19 STOREY OFFICE BUILDING
ON PLOT D-001-004 @ TECOM, DUBAI**

DRAWING TITLE:

**25th LEVEL (BABYSHOP)
FURNITURE LAYOUT**

SCALE:	DRAWN:	CHECKED:	APPROVED:	SIZE:
N.T.S	Srj	MONSTE/ASHOK	ALOK	A2
PROJECT NO.	CAD FILE	DATE:	DATE:	REV.
101	REF.	13-Dec-15	13-Dec-15	10
DRAWING NO.	A-115b			