


Ground Floor Plan

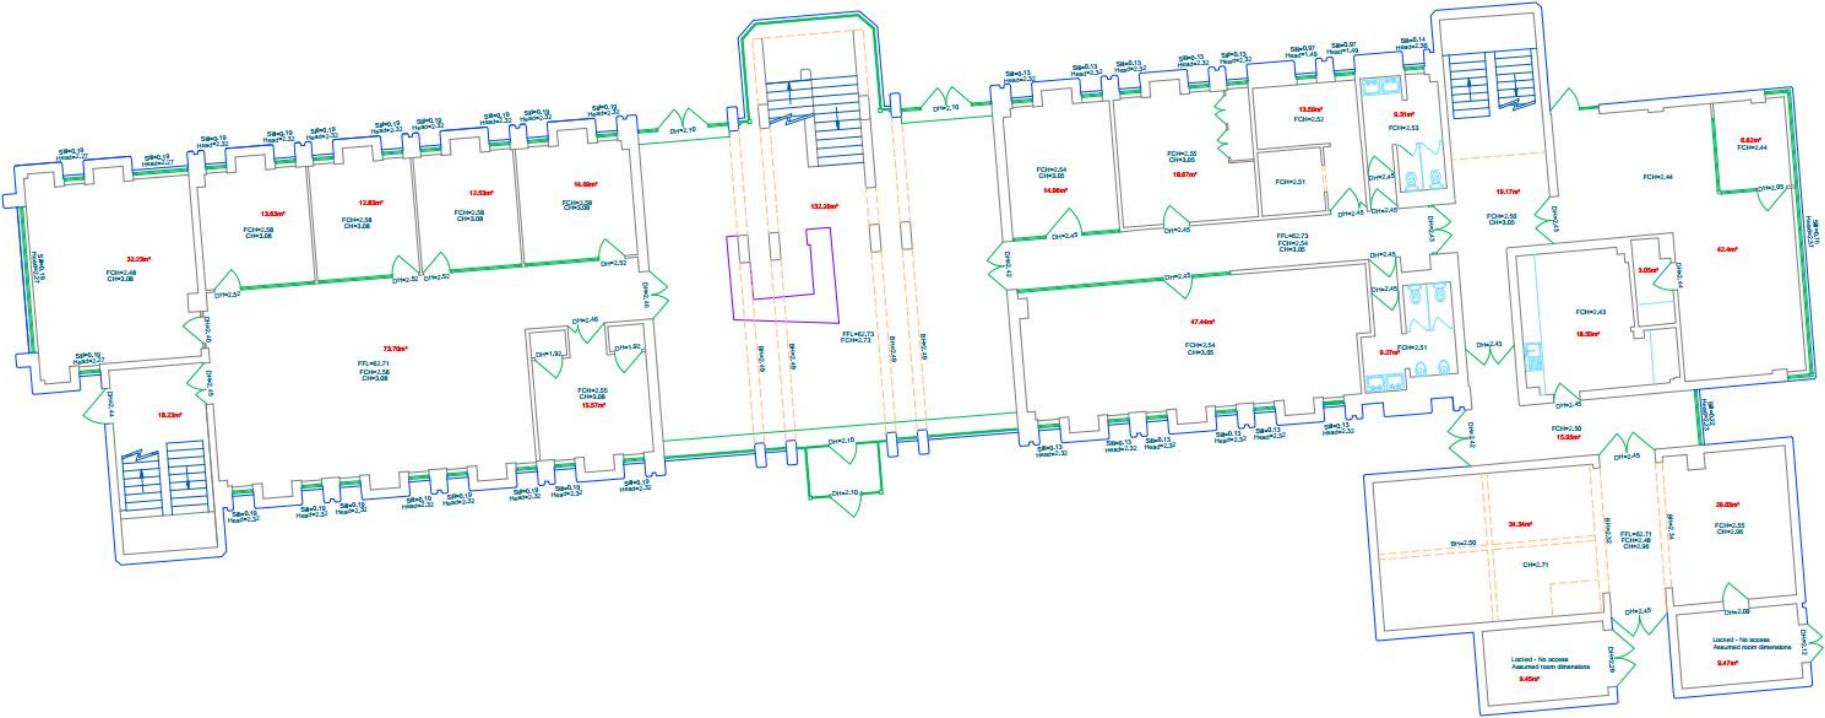

First Floor Plan

