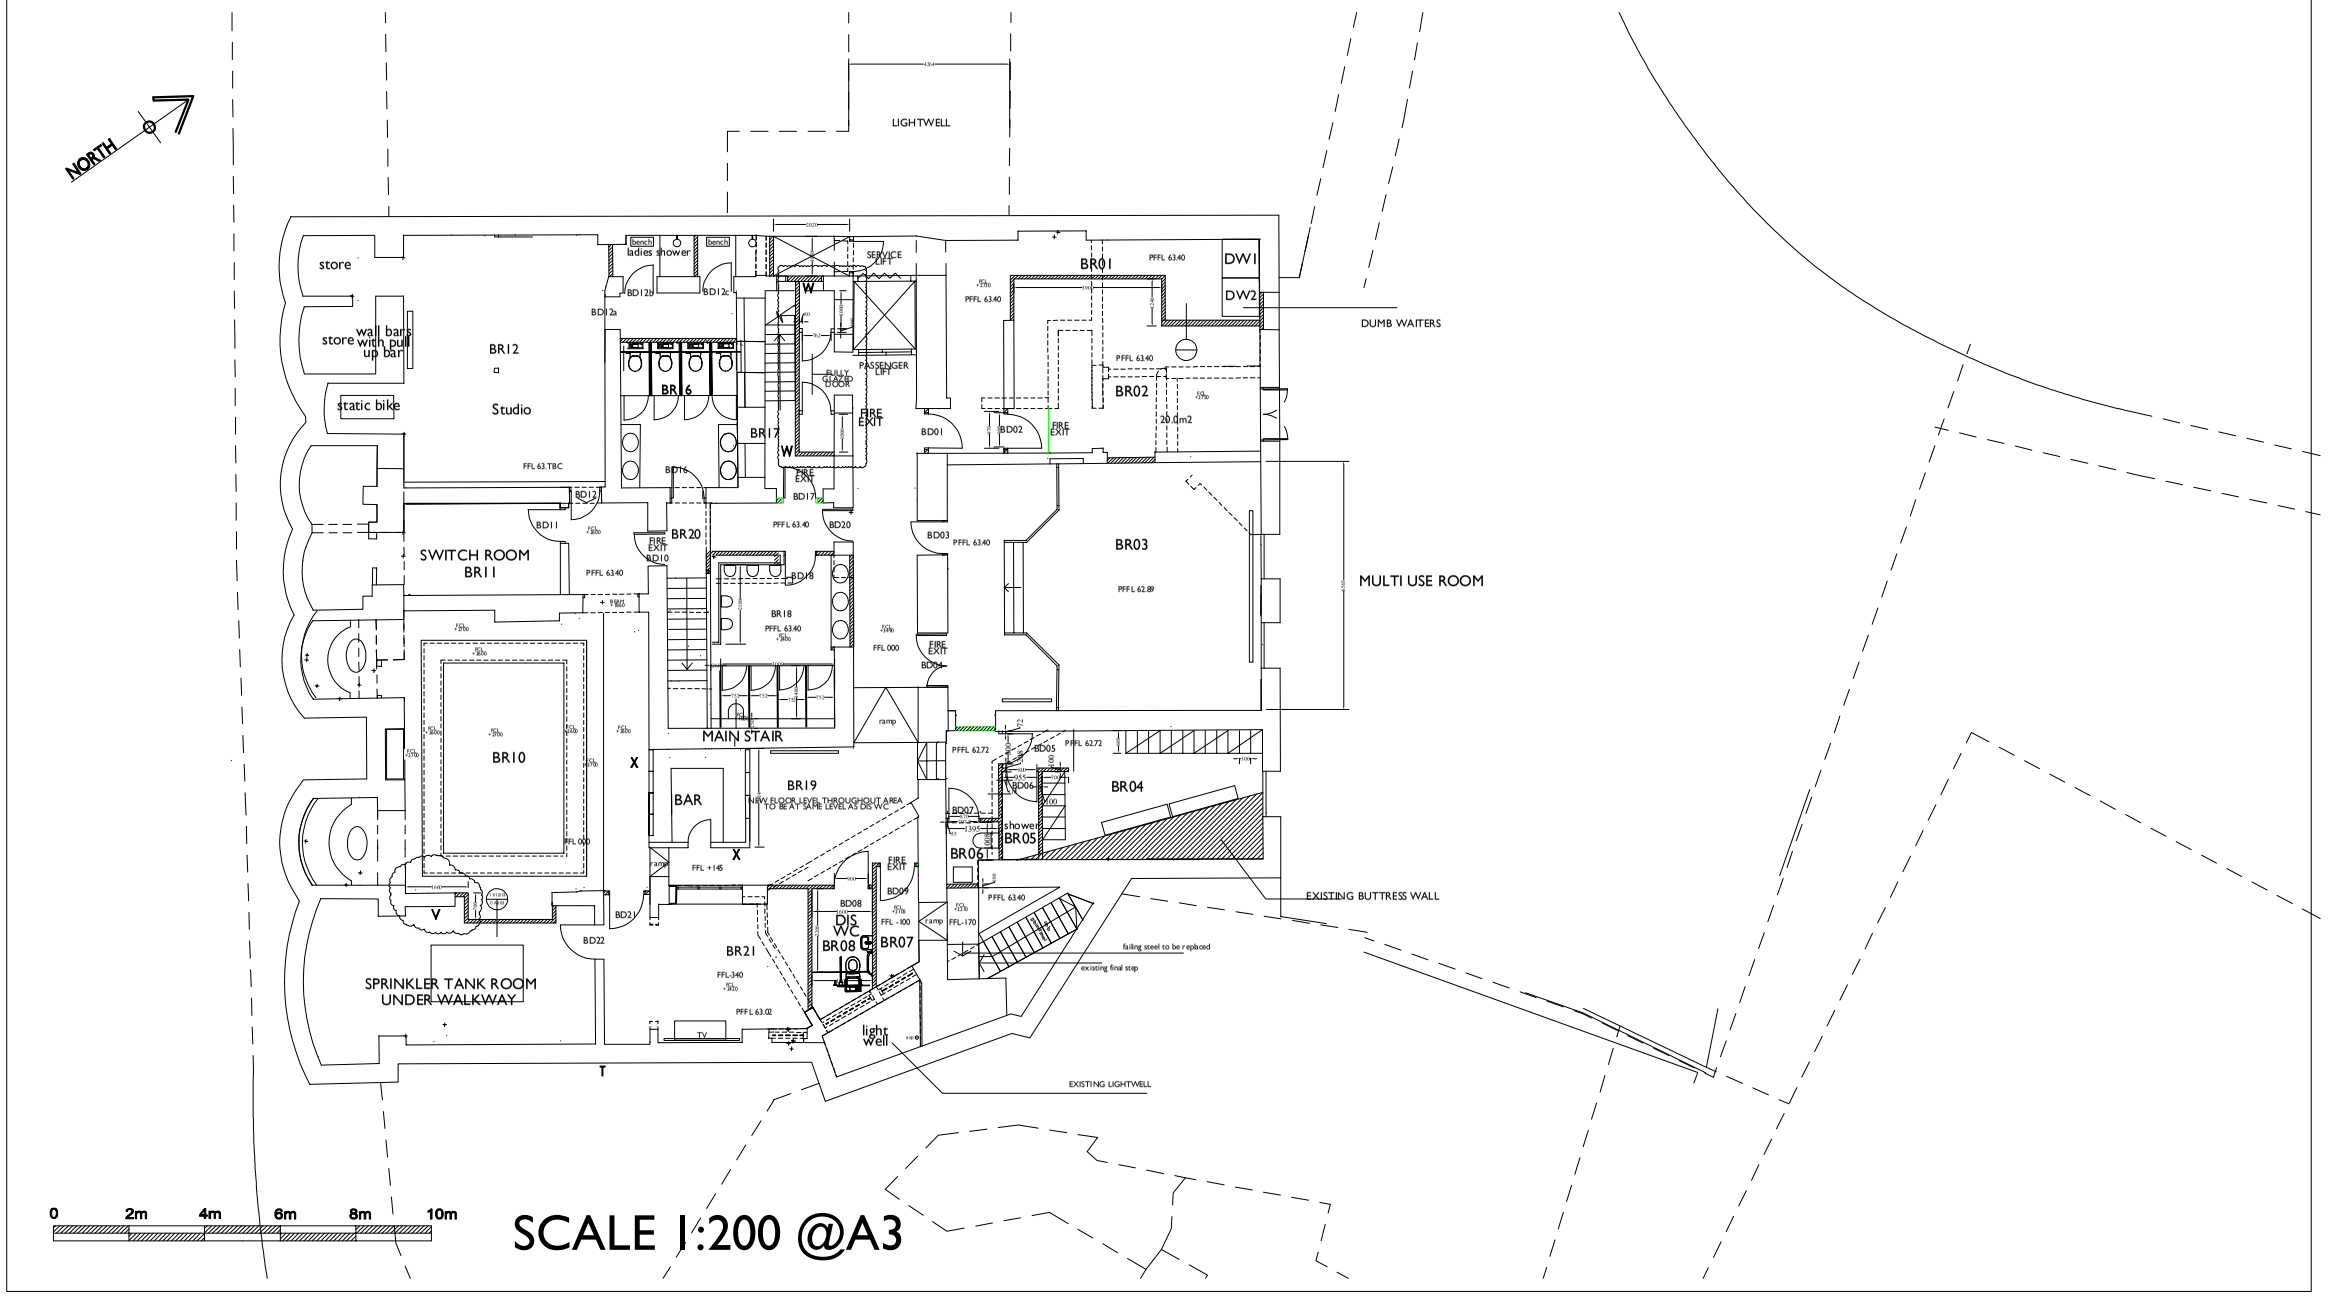

SCALE 1:200 @A3

NOTES:
Do not scale from this drawing.
Contractor to take and check all dimensions on site before work commences. Discrepancies to be reported to the architect. Subcontractors to verify all dimensions on site before making shop drawings or commencing manufacture.

CAD File

Rev.	Description	Initial	Date
A	ADDITION WCS ADDED	MKE	19-10-24
B	DIMS ADDED	MKE	08-11-24
C	LOCKER ROOMS REVISED STORE ADDED	MKE	19-11-24
D	STORE ADDED, BAR AREA ADDED	MKE	20-11-24
E	BAR WALL REVISED TO FIRE CONSLT	MKE	20-11-24
F	STORE ENLARGED	MKE	29-10-24
G	DIMS ADDED ALCOVE STORE DELETED	MKE	27-11-24
J	WC LAYOUT AND LOCATION REVISED	MKE	29-11-24
K	ADDITIONAL SITTING OUT DIMS ADDED	MKE	09.01.25

Rev.	Description	Initial	Date
L	WALL ADDED (DB03 HANGED)	MKE	24.01.25
M	DOOR ADDED (DB03 HANGED) DB04 HANGING OMITTED	MKE	24.01.25
N	ADDITIONAL SHOWER ADDED	MKE	19.03.25
P	DISABLED WC ADJUSTED STUDIO SHOWER REVISED	MKE	02.04.25
R	RAMPS AND FLOOR LEVELS REVISED TO BAR AREA	MKE	22.05.25
S	WALL TO RIGHT SIDE OF BAR REMOVED	MKE	04.06.25
T	DOOR ADDED (DB09 IN BELL DOOR) WALL	MKE	04.06.25
V	REVISED SEATING WALL SET OUT REVISED	MKE	24.06.25
W	BOD TIE ADDED	MKE	09.07.25
X	BAR RE-VISED	MKE	30.07.25

DENNER ELLIS BODDINGTON
CHARTERED ARCHITECTS
Phoenix Yard, 65 King's Cross Road, London WC1X 9LW
Telephone: 020 7239 4903 Fax: 020 78412 7482
E-Mail: architects@denelbod.co.uk

Client
TRB PROPERTY HOLDINGS LTD

ROYAL BELL
HIGH STREET
BROMLEY

Drawn | Checked | Status PLANNING

Title
PROPOSED BASEMENT PLAN

Date | Plot Date XX-11-22

Scale 1:200@A3

Drawing no. 23/463 / GA-005 | Revision X

Anglo-Overseas Consultants Limited. This drawing is copyright.