


- KEY
- FC Floor to Ceiling
  - FFC Floor to False Ceiling
  - F-C Floor to Cill
  - C-H Cill to Head
  - CRO Cill to Crown
  - SPR Cill to Springer
  - USB Underside of Beam
  - RAD Radiator

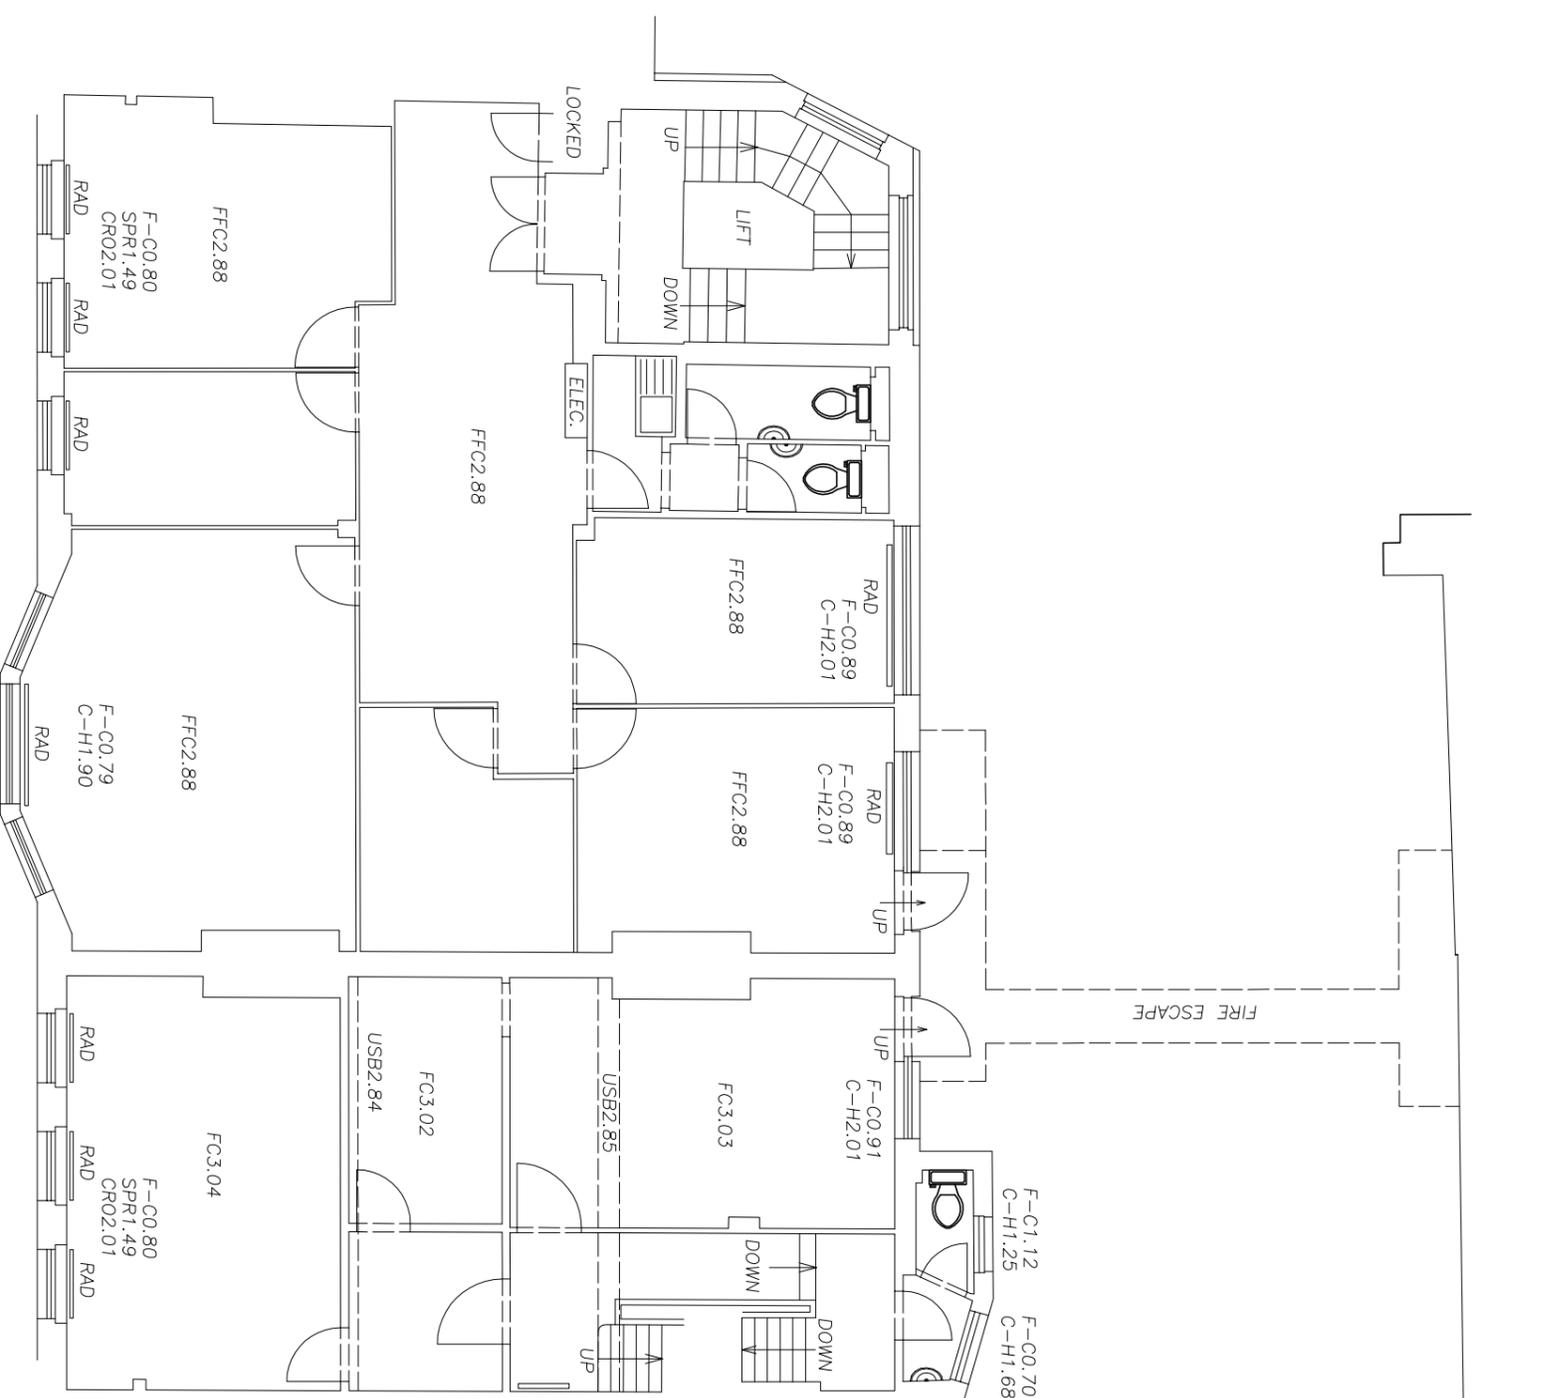

# GRYPHON SURVEYS

Hanover House  
 78-82 High Street  
 Brentwood, Essex CM14 4AP  
 Telephone: 01277-212794  
 Fax: 01277-214928  
 e-mail: gryphon@kelsey-gryphon.co.uk  
 www.gryphonsurveys.co.uk

Project: **RADIANT HOUSE**  
**MORTIMER STREET**

Title: **SECOND FLOOR PLAN**

Drawn  
 L.J.R.

Checked

Scale  
 1:100@A3

Date  
 05/07

Ref:

2676-4

D

C

B

A