


General Arrangement Layout	
	Extent of measured Area U+ side
	Extent of measured Area R+ side

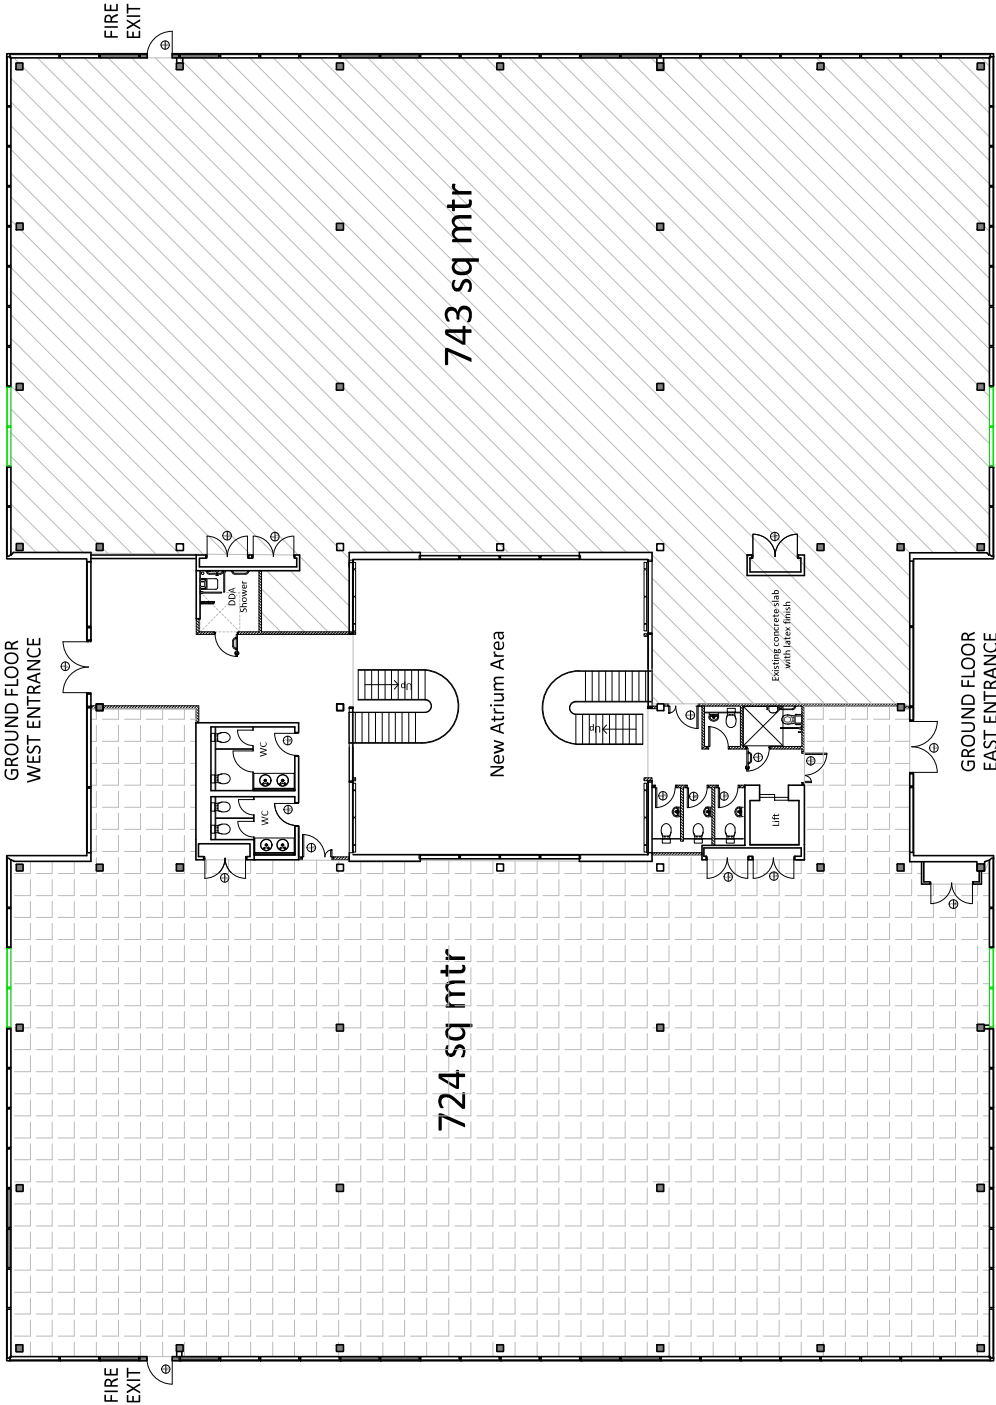


Rev By Date Description



Client	HILLVIEW GROUP		
Project Address	Elm Park Court Tilgate Forest Business Park Tilgate Road Crawley RH11 9BP		
Drawing	Ground floor General Arrangement		
Status	AS BUILT		
Scale	Drawn	Date	
1/100@A1	DS	25/01/17	
Project No.	Floor No.	Detail	Revision
7631	0	GA	AB

General Arrangement Layout

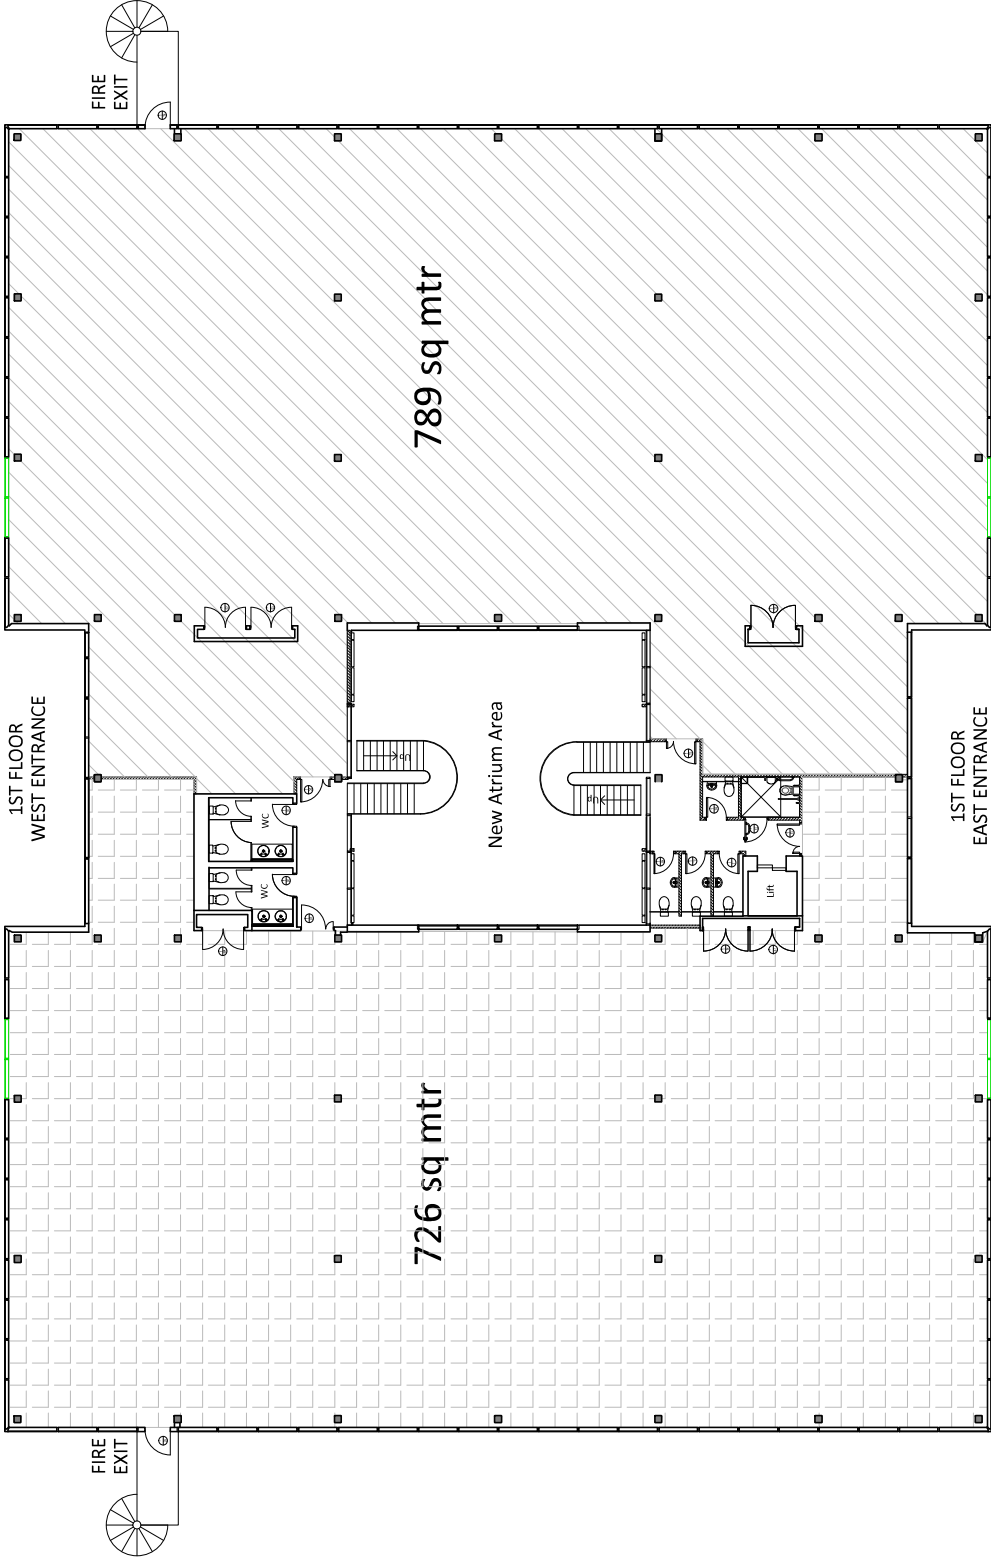

Rev By Date Description



Client	HILLVIEW GROUP
Project Address	Elm Park Court Tilgate Forest Business Park Tilgate Road Crawley RH11 9BP
Drawing	First Floor General Arrangement
Status	AS BUILT
Scale	Drawn DS
Project No.	7631
Floor No.	1
Detail	GA
Revision	AB