


DRAWING NOTES


This drawing (and associated documentation) is the copyright of UKBS LTD. The drawing (or any part thereof) may not be copied, transmitted or disclosed to any third party or unauthorised person without the prior written consent of the UK Building Surveys.

Under no circumstances should dimensions be scaled from this drawing, all dimensions and/or levels are to be checked on-site prior to the commencement of any work. Any discrepancies to be reported to the UKBS Offices or representative thereof immediately. 'IF IN DOUBT ASK'.

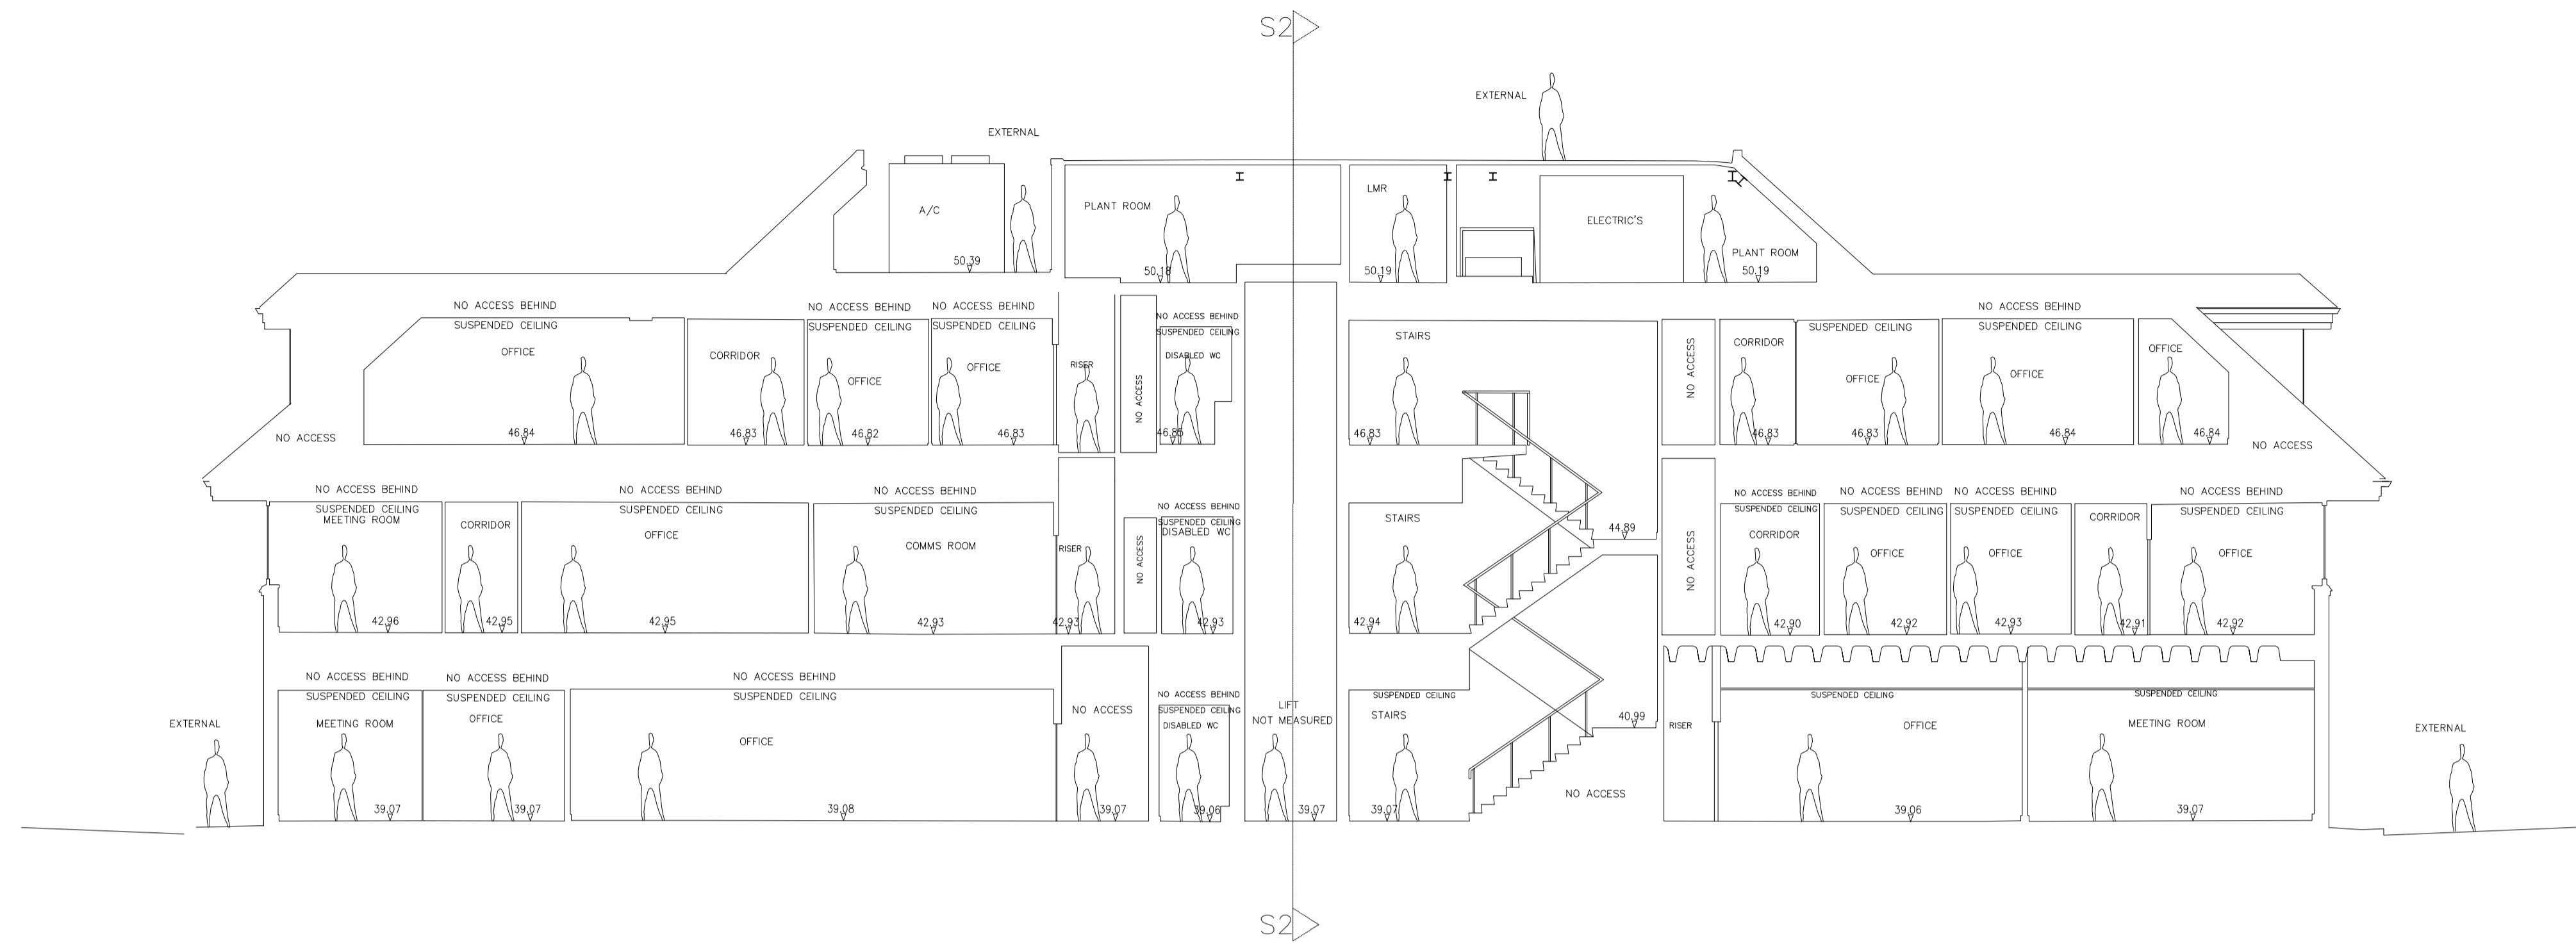

Datum 35M

SECTION 1

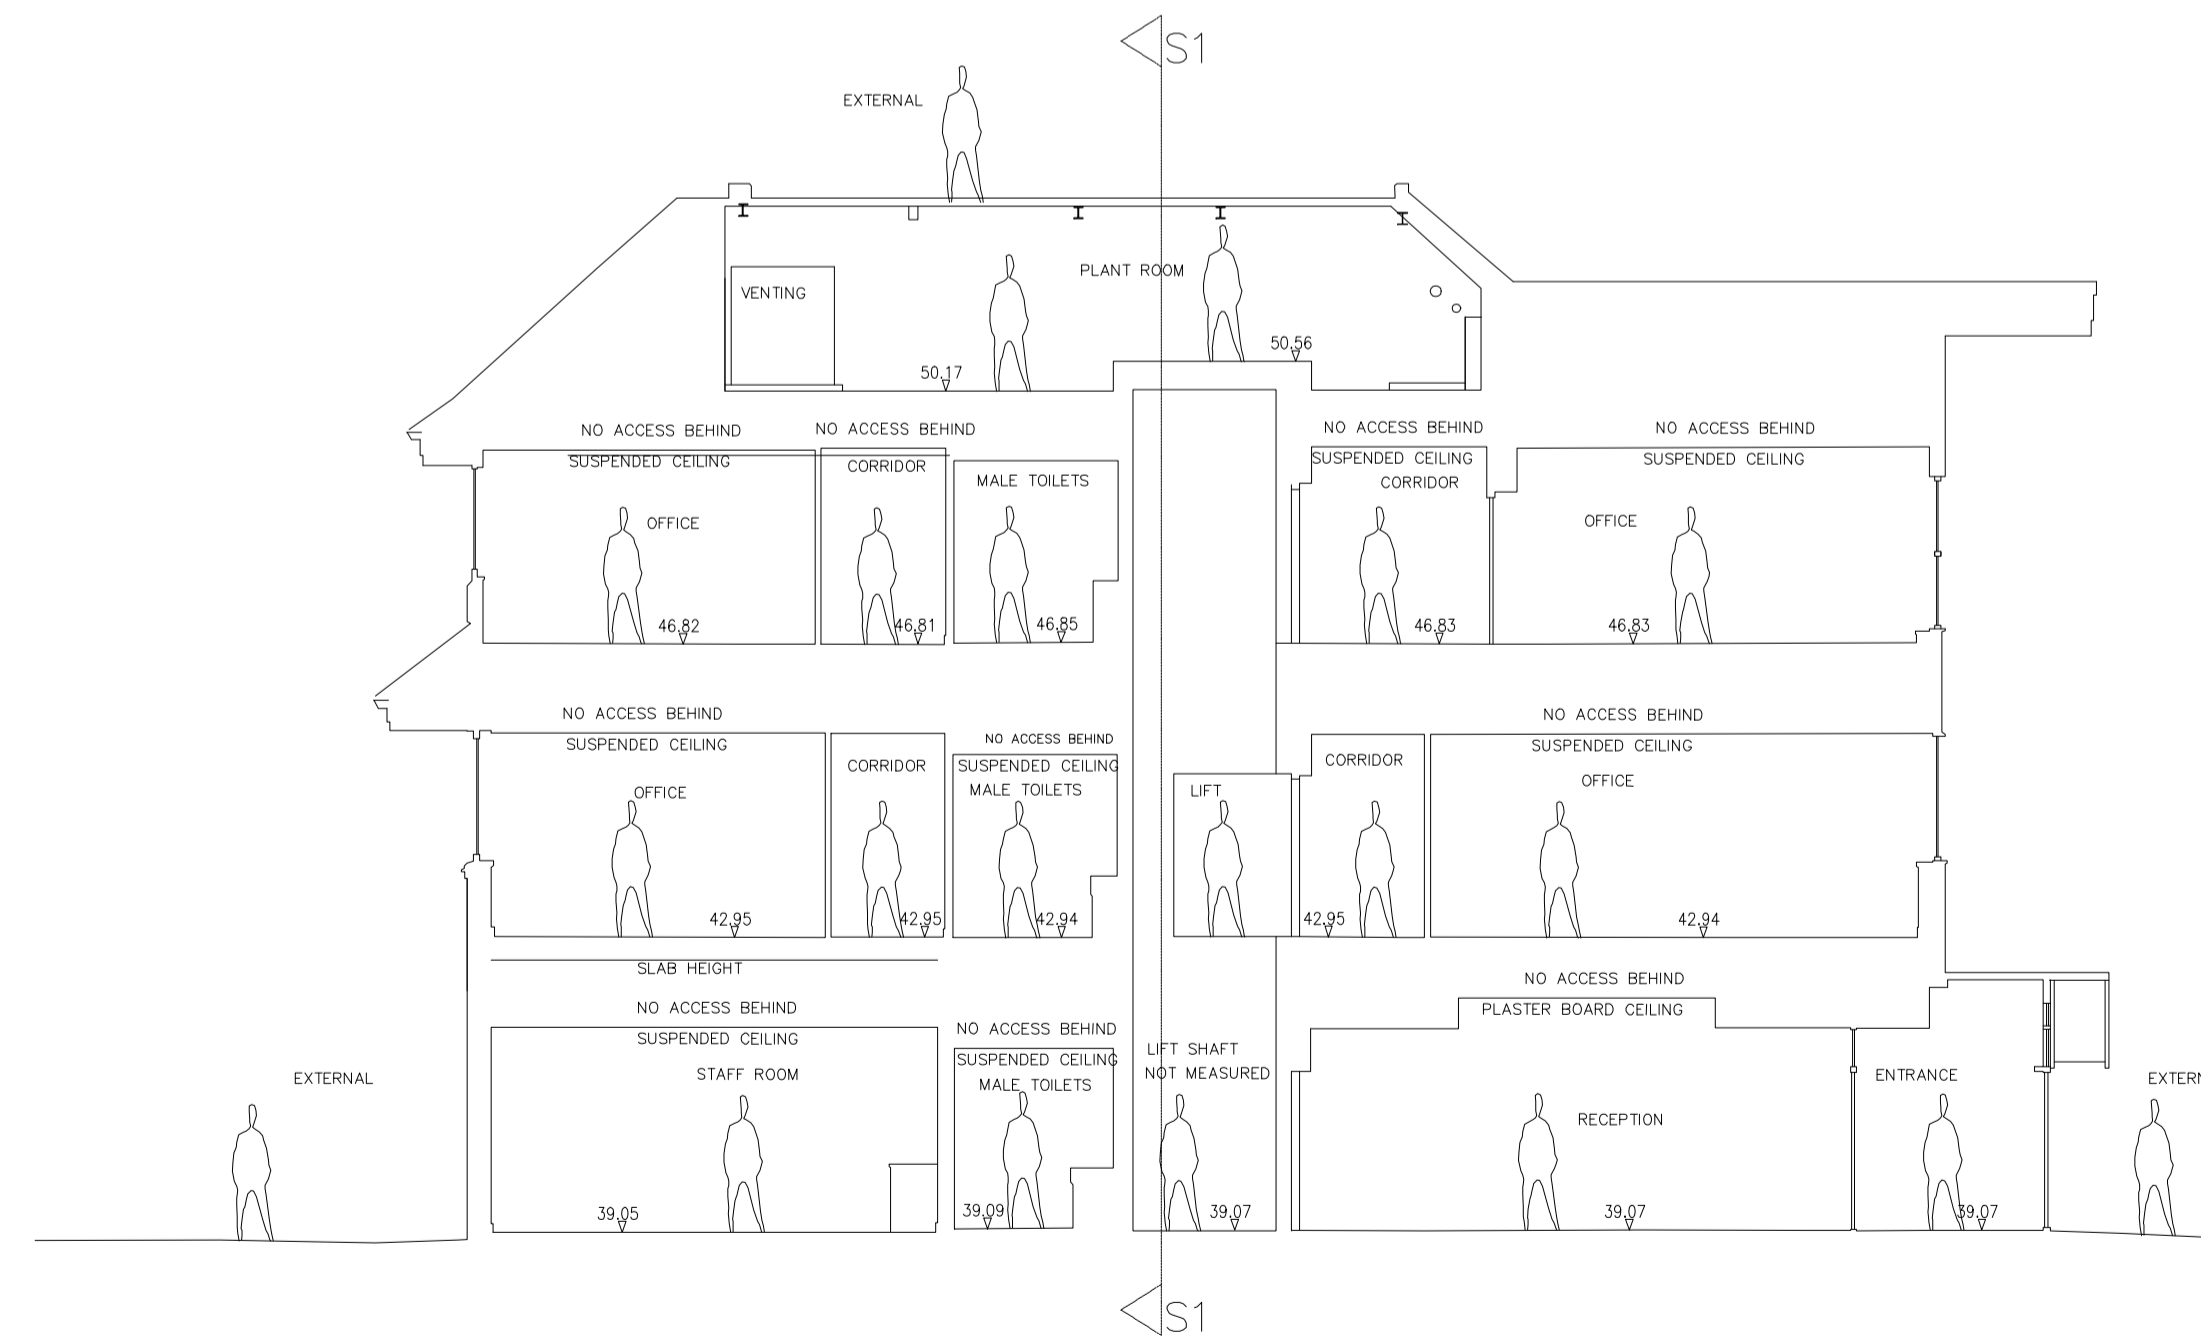

Datum 35M

SECTION 2



Rev	Description	Drawn	Date	Ch'kd	App'd
AMENDMENTS					

UK Building Surveys
 15 Broughton Close
 Grappenhall Heys
 Warrington
 Cheshire WA4 3DR
 Telephone 01925 962048
 Mobile 07791 393 937
 Email: mark.sutton@ukbuilding surveys.co.uk

Site					
Title					
Dorset House, Regents Park, Leatherhead, KT22 7PL					
Surveyed By	MAS	Checked By	HJH	Status	Original
Designed by		Approved By	MAS		
Scale	Sheet Size	CAD File	UKBS-9311	Date	10/01/2023
1:100	A1	Extisting Section 1 & 2			
Drawing No					Rev
UKBS-9311					