


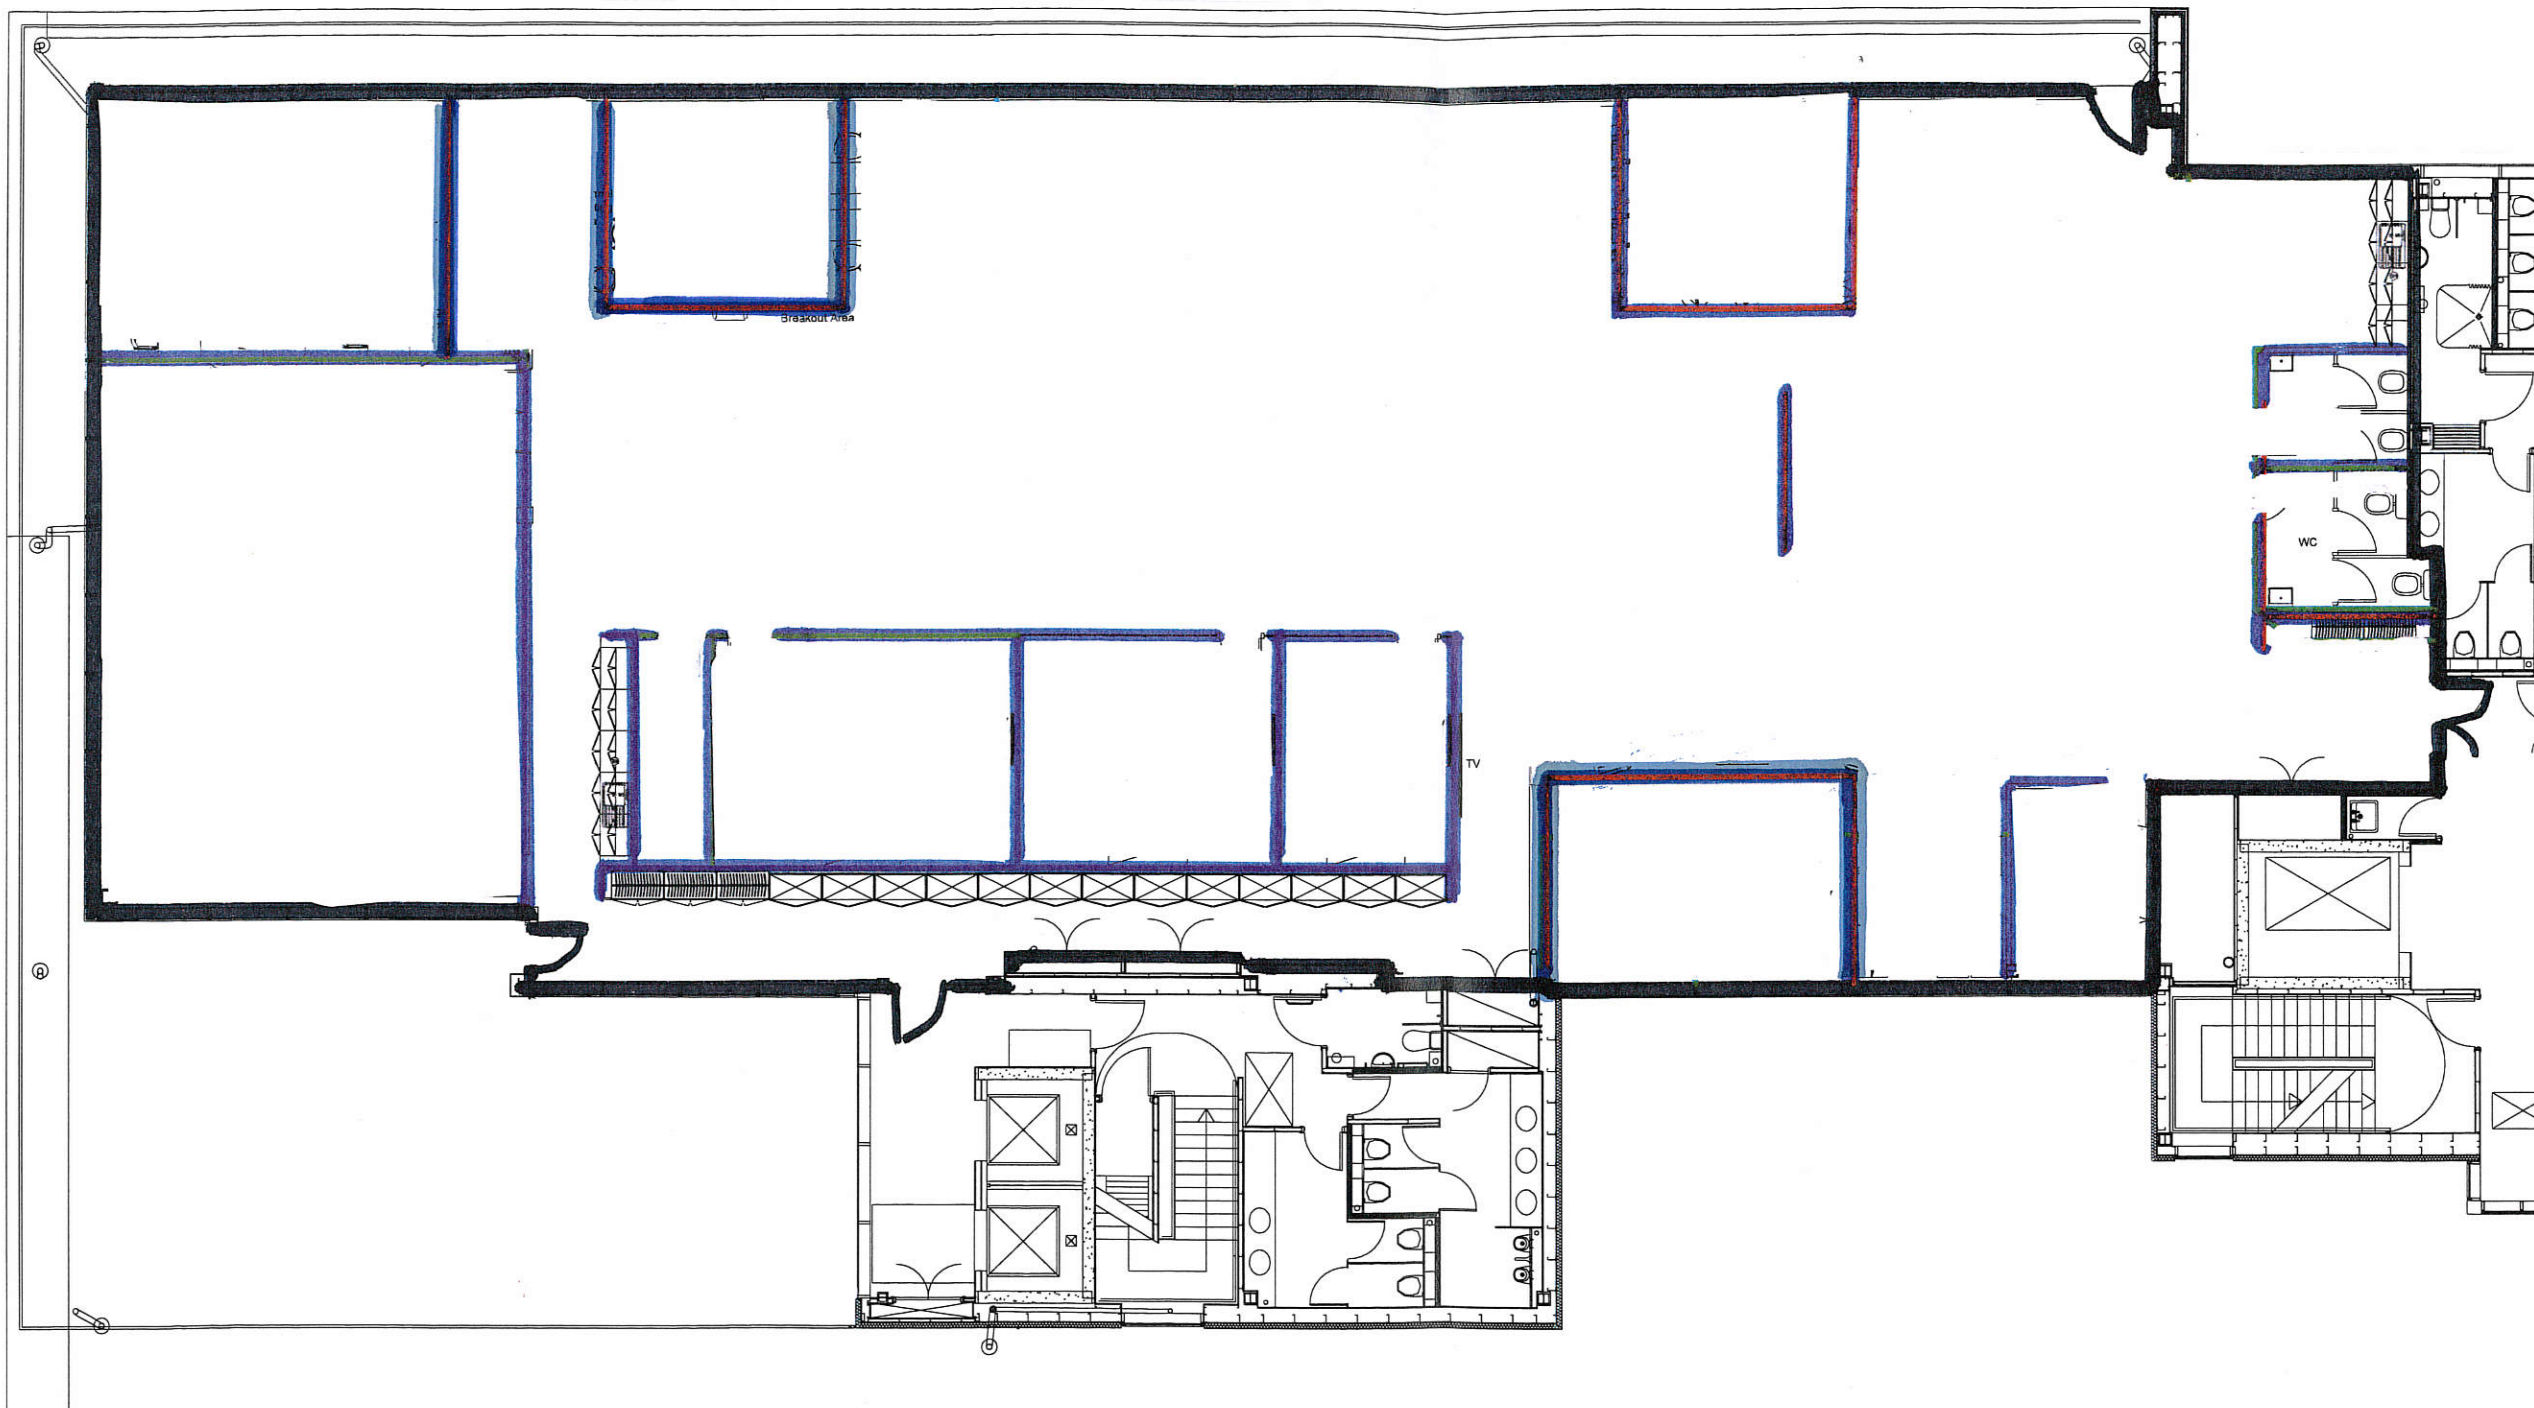

NOTES:

THIS DRAWING IS THE COPYRIGHT AND PROPERTY OF WORKPLACE CREATIONS IT MUST NOT BE COPIED OR PUBLISHED WITHOUT WRITTEN CONSENT AND MUST BE RETURNED TO US UPON REQUEST.

DO NOT SCALE FROM THIS DRAWING. ALL MEASUREMENTS MUST BE SITE CHECKED BEFORE THE COMMENCEMENT OF ANY WORK.

Signed.....Date.....

GENERAL NOTES:

Revisions :								
No:	Date:	Description of Works:	No:	Date:	Description of Works:	No:	Date:	Description of Works:
A	23.12.15	Layout Updated						
B	20.01.16	Layout Updated						

workplacecreations

Vintage Yard
59 Bermondsey Street
London
SE1 3XF

FOR ISSUE

tel. 020 7407 2390
fax. 020 7379 6033
email. info@workplace-creations.co.uk
www. www.workplace-creations.co.uk

Client: Mazars LLP Drawing No: MMK_5P_GA_over Scale: 1:100 @A2
Project: The Pinnacle Revision No: B Drawn By: Kgross
Title: WPC_PROPOSED LAYOUT Date of Origin: 01.12.15 Checked By: RW