

	Survey Station		Bench Mark
	Direction of Floorboards		Level Position
	Step Up		7% 72
	Banking		Sloping Ceiling
	Fence		Sloping Masonry
	Tree		Gates
	Foul Drainage		Tree Spread
	Storm Drainage		Telecom D/H
	Electricity D/H		Fresh Water
	Gas		Iron Railings
	Barbed Wire		Post & Rail
	Chain Link Fence		Open Boarded
	Wire Mesh		Monocle
	Mercury IC		Notice Board
	No Further Info		Overhead
	From Records		Roof Level
	Road Sign		Rolled Steel Joist
	Rainwater Pipe		Soleway
	Stop Cock		Sign Post
	Threshold Level		Traffic Light
	Tactile Paving		Telephone
	Unusable		Unable To Lift
	Vent		Vent Pipe
	Vents Into Ground		
	Gas Meter		Water Stop Cock
	Water Valve		High/Light

NOTES

THE AREAS SHOWN ON THIS PLAN HAVE BEEN MEASURED AND CALCULATED IN ACCORDANCE WITH THE RICS CODE OF MEASURING PRACTICE, 6th EDITION AND REFLECT THE STATE OF THE BUILDING ON 23rd NOVEMBER 2010


REV	DATE	PREV	REVISION DETAILS

WESTBROOK PARTNERS
BERKELEY SQUARE HOUSE
LONDON
W1J 6DD

JOB TITLE
AUSTRALIA PORTFOLIO
ARTEMIS
ODYSSEY PARK
RUISLIP

GROUND FLOOR

DRAWING 1 OF 2	AUTOCAD DRAWING FILE NAME
CLIENT JOB No.	ARTEMIS-GF-DWG
REVISION SUFFIX	
SCALE 1/200	
SHEET SIZE A3 (420x597mm)	DATE NOV 2010
SURVEYOR MTGS	DRAWN MTGS
CHECKED	MEM

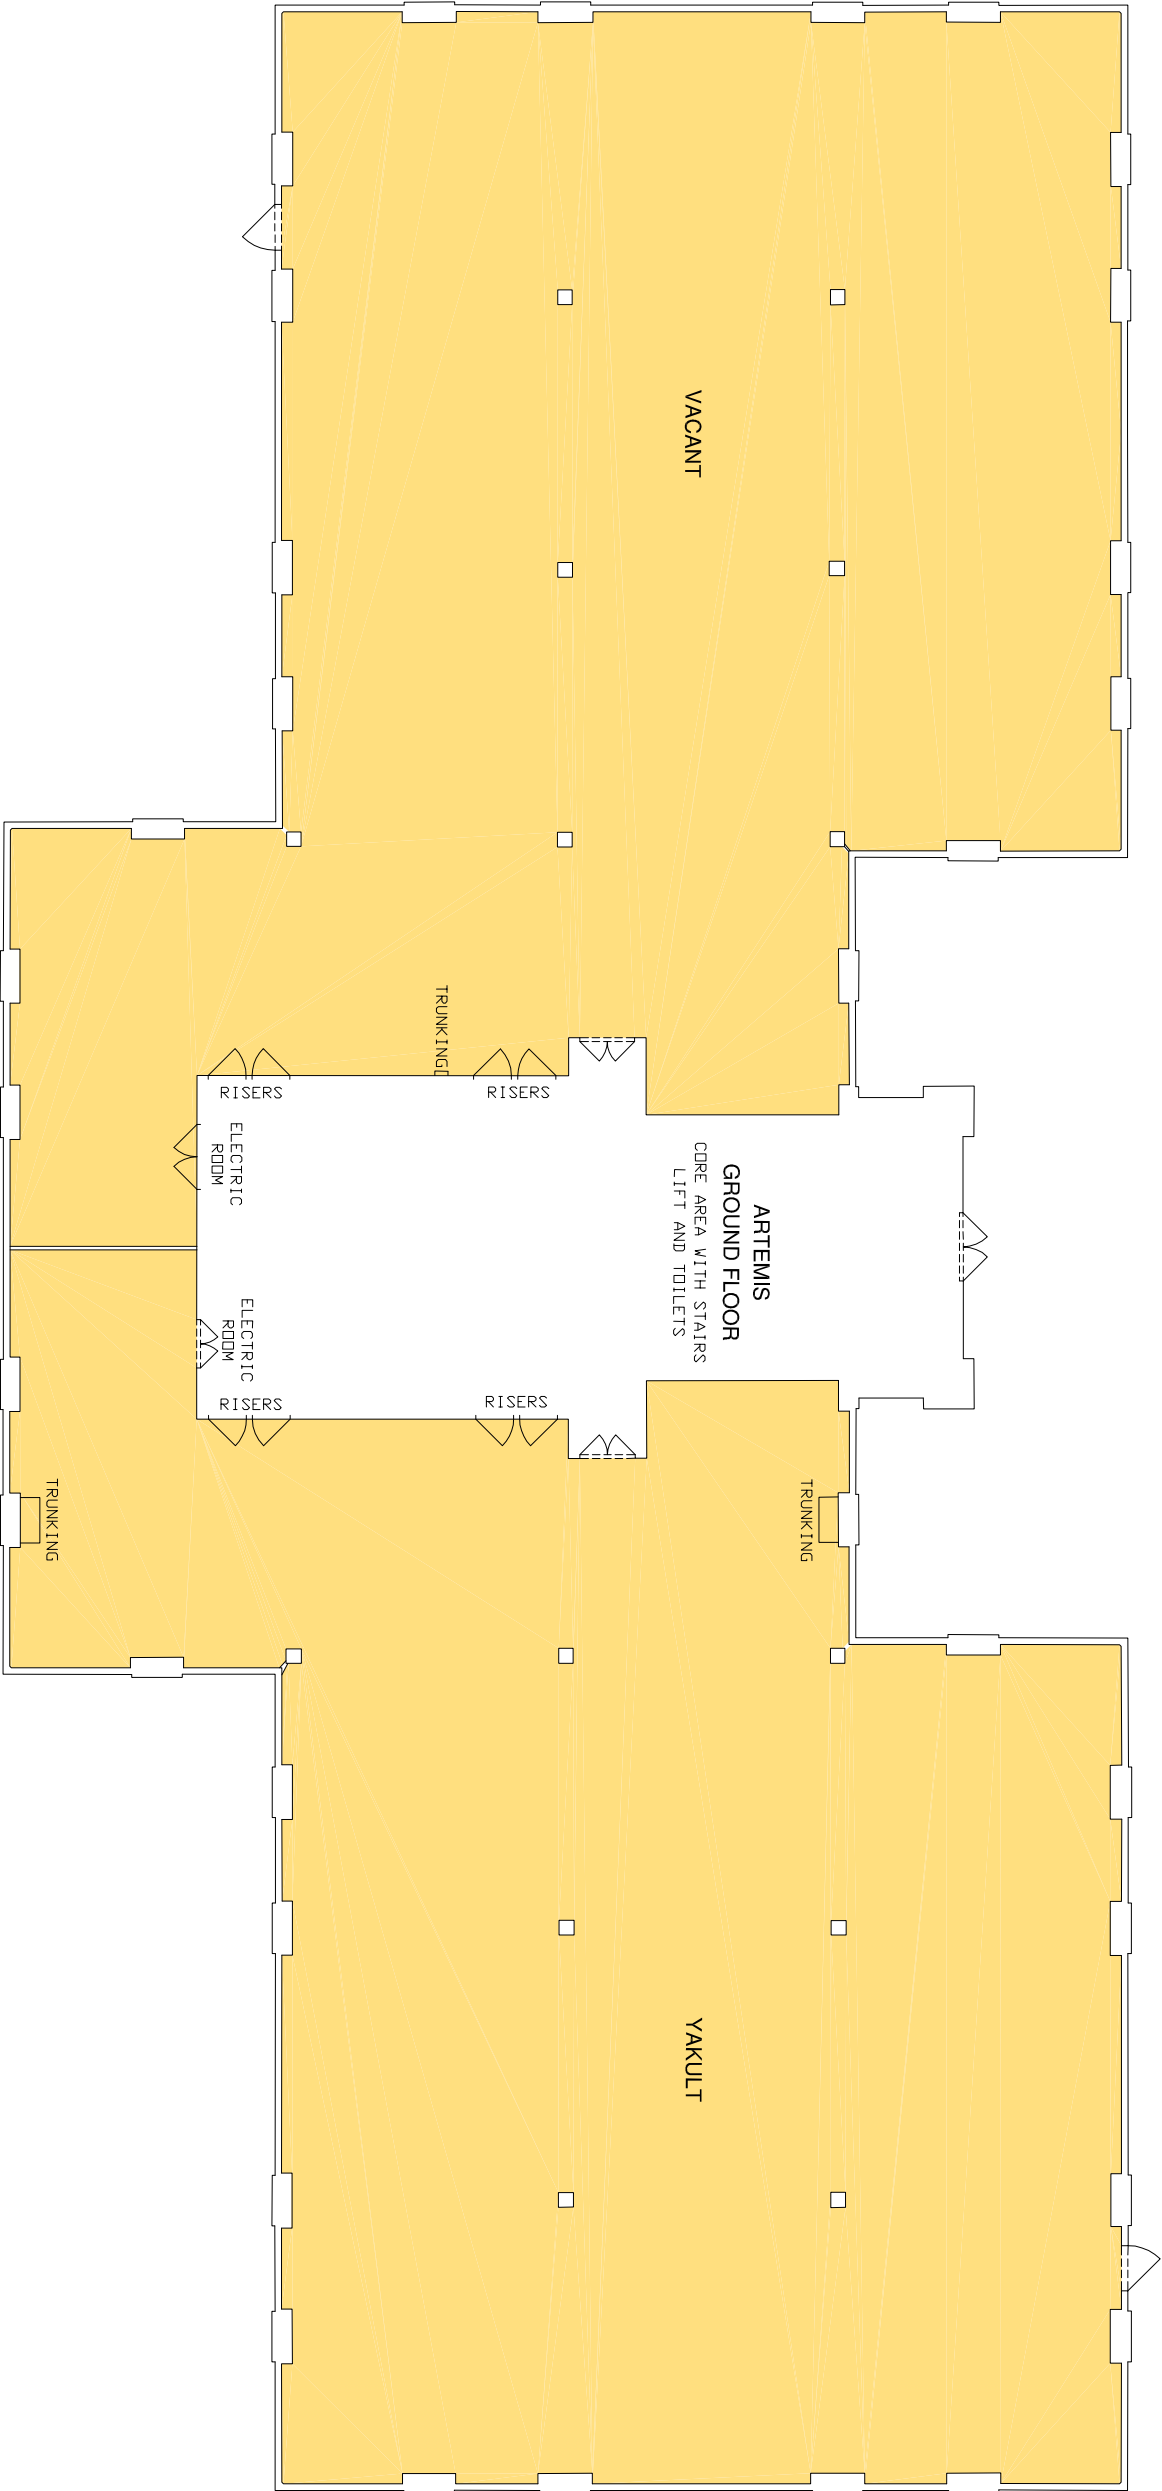

NET INTERNAL AREA
VACANT OFFICE 646.8 sq m (6962 sq ft)
YAKULT 647.3 sq m (6967 sq ft)
TOTAL 1294.1 sq m (13929 sq ft)

SCALE 1:200

