

Stn S2
4.290

177330 N

177320 N

177310 N

177300 N

530570 E

530580 E

530590 E

530600 E

530610 E

530620 E

Stn S1
4.216

Slm S4
4.298 

[illegible]

SURVEY CAVEATS

The survey is commensurate with band D accuracy, as specified in the RICS survey definition of accuracy bonding table.

All levels are above OS Newlyn Datum and the survey grid shows on the drawing in orange, referenced to OS National Grid at the following point: 530591.133E, 177517.050N, obtained from multiple network RTK GPS observations.

Drawing units are metres.

All quoted dimensions and levels are in metres.

[illegible]

NBS SYMBOLS

51.80	Ceiling Level	1.80	Ceiling Height
F52.30	False Ceiling Level	F52.30	False Ceiling Height
BSL 60.00	Beam Softix Level	BH 2.30	Beam Softix Height
S 50.00	Sill Level	S 0.80	Sill Height
H 52.40	Head Level	H 1.80	Head Height
Min 56.50	Ceiling Sloping Level	Min 1.50	Ceiling Sloping H
Max 57.00		Max 2.00	
ASL 52.00	Arch Levels	ASH 2.00	Arch Heights
AL 52.30		AM 2.30	
DL 52.00	Door Level	DM 2.00	Door Height
50.00		h 0.90	Feature Height
21.37	Spot Level Elevation		Roar Arrows
▼	Spot Level Elevation		Point Down
↗	Stair/Step Arrows		Stair Outline
●	Point Up		Assumed
↘	Sloping Ceiling		Position
▲	Point Up		



 www.redlaser scanning.co.uk

enquiry@redlaserscanning.co.uk

London Head Office
✉ 23 Sussex Street
SW1V 4RR

0207 477 2175

Project
47-49 Dorset Road
London
SW8 1EX

Description	First Floor Plan
-------------	------------------

Survey Date 14/07/2025	Drawing Date 05/08/2025
---------------------------	----------------------------


Sheet	Scale
A0	1:

Drawing No. 3753-FP-01-M2-0

Checked	Revision
PS	F

Survey Stations			
Name	Easting	Northing	Height
S1	530575.570	177310.902	4.216
S2	530578.815	177336.824	4.296
S3	530611.726	177321.554	4.542
S4	530598.420	177298.919	4.298

Scale 1:50

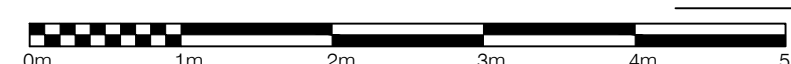

530620 E

530570 E