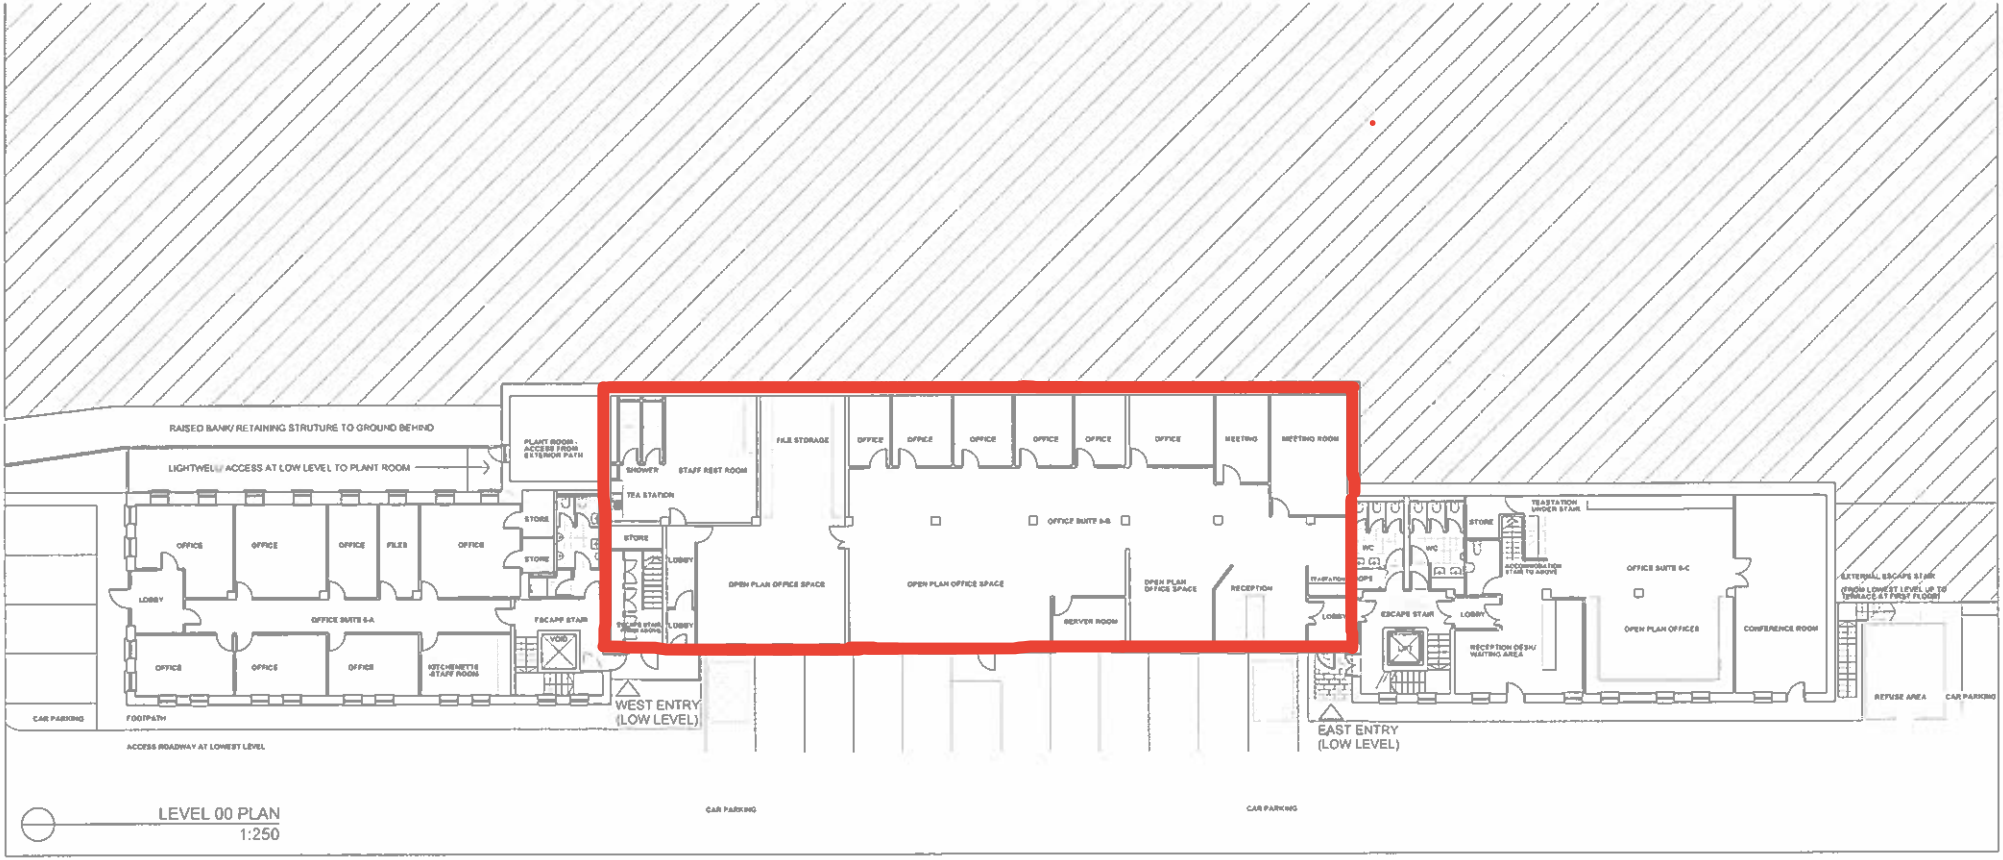

N

NORTH

S SURVEY
PL PLANNING
SK SKETCH
T TENDER
CN CONSTRUCTION
AB AUTHORITIES

Figured dimensions only to be taken from this drawing - All dimensions to be checked onsite. Discrepancies to be brought to the attention of the office before commencement of work.

NOTES:

pacstudio
ARCHITECTURE + ENVIRONMENTS

PAC Studio Limited
Tower 1 Pumphlly Court
Pumphlly Lane, Dublin X95

T : + 353 1 453 8806
W : www.pacstudio.ie
E : info@pacstudio.ie

CLIENT	BEEMAN INVESTMENTS
JOB TITLE	BRIDGEWATER BUSINESS CENTRE 33 CONYNGHAM ROAD PHOENIX PARK DUBLIN 8 D08 V0AC
DRAWING TITLE	FLOOR PLANS - AS BUILT
STAGE	PAC
SCALE	1:250 at A3 1:125 at A0
AUTHOR	GP
DATE	29/05/2018
JOB NO	1704
DWG NO	BBC A2-100
REV NO	