

INDICATIVE ONLY


NOTES

- 1) ALL DIMENSIONS TO BE CHECKED ON SITE AND NOT SCALED FROM THIS DRAWING.
- 2) HOLLIS SHALL BE INFORMED IN WRITING OF ANY DISCREPANCIES.
- 3) ALL DIMENSIONS ARE IN METRES ONLY.
- 4) THE ORIGIN AND ORIENTATION OF THE SURVEY GRID RELATE TO A GPS TIE TO ORDNANCE SURVEY GRID.
- 5) ALL LEVELS ARE BASED ON A GPS TIE TO THE OSGMARS(8) GEOD MODEL.
- 6) HATCHING SHOWN IN OUR DRAWINGS IS FOR VISUAL PURPOSES ONLY.
- 7) LINES SHOWN IN DASH-DOT FORMAT INDICATE THAT THE ELEMENT POSITION IS ASSUMED FROM NEARBY/LIMITED DATA.

KEY

A	Alarm	HB	Hand Room
A/C	Air Conditioner	HR	Handrail
AH	Arch Height	IC	Inspector Cover
AL	Arch Level	IRF	Iron Rolling Fence
ASH	Arch Spring Height	JB	Junction Box
ASL	Arch Spring Level	L	Light
ATM	Automated Teller Machine	LB	Litter Bin
B	Balloon	MZ	Maximum
BGP	Break Glass Point	Min	Minimum
BM	Floor To Beam Height	CM	Overhead
B	Brick	OSF	Open Boarded Fence
BSW	Brick Retaining Wall	OSBM	Ordnance Survey Bench Mark
BSL	Beam Soffit Level	P	Post
BW	Brick Wall	PL	Plasterwork Light
BWF	Barbed Wire Fence	PRF	Post and Rail Fence
CBF	Close Boarded Fence	PS	Painting Stones
CCTV	Closed Circuit Television	PRF	Post and Wire Fence
Ch	Chimney	Rd	Radial
Chy	Chimney	RDH	Recessed Door Mat
CL	Corrugated Iron Fence	R	Rail
CL	Cover Level	RSD	Roller Shutter Door
CLF	Chain Link Fence	RSJ	Roller Shutter Door
Col	Column	RWP	Rain Water Pipe With Gully
Conc	Concrete	RWP	Rain Water Pipe
COW	Cable on Wall	SB	Sign Board
CPS	Concrete Paving Slabs	SBM	Site Bench Mark
Cup	Cupboard	SF	Security Fence
DH	Door Height	SH	Spring Height
DP	Down Pipe	SI	Signpost
DVC	Drainage Channel	SO	Smoke Outlet
DH	Dust Height	SP	Sign Post
EB	Electrical Junction Box	SS	Security Sensor
EM	Electricity Meter	T	Telephone
ESG	Electrical Switchgear	TBM	Temporary Bench Mark
FA	Fire Alarm	THL	Threshold Level
FB	Flower Bed	Top Of Wall	Typical To Lift
FC	Floor To Ceiling Height	Typ	Typical
FE	Fire Extinguisher	U	Unable To Lift
FFL	Finished Floor Level	V	Vault
FHB	Fire Hose Reel	VCP	Vehicle Changing Point
FL	Floor Level	VP	Vent Pipe
FR	Floodlight	W	Window
FS	Gully	WCL	Window Cill Level
GA	Gas Meter	WH	Water Header
GV	Gas Valve	WHL	Window Head Level
h	Height	WM	Water Meter

FLOOR PLAN SYMBOLS

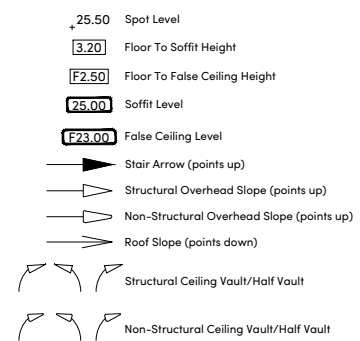

REVISIONS

REV	DATE	AMENDMENTS	INITIAL

THIS DRAWING IS FOR THE FOLLOWING PURPOSE ONLY:
PRELIMINARY ☐ TENDER ☐ CONSTRUCTION ☐
SKETCH ☐ MEASURED SURVEY ☒ CONTRACT ☐

TITLE

DEMOLITION FLOOR PLAN

CLIENT

Nuveen Real Estate
201 Bishopsgate
EC2M 3AE
London

PROJECT NAME

Unit 4b
Avant Business Centre
Milton Keynes
MK1 1DR

HOLLIS



Sovereign Court
211 Witan Gate East
Central Milton Keynes
MK9 2HP

T +44 1908 774 460
W hollisglobal.com

DATE	24.01.2025	DRAWN BY	BM
SCALE	1:100	CHECKED	MD
PROJECT	LINE	ORIGINATOR	VOLUME/ ZONE/RELDG
127374	104	HLS	00
FILE	DISCIPLINE/ TYPE	NUMBER	STATUS
M2	B	10200	A1