


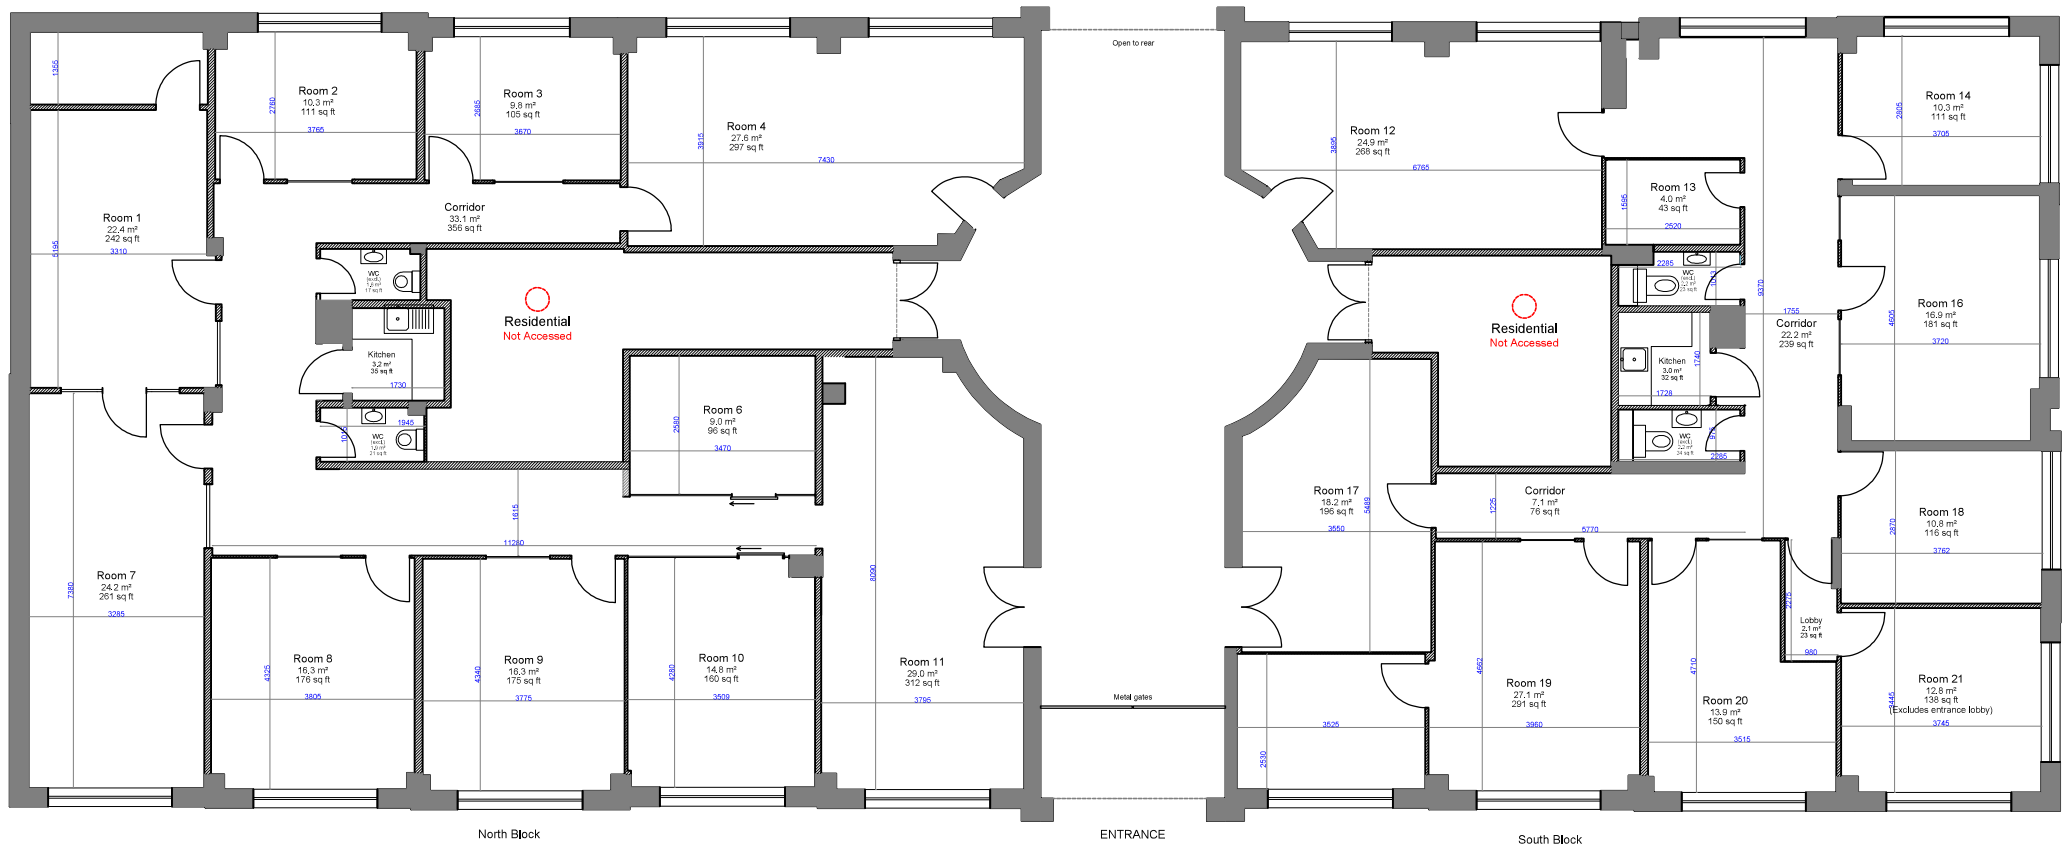

Ground Level



0m 5m
Scale 1:100

The Vineyards

36 Gloucester Avenue
London
NW1 7BB

Date	Revision	Project Number	Description	Rev
01/10/2026	01	26.08.3718	Property Survey	0/1

Drawing Name
Ground Level Floor Plan

REFERENCES

sterlingtemple

0203 4639225
www.sterlingtemple.com