



EXISTING BASEMENT FLOOR PLAN

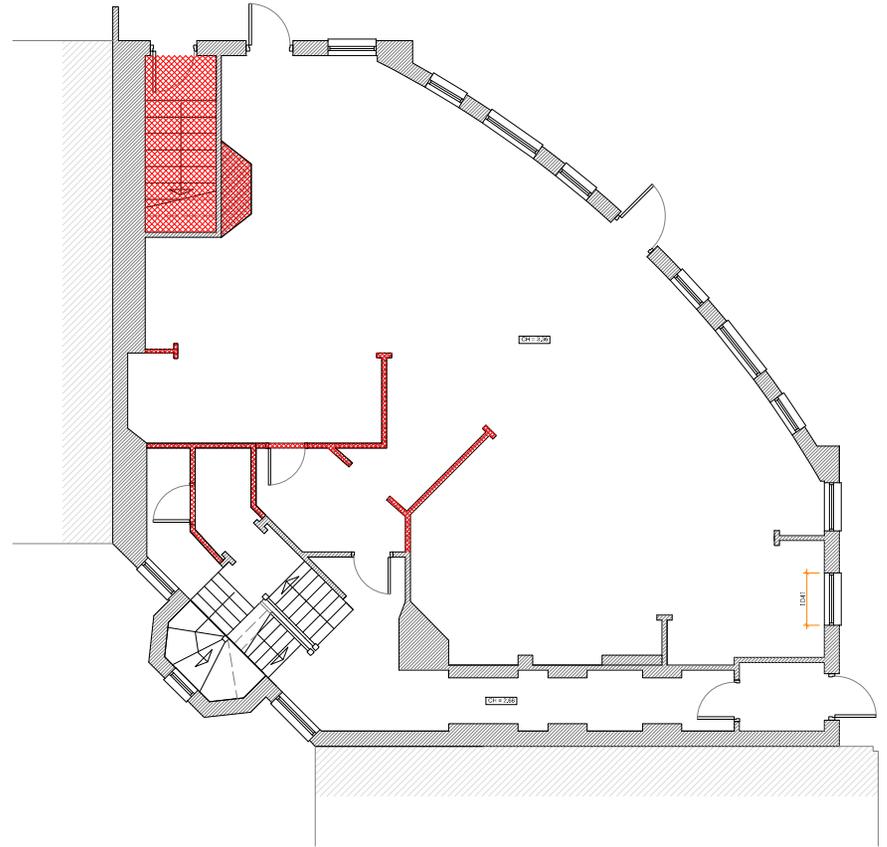

EXISTING GROUND FLOOR PLAN

 

02 EXISTING PLANS
SCALE 1:50 @ A1

NOTES:

1. All dimensions to be checked on site.
2. Any discrepancies to be reported back to CR Design Services.

CR Design Services

Silico House, Arkley Hoads,
Durham, DH1 5TS
sales@crdesignservices.co.uk
www.crdesignservices.co.uk
Tel: 0191 945 0000

Rev. Date Description

DRAWING NO	DATE	DRAWING	PROJECT
1939 - 02	23.05.22	EXISTING PLANS	33 RICHMOND PLACE BRIGHTON BN2 9NA
DRAWN	SCALE		
JS	1:50 @ A1		