



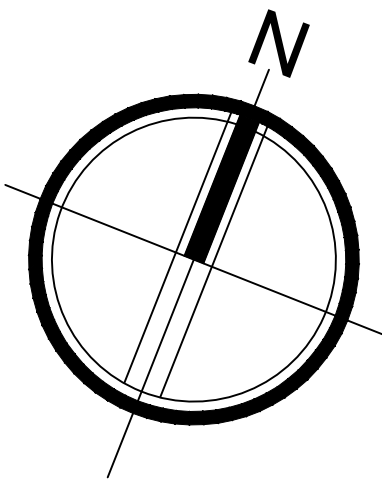

This drawing is not to be scaled or manipulated in any way. Any errors or discrepancies should be reported to SDA Architecture.

Work to given dimensions only which the contractor must check and confirm all dimensions on site.

Copyright to remain with SDA Architecture and is not to be copied, lent or used by any third party without the express written permission of SDA Architecture.

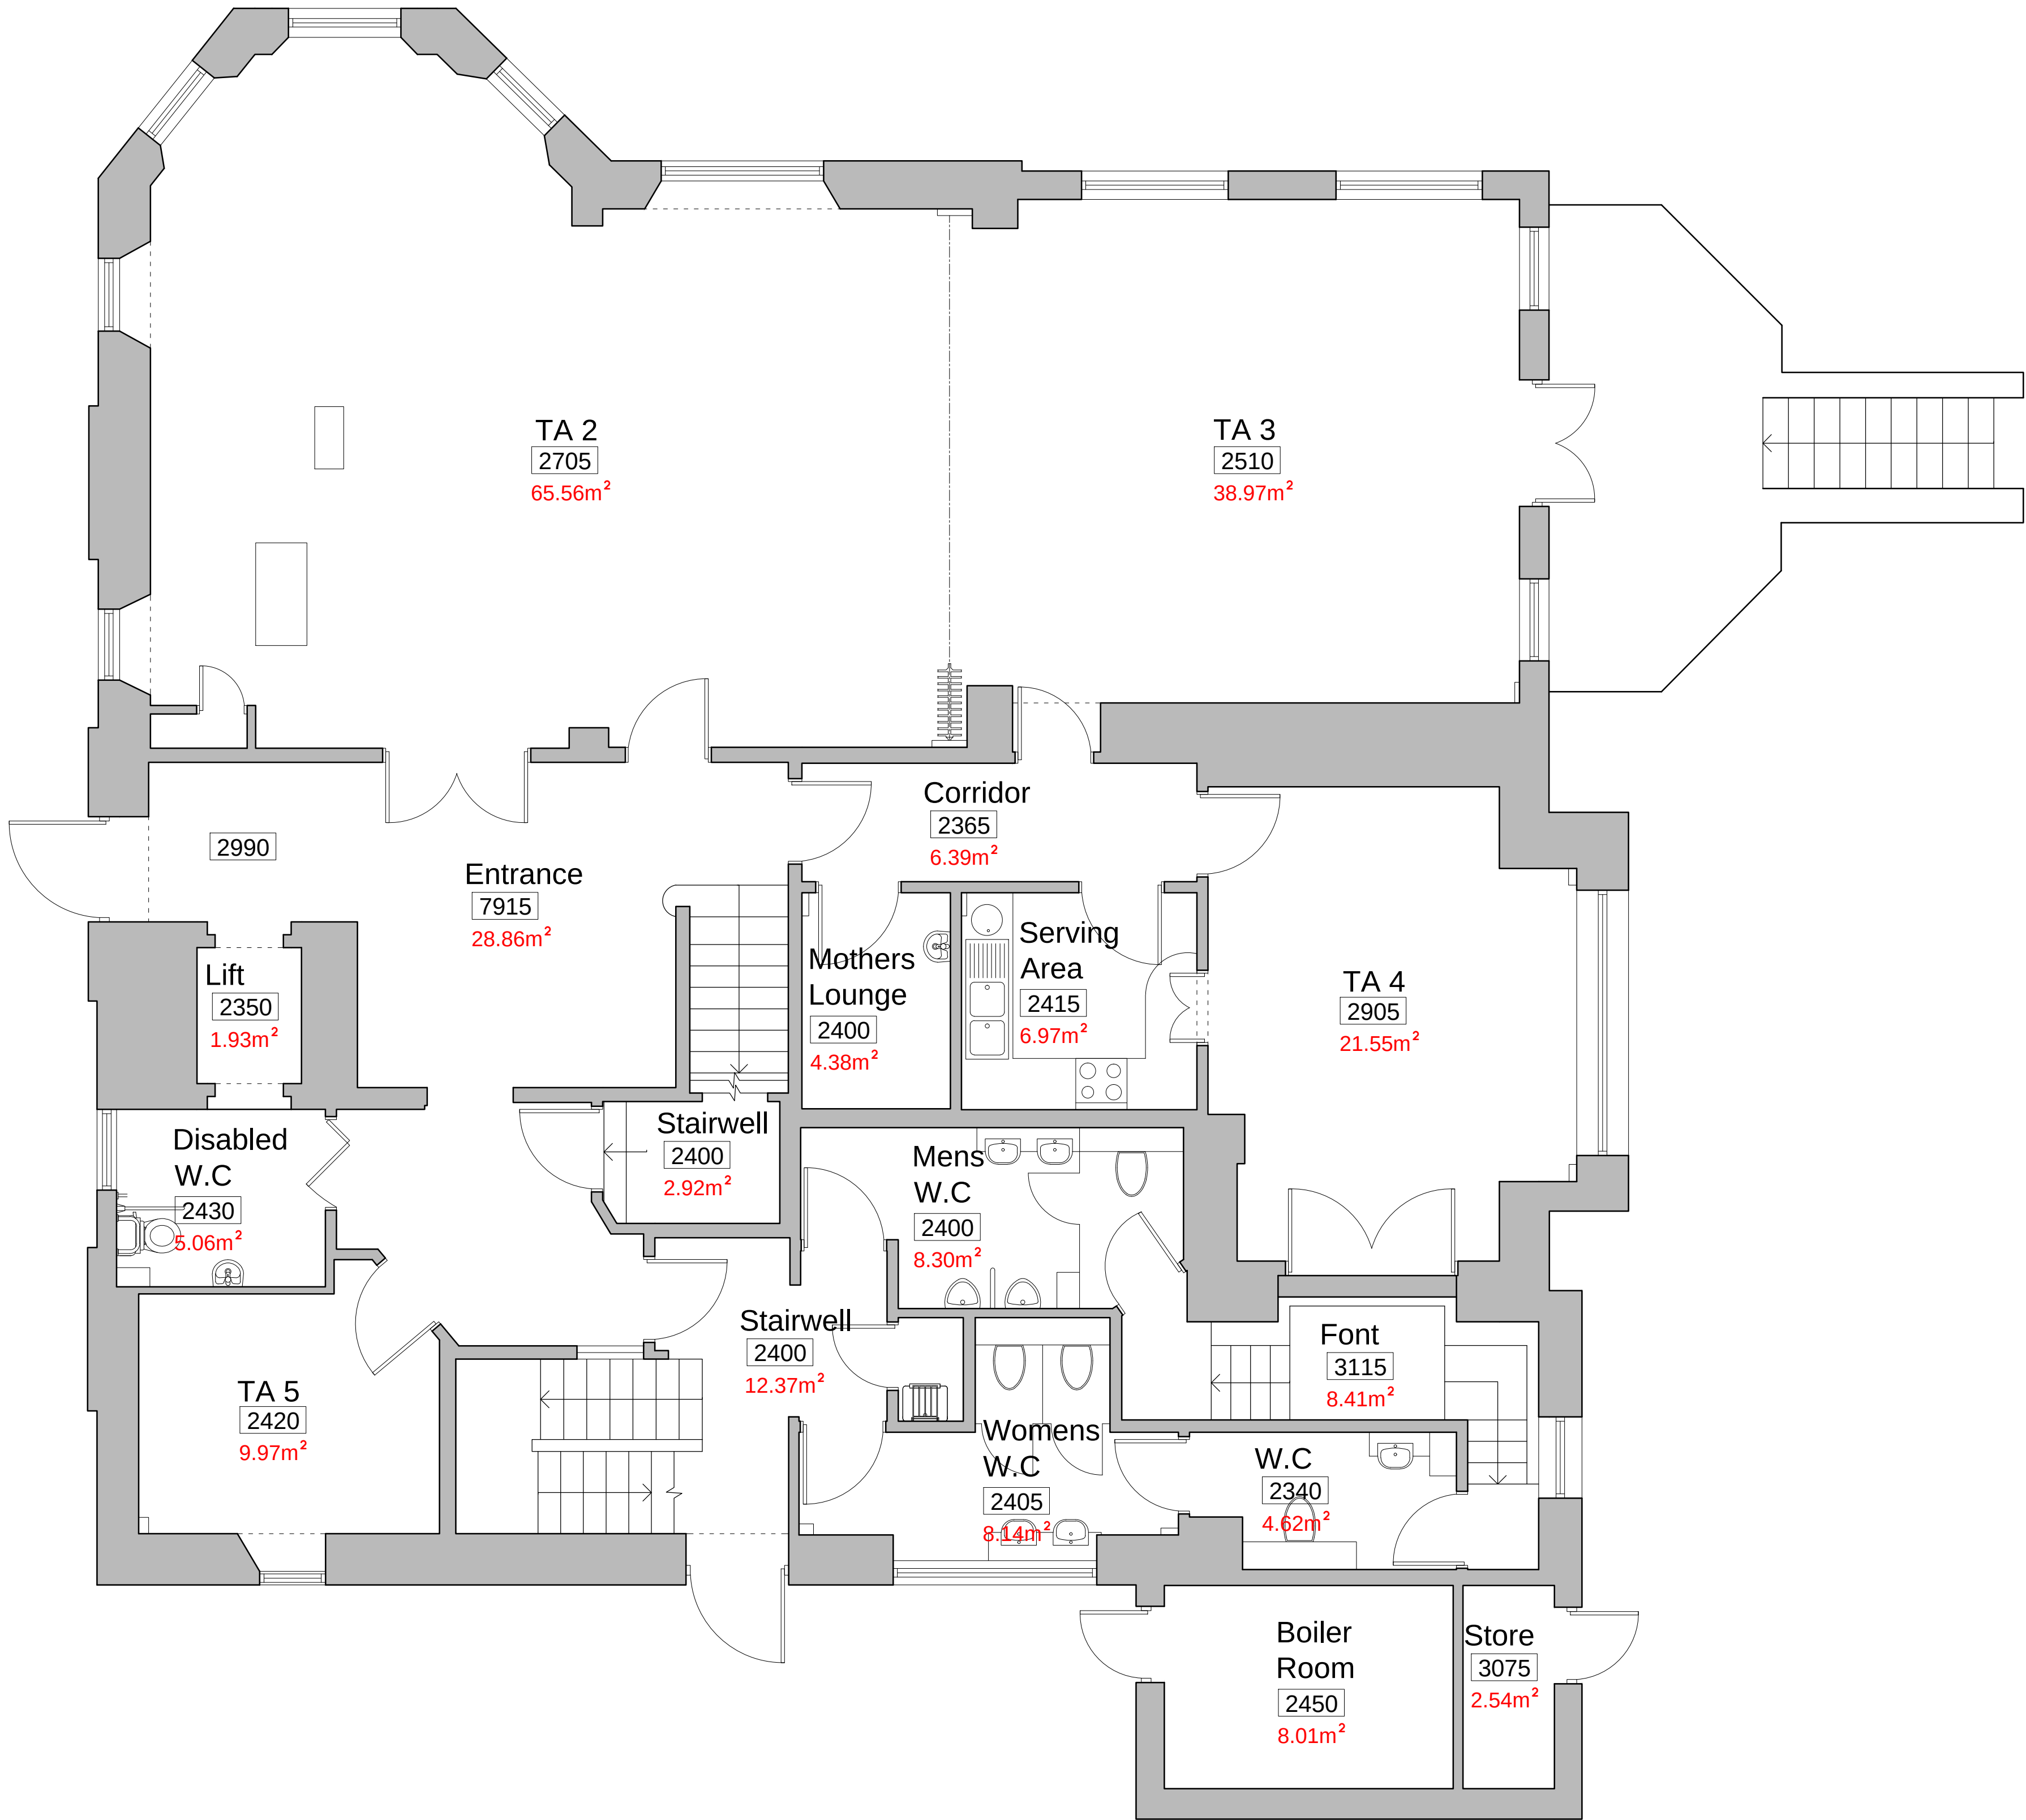

GROUND FLOOR PLAN
GEA = 328.22m²

SDA
Architecture

RIBA 
Chartered Practice

The Old Post Office
34 Wellington Road
Oxton
Wirral
CH43 2JF

Tel: 0151-651-1789
e-mail: admin@sdaarchitecture.com
Web: www.sdaarchitecture.com

PAIGNTON

THE CHURCH OF
JESUS CHRIST
OF LATTER-DAY SAINTS

Project Location	Project Description
9 Belle Vue Road Paignton TQ4 6ES	Measured Survey

Drawing Title	
Ground Floor Plan	
Drawn By:	Scale @ A1:
A Dore	1:50
Date:	Revision:
09.06.2016	--
Project Ref:	Drawing No:
96_2016	96_2016_04

