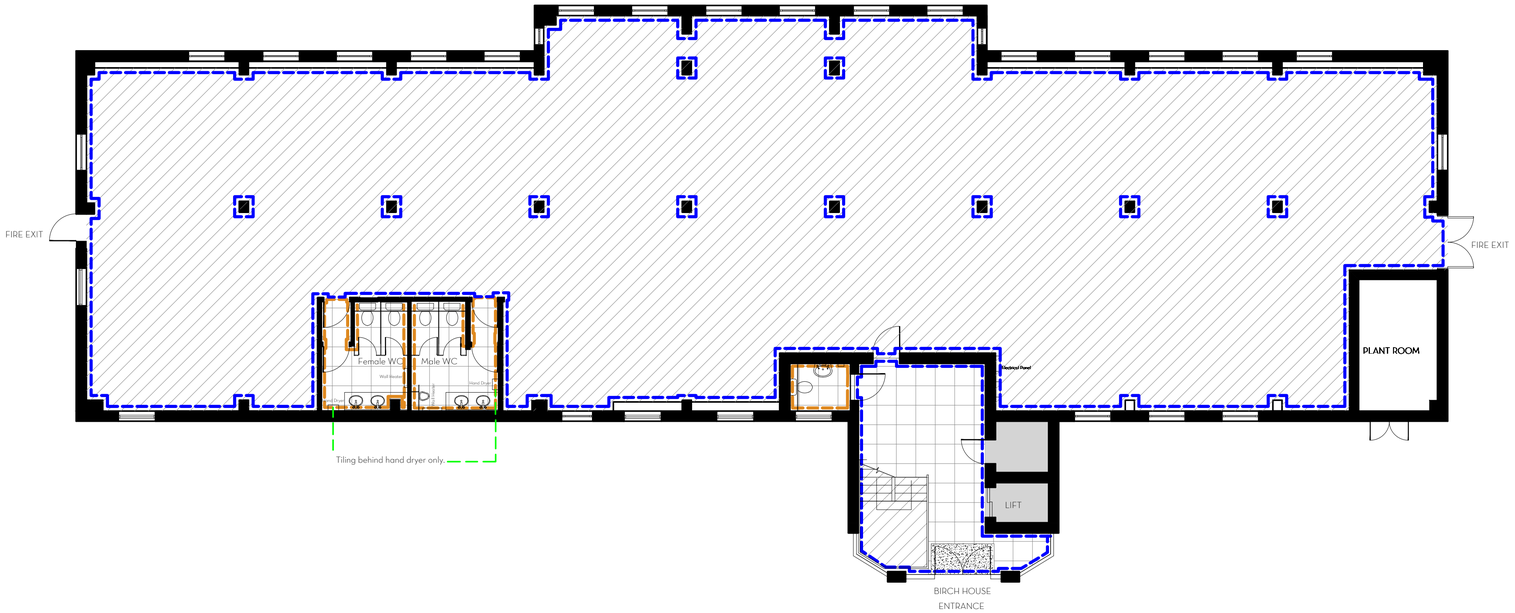

Flooring Key

Some symbols shown may not appear on the drawing or scope of works

General Carpet Throughout
Manufacturer: Desso
Range: Grain
Colour: B867-9501
Size: 500x500mm
Lay Method: Quater Turn

WC and Main Entrance Tile Flooring
Manufacturer: Johnson Tiles
Range: Atrium
Category: Concrete
Colour: Pumice
Product Code: ARTM3G
Size: 592mm X592mm X 10mm
Grout: 2mm Mapei 112 Medium Grey
Upstand: Artium

Entrance Matting: Carpet & Flooring
Range: CFS Matting Matrix Tile
Product Code: CFSMATRT
Finish: Charcoal
Tile Size: 50cm x 50cm
Total Height: 7.60mm

Decorations Key

General paint throughout unless otherwise noted

General Paint Throughout
Manufacturer: Dulux Trade
Brilliant White Emulsion Paint

WC Paint
Manufacturer: Dulux Trade
Easycare Bathroom Soft
Sheen Washable Paint Pure
Brilliant White

Please Note:

Previously painted gloss work to be white oil based satin paint

Reception metal work handrails, stair underside, balustrades
prep and apply 2 full satin metal paint works - Mid Grey

REV	DESCRIPTION	BY	DATE
02	As Built	LL	26/04/2022

Project
Woodland Midland, Birch House

Address
Birch House
Woodlands Business Park
Milton Keynes MK14 6EW

interaction
The Vaults, 1 Bartlett Street, Bath, BA1 2QZ
01225 485 600 | info@interaction.uk.com
interaction.uk.com

Drawing Title
Flooring, Decoration Layout
Ground Floor

Drawing Number
100-OG.02

Project Number	Floor	Drawing
B1678	OG	GA

Drawing Status	Revision
As Built	02

Drawing Scale	Drawn by	Checked by	Date
1:100 @ A1	LL	MP	07/01/2022

Drawings are the sole property of Interaction, and may not be used, transferred, or disclosed to a third party without the express permission of Interaction. Do not scale from this drawing. Contractor to verify all dimensions, levels, and components on-site. Any discrepancies shall be addressed in writing to Interaction prior to the commencement of the work, otherwise the Contractor shall bear full responsibility for any associated cost. This drawing is to be read in conjunction with all other documentation. Building parameters taken from as built drawings provided. Check survey undertaken only, subject to statutory approval. All dimensions shown are in millimetres unless otherwise shown.