
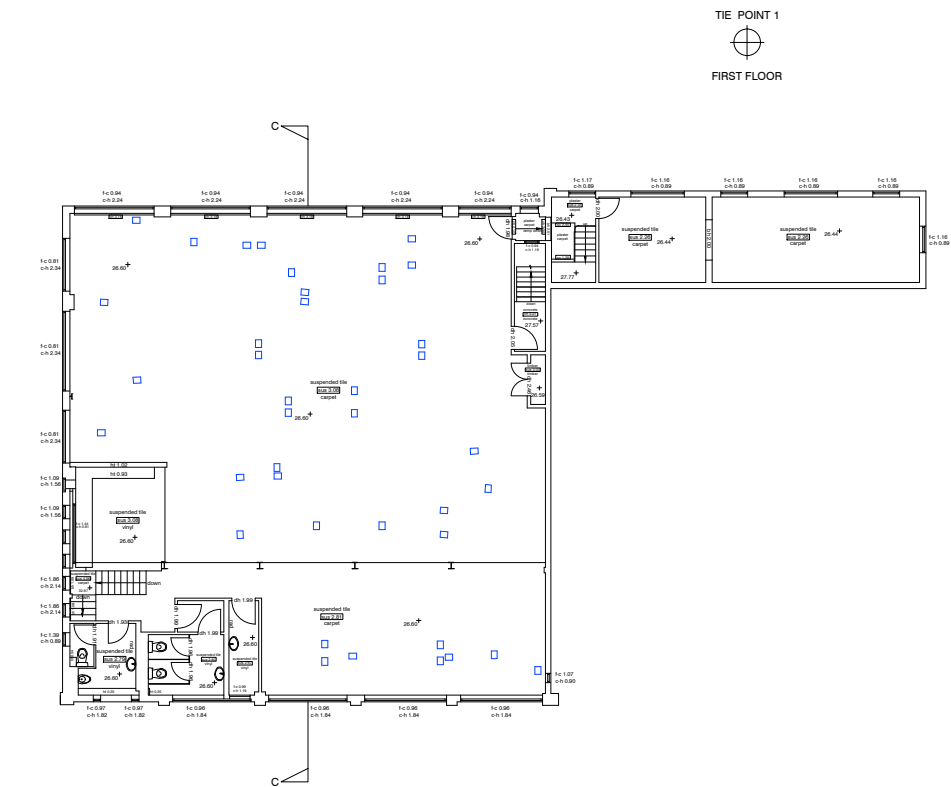


- Symbol & Abbreviation Key**
- SANITARY (INDICATIVE ONLY)**
- WC
 - BIKET
 - URINAL
 - WASH HAND BASIN
 - SINK
 - SILUCE
 - SINK & DRAINER
 - SHOWER TRAY
 - BATH
- ANNOTATION**
- arch: ARCH HEIGHT
 - spring: SPRINGER HEIGHT
 - beam: BEAM HEIGHT TO UNDERSIDE
 - underside
 - door: DOOR HEIGHT
 - floor: FLOOR TO CELL HEIGHT
 - cell: CILL TO HEAD HEIGHT
 - ceiling: CEILING HEIGHT
 - highest: HIGHEST / LOWEST POINT OF SLOPING CEILING
 - suspended: SUSPENDED CEILING HEIGHT
- OTHER ABBREVIATIONS**
- air: AIR CONDITIONING UNIT
 - boiler
 - cooker
 - cupboard
 - electrics
 - floor: FLOOR BOARDS (SYMBOL INDICATES BOARD DIRECTION)
 - fire: FIREPLACE
 - pipe: PIPE RISER
 - radiator
 - roof: ROOF LIGHT
 - roller: ROLLER SHUTTER DOOR
 - tank

Notes.
Levels related to topographical survey 170505.

Rev	Details of Revision	Drawn	Date

Surveyed	Drawn	Date	Checked	Date	Approved	Date
AS	AS	02/07/17	NGT	11/07/17	NGT	16/07/17

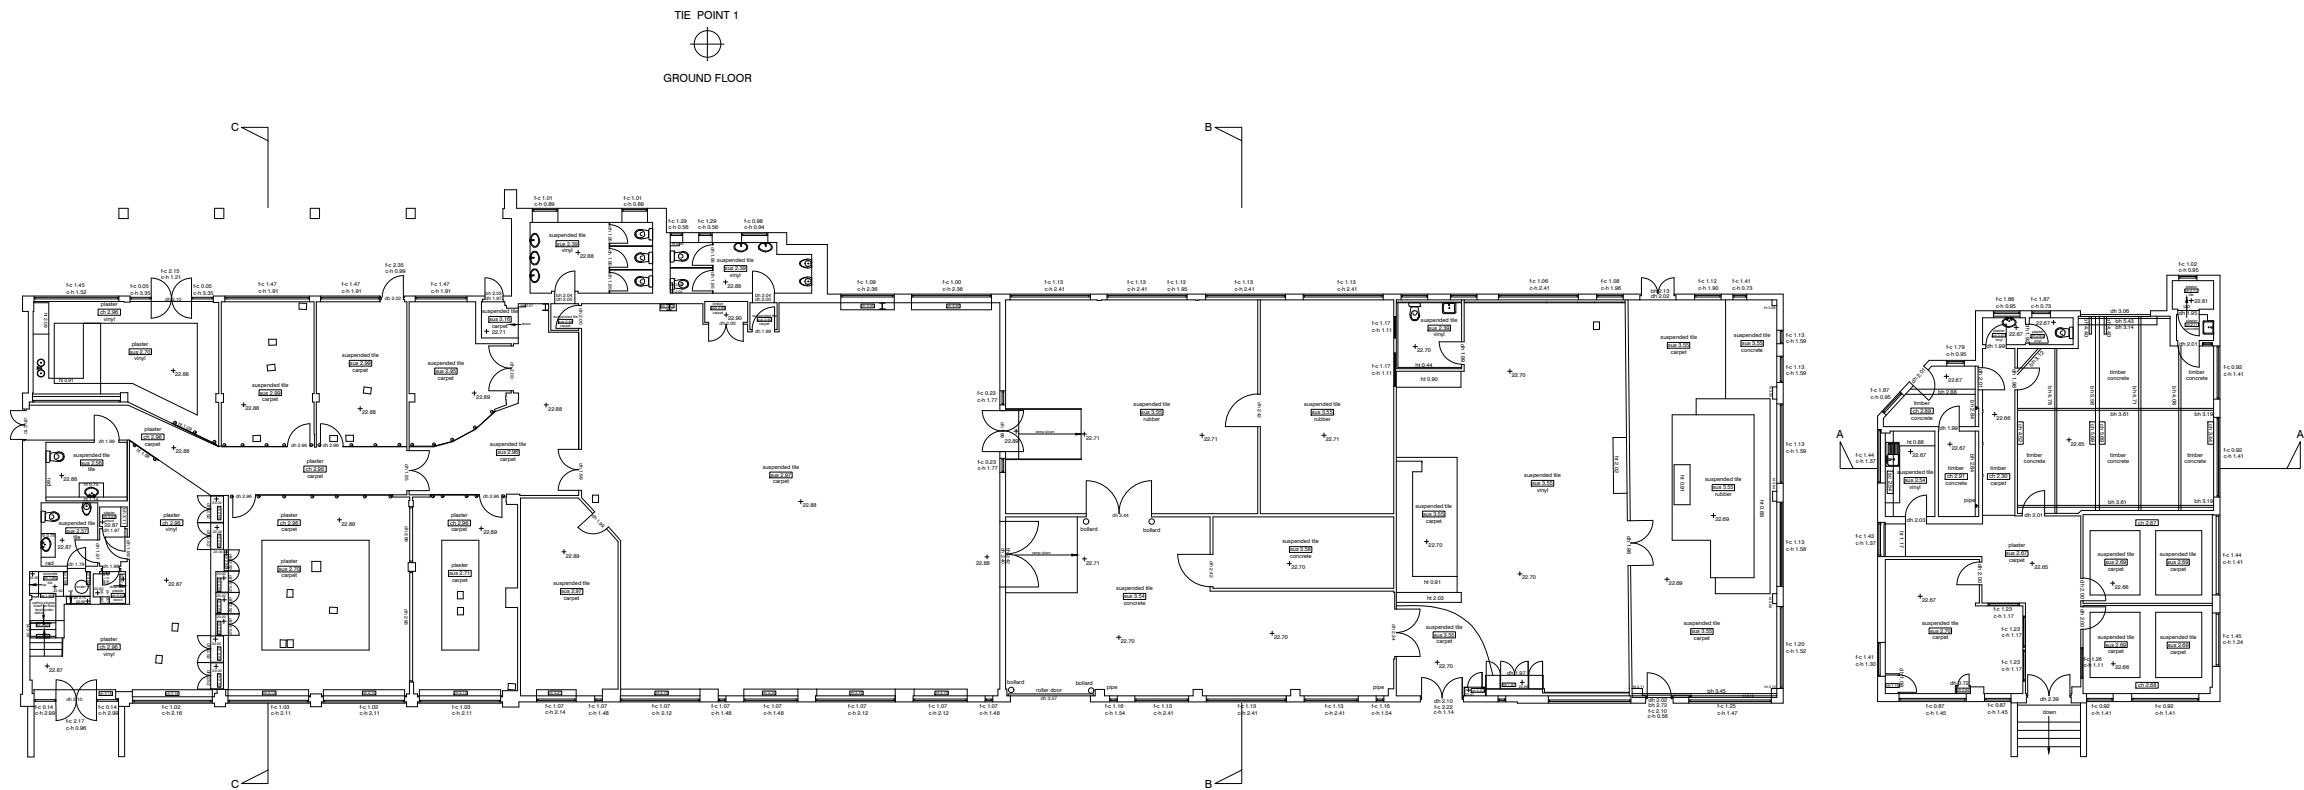

Interlocks Surveys Limited
St. Andrews House
Radford Semele
Leamington Spa
Warwickshire
CV31 1TF

T: 01926 330123
F: 01926 330120
E: info@interlocksurveys.co.uk

Client.
MDR ASSOCIATES
9 HOLYROOD STREET
LONDON
SE1 2EL

Title.
MEASURED BUILDING
8 HAILECORN AVENUE
BRENTFORD
TW8 9EW