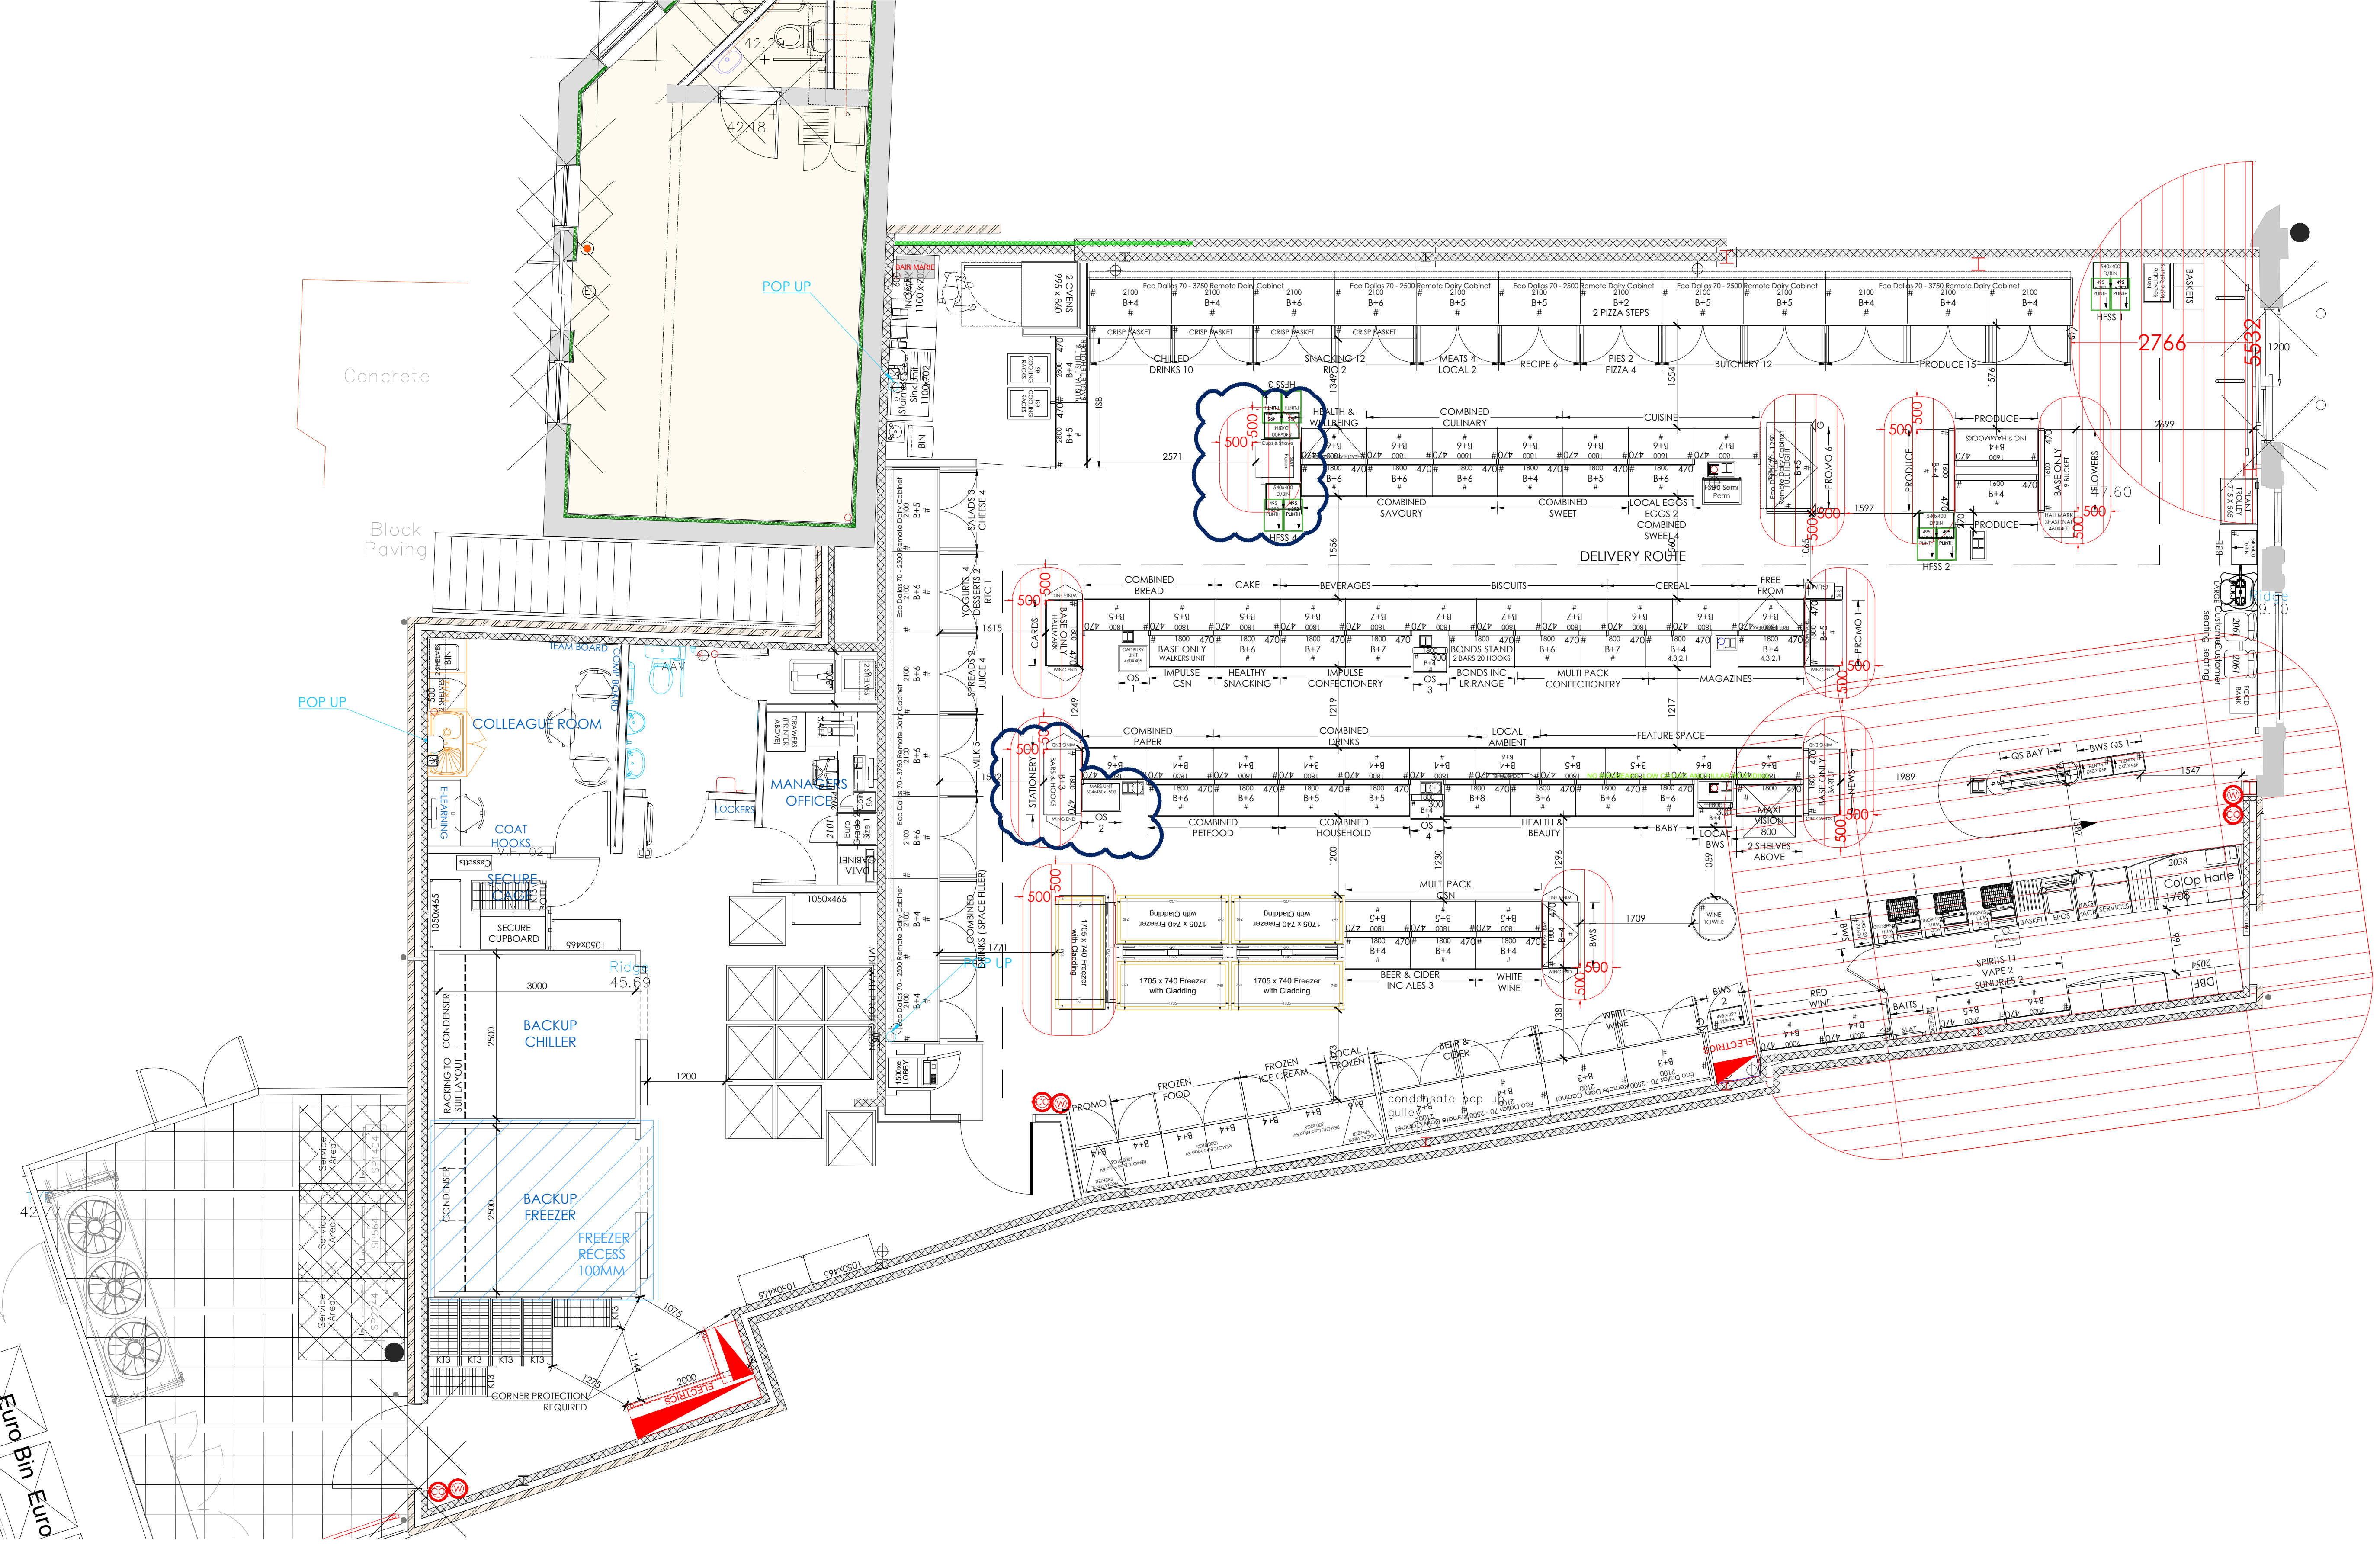


PHASE 3 - MERCH

BLOCK PLAN SENT TO MERCHANDISING	DATE
MERCH SCHEME APPLIED	
NOTES	

DOOR ARC 0.03 X 255 = 7.65m
Square root 7.65m = 2766mm (RADIUS)
Arc Diameter = 5532mm

DATE APPROVED	
NOTES	
PREMISE LICENCE CONDITION:	

THIS DRAWING IS THE COPYRIGHT OF THE SOUTHERN CO-OPERATIVE AND MAY NOT BE COPIED, ALTERED OR REPRODUCED IN ANY FORM, OR PASSED TO A THIRD PARTY WITHOUT THE WRITTEN CONSENT OF THE SOUTHERN CO-OPERATIVE.

DO NOT SCALE FROM THIS DRAWING, EXCEPT FOR PLANNING PURPOSES. USE FIGURED DIMENSIONS ONLY.

DIMENSIONS SHOULD BE CHECKED AND VERIFIED ON SITE AND ANY DISCREPANCIES SHOULD BE REPORTED TO THE DESIGNER.

IF IN DOUBT ASK FOR CONFIRMATION.

AREA SIZE	SPACE m ²	SPACE ft ²
SALES	255	2744
BOH	95	1022
GROSS	354	3810
FIRST FLOOR	NA	NA
SUB LET SPACE	NA	NA
MOTHBALLED	NA	NA

REVISIONS

REV	DESCRIPTION	DRAWN	CHKD	DATE
1ST	MERCH PLAN	RY	**	08/08/2019
A	OS UPDATED	RY	**	12/11/2019
B	OS SEAT INSTALL	RY	**	07/01/2020
C	AMBIENT PRODUCE REVERSE FLOW	RY	**	19/03/2020
D	COOK AS FITTED - SP - MERCH & OS UPDATED	RY	**	27/05/2020
E	LOCAL PRODUCE REMOVED	RY	**	11/11/2020
F	BWS OS 4.5.6 REMOVED	RY	**	01/12/2020
G	SD ADDED	RY	**	10/03/2021
H	SCO AS FITTED - MD - PROMO FROZEN & PROFILES	RY	**	23/09/2021
I	DUNKIN DONUTS ADDED	RY	**	10/12/2021
J	COW REMOVED - RIO FSDU TO CHILLER	RY	**	15/02/2022
K	HFSS AS FITTED - RA	RY	**	26/04/2022
L	WARBURTONS RELOCATION	RY	**	30/05/2022
M	CWP AS FITTED - PWS	RY	**	07/06/2022
N	BEDDING PLANTS ADDED / MERCH LABELS AND OIS AMENDED / LOTTERY BLOCK UPDATE	RY	**	28/02/2023
O	LUSSO COFFEE REMOVED - PWS	RY	**	22/03/2023
P	OIS ADDED - BASED UPON COFFEE BEING REMOVED	RY	**	03/04/2023
Q	DUNKIN FSDU REMOVED - MOVED TO ISB / OIS	RY	**	16/05/2023
R	AMENDS	RY	**	
S	OS - BWS OS - VAPE	RY	**	
T	W BLOCK UPDATE	RY	**	
U	SLUSH	RY	**	
V	10TY 800X200 BAY REMOVED	RY	**	
W	10TY SLUSH ADDED	RY	**	
X	20TY OS ADDED	RY	**	

southern coop

Property Department
1000 Lakeside, Western Road, Portsmouth, PO6 3FE
T: 023 9222 2500 | F: 023 9222 2650

ISSUED FOR

MERCH PLAN

ADDRESS
32 HIGH STREET
LYNDHURST
SO43
7BG

DRAWING TITLE
MERCH PLAN

DRAWING SCALE 1:50	SHEET SIZE A1	SHEET No. 1 of 1	DRAWN RY	CHKD **	DATE 20-05-2019
DRAWING NUMBER SC-411-V1-GF-DR-K-0002					REVISION X