




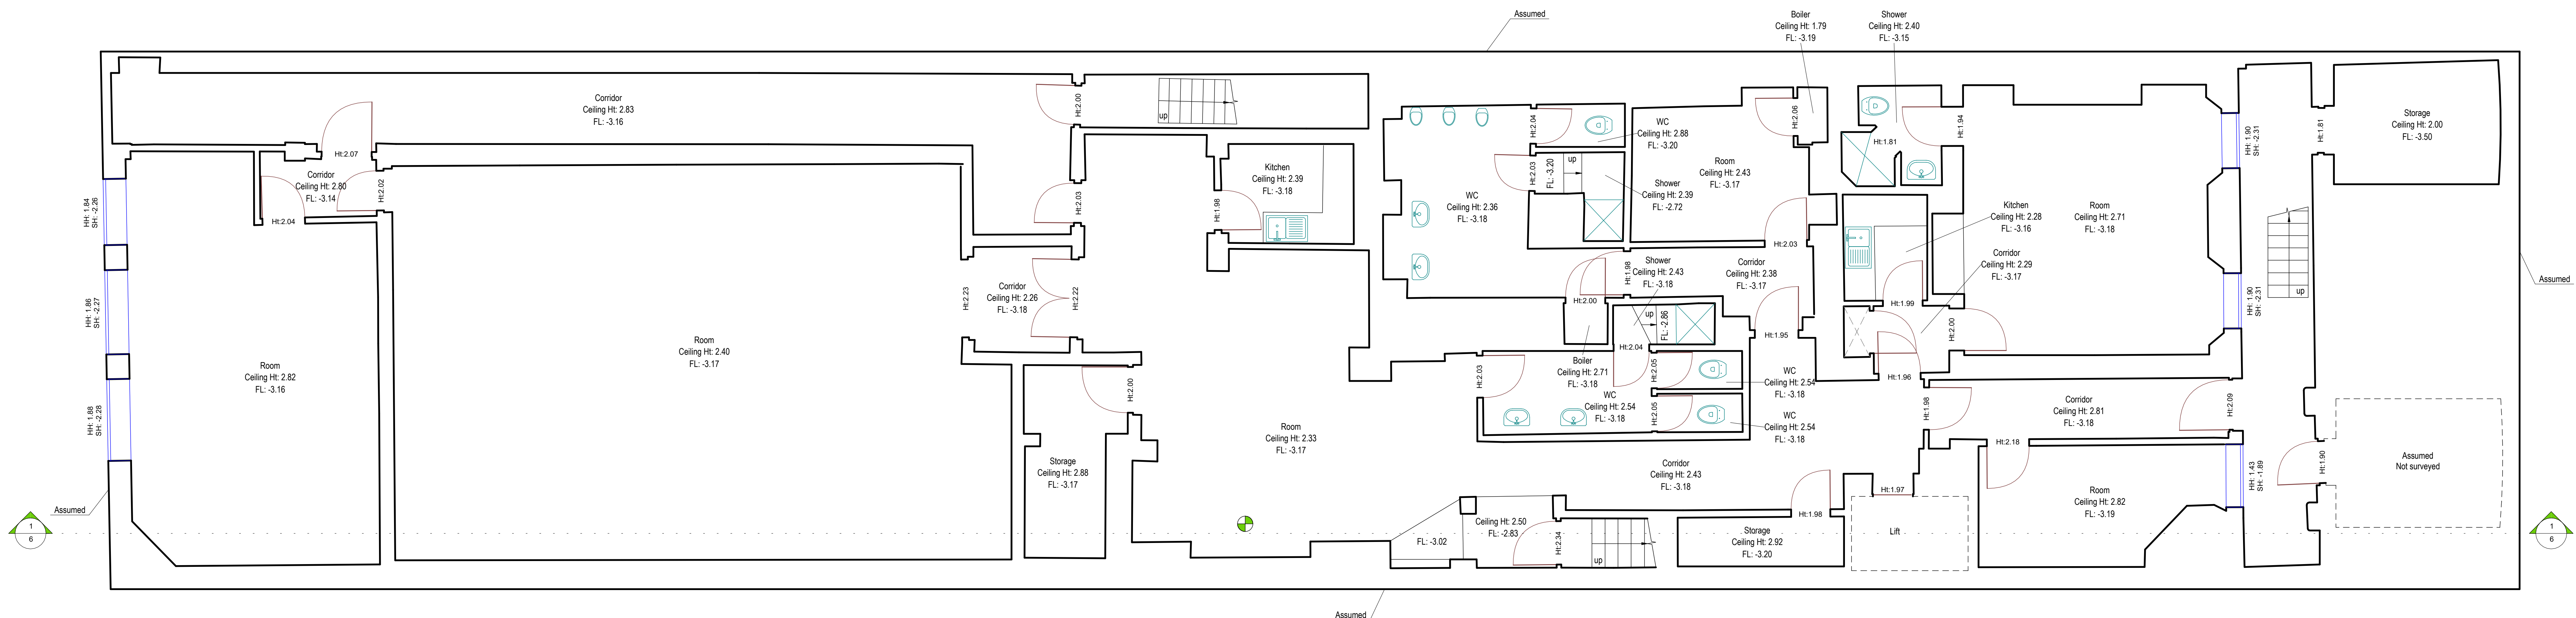

1 Existing Basement Floor
1 : 50

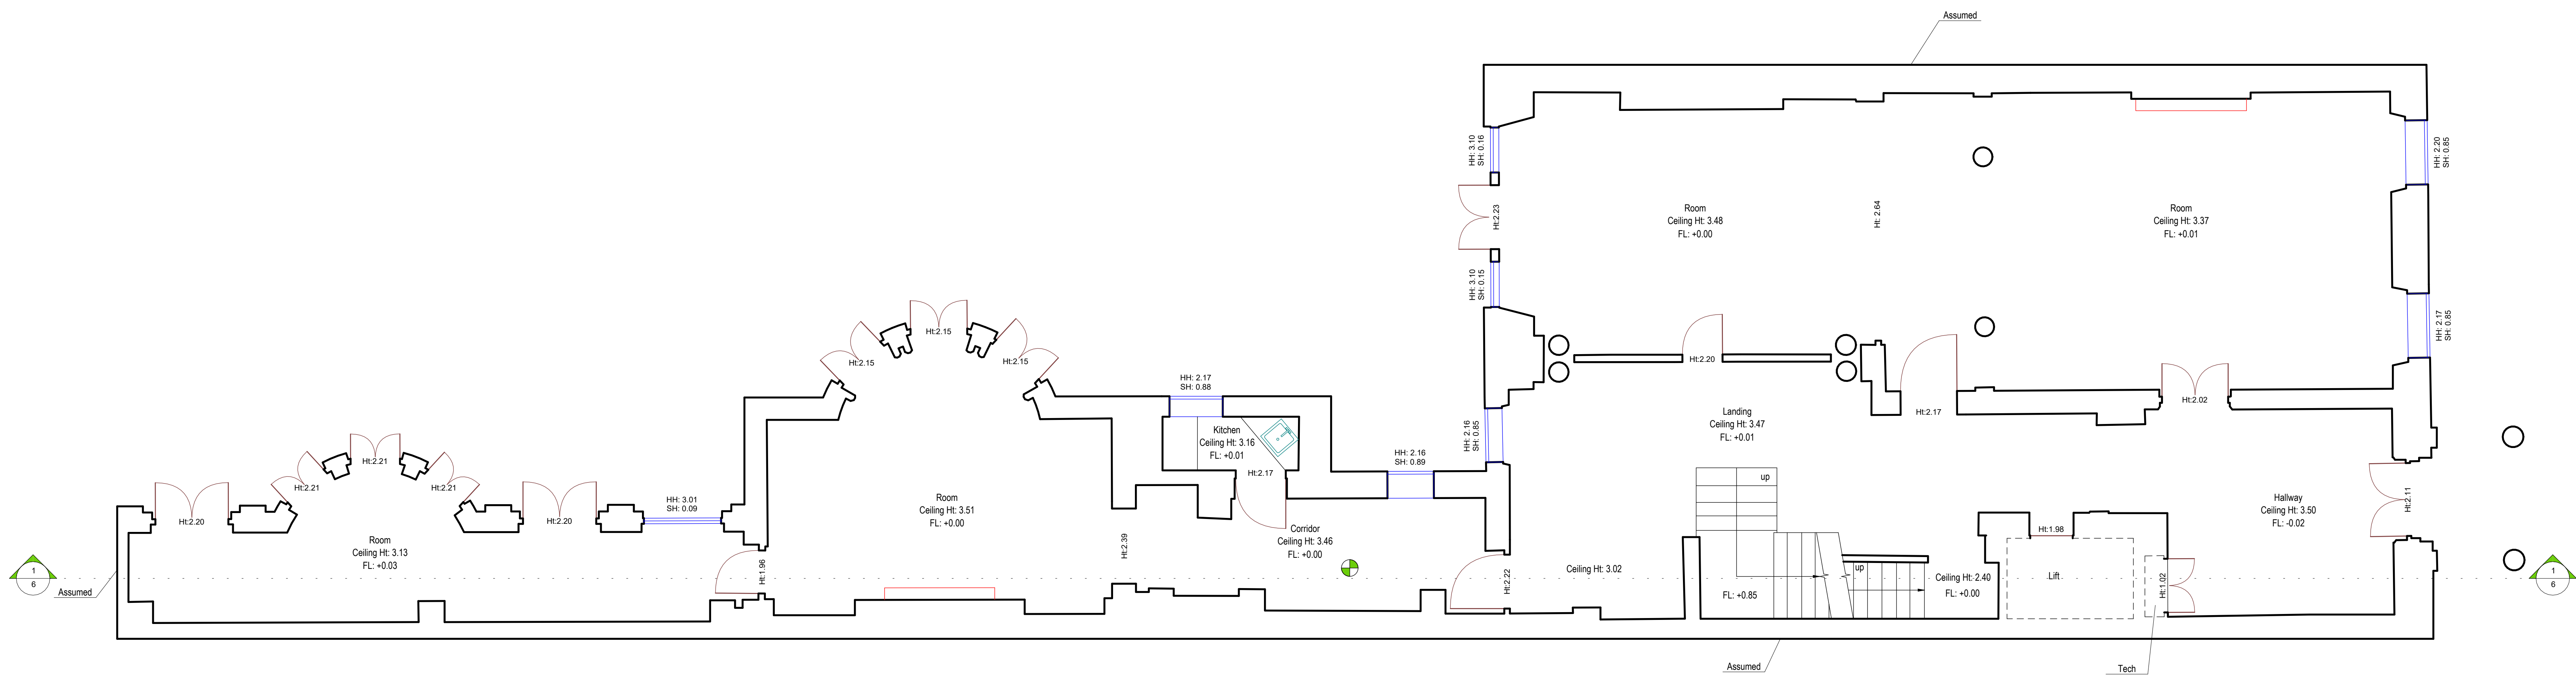

2 Existing Ground Floor
1 : 50

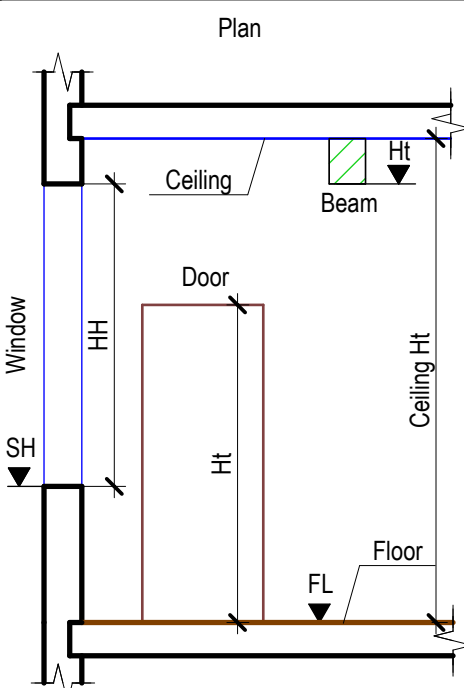

- Beam on plan view
- Fireplace
- Built-in storage
- Shower
- Ceiling hole, Ceiling level change

- Elevation
- Roof

- Section
- Ceiling
 - Floor

- Site plan
- Outline of a neighboring bld.
 - Fence
 - Landscaping
 - Manhole

- Abbreviations
- FL - Floor Level
 - HT - Leaf Height (Door)
 - HT - Bottom Level (Beam)
 - SH - Window Sill Level
 - HH - Window Height
 - TL - Top Level
 - BL - Bottom Level
- Section Number
- Sheet Number
- Coordination Point

- Notes
- All information contained in this drawing should be checked and verified prior to any fabrication or construction.
 - Any discrepancies between this drawing and any other information should be reported to Measured Survey Pro within 60 days after the native CAD DWG drawings are released.

Project number
MS - 152020 - 18508

Project address
43 Upper Grosvenor St, London, W1K 2NJ

Description
Existing 1st Floor

Drawn
S K

Checked
C P

Scale bar
0 1 2 3

Scale
1:50

Format
A2

Sheet Nr
2

Assumed

Room
Ceiling Ht: 3.64
FL: +3.81

Room
Ceiling Ht: 3.78
FL: +3.80

HH: 3.03
SH: 4.25

HH: 3.04
SH: 4.24

HH: 3.04
SH: 4.24

Landing
Ceiling Ht: 3.78
FL: +3.80

Corridor
Ceiling Ht: 2.74
FL: +3.81

Room
Ceiling Ht: 3.59
FL: +3.84

Corridor
Ceiling Ht: 3.52
FL: +3.79

Room
Ceiling Ht: 3.54
FL: +3.79

Corridor
Ceiling Ht: 3.82
FL: +3.81

Ceiling Ht: 3.50

WC
Ceiling Ht: 3.50
FL: +3.83

WC
Ceiling Ht: 2.66
FL: +3.87

HH: 1.79
SH: 4.73

HH: 1.81
SH: 4.69

HH: 3.27
SH: 3.98

HH: 3.27
SH: 3.98

HH: 3.27
SH: 3.98

HH: 2.13
SH: 3.97

Ht: 2.87

Ht: 2.86

Ht: 2.02

Ht: 2.21

Ht: 2.19

Ht: 2.19

Ht: 2.19

Ht: 2.17

Ht: 1.99

Assumed
Ht: 1.97

FL: +5.32

FL: +2.65

Assumed

1
6


1
6

1

Existing 1st Floor

1 : 50

Reference symbol

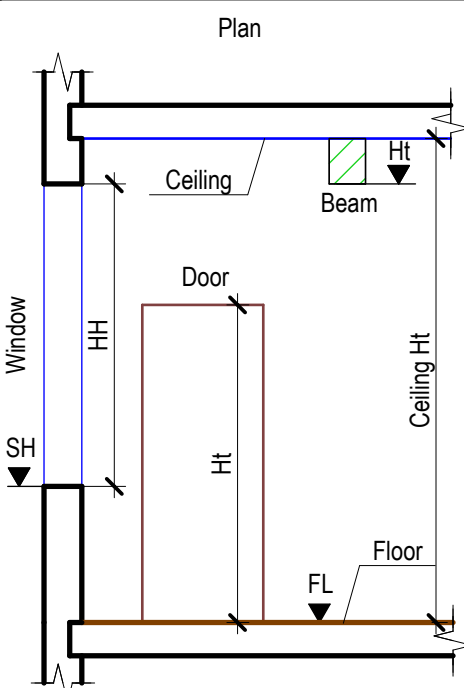

- Beam on plan view
- Fireplace
- Built-in storage
- Shower
- Ceiling hole, Ceiling level change

- Elevation
- Roof

- Section
- Ceiling
 - Floor

- Site plan
- Outline of a neighboring bld.
 - Fence
 - Landscaping
 - Manhole

- Abbreviations
- FL - Floor Level
 - HT - Leaf Height (Door)
 - HT - Bottom Level (Beam)
 - SH - Window Sill Level
 - HH - Window Height
 - TL - Top Level
 - BL - Bottom Level
- Section Number
- Sheet Number
- Coordination Point

Notes

- All information contained in this drawing should be checked and verified prior to any fabrication or construction.
- Any discrepancies between this drawing and any other information should be reported to Measured Survey Pro within 60 days after the native CAD DWG drawings are released.

Project number

MS - 152020 - 18508

Project address

43 Upper Grosvenor St, London, W1K 2NJ

Description

Existing 3rd Floor

Drawn

S K

Checked

C P

Scale bar

0 1 2 3

Scale


1:50

Format

A2

Sheet Nr


4

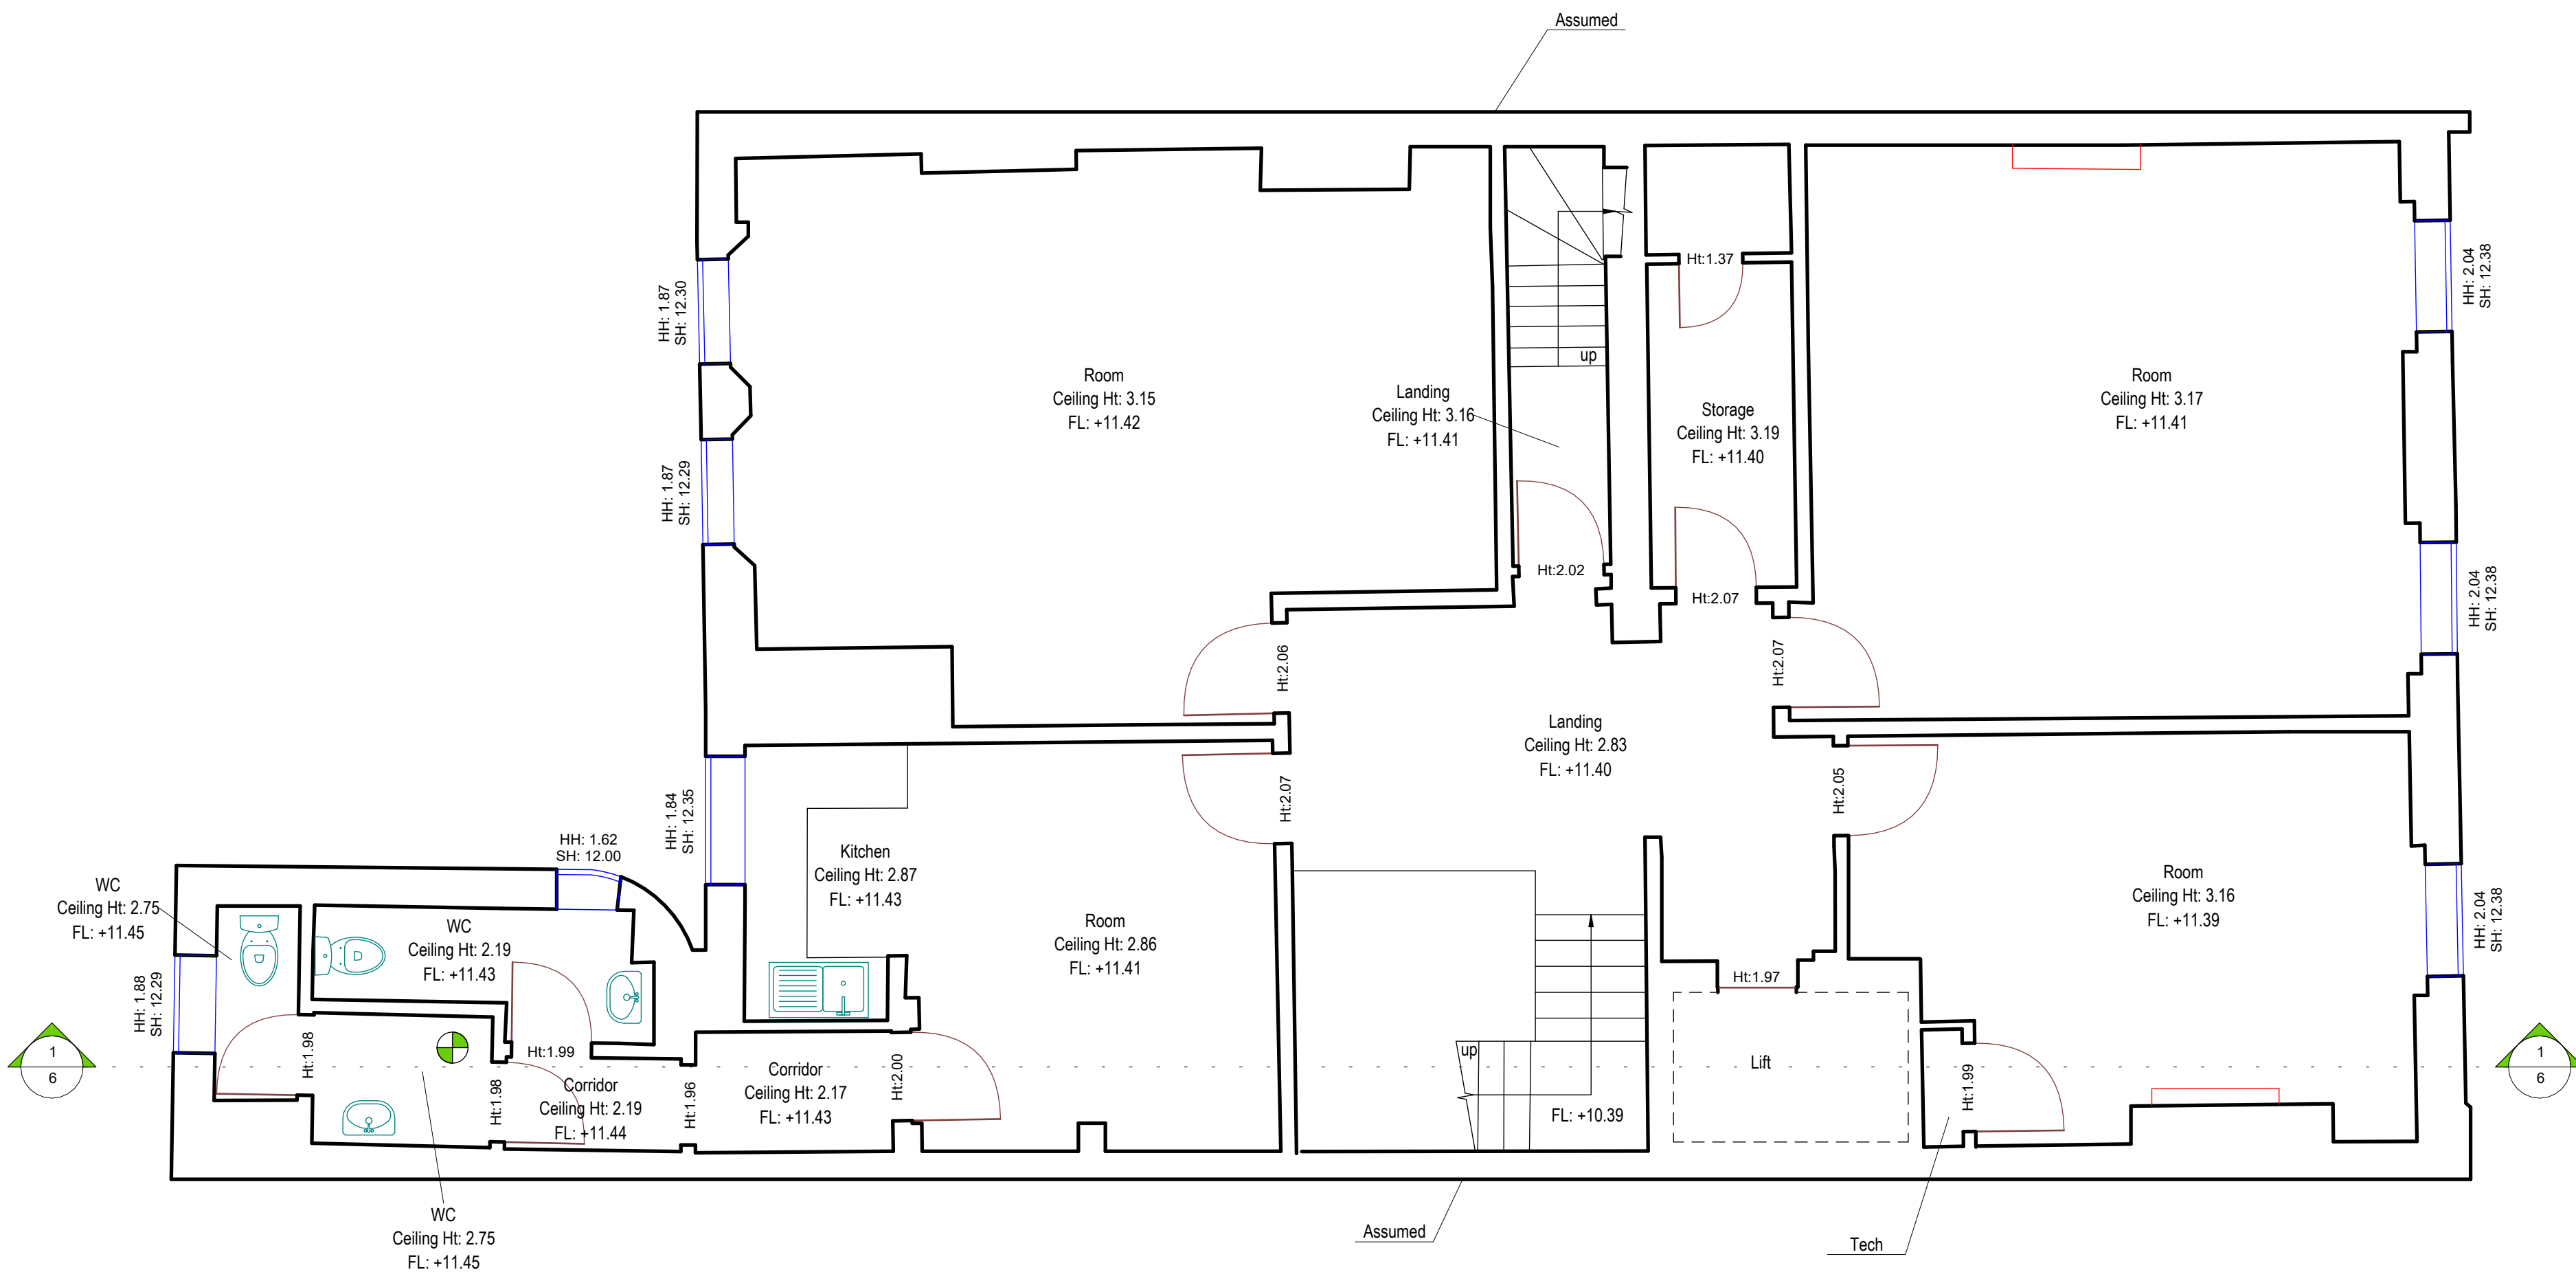

Existing 3rd Floor

1 : 50

Reference symbol

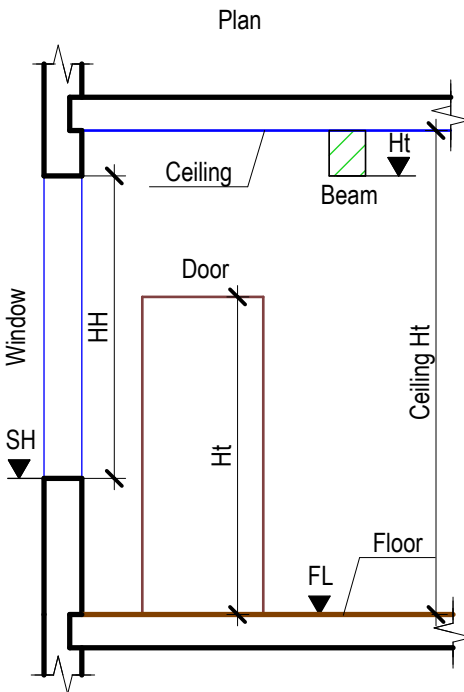

- Beam on plan view
- Fireplace
- Built-in storage
- Shower
- Ceiling hole, Ceiling level change

Elevation

- Roof

Section

- Ceiling
- Floor

Site plan

- Outline of a neighboring bld.
- Fence
- Landscaping
- Manhole

Abbreviations

- FL - Floor Level
- HT - Leaf Height (Door)
- HT - Bottom Level (Beam)
- SH - Window Sill Level
- HH - Window Height
- TL - Top Level
- BL - Bottom Level

Section Number

Sheet Number

Coordination Point

Notes

- All information contained in this drawing should be checked and verified prior to any fabrication or construction.
- Any discrepancies between this drawing and any other information should be reported to Measured Survey Pro within 60 days after the native CAD DWG drawings are released.

Project number

MS - 152020 - 18508

Project address

43 Upper Grosvenor St, London, W1K 2NJ

Description

Existing 4th Floor

Drawn

S K

Checked

C P

Scale bar

0 1 2 3

Scale


1:50

Format


A2

Sheet No

5

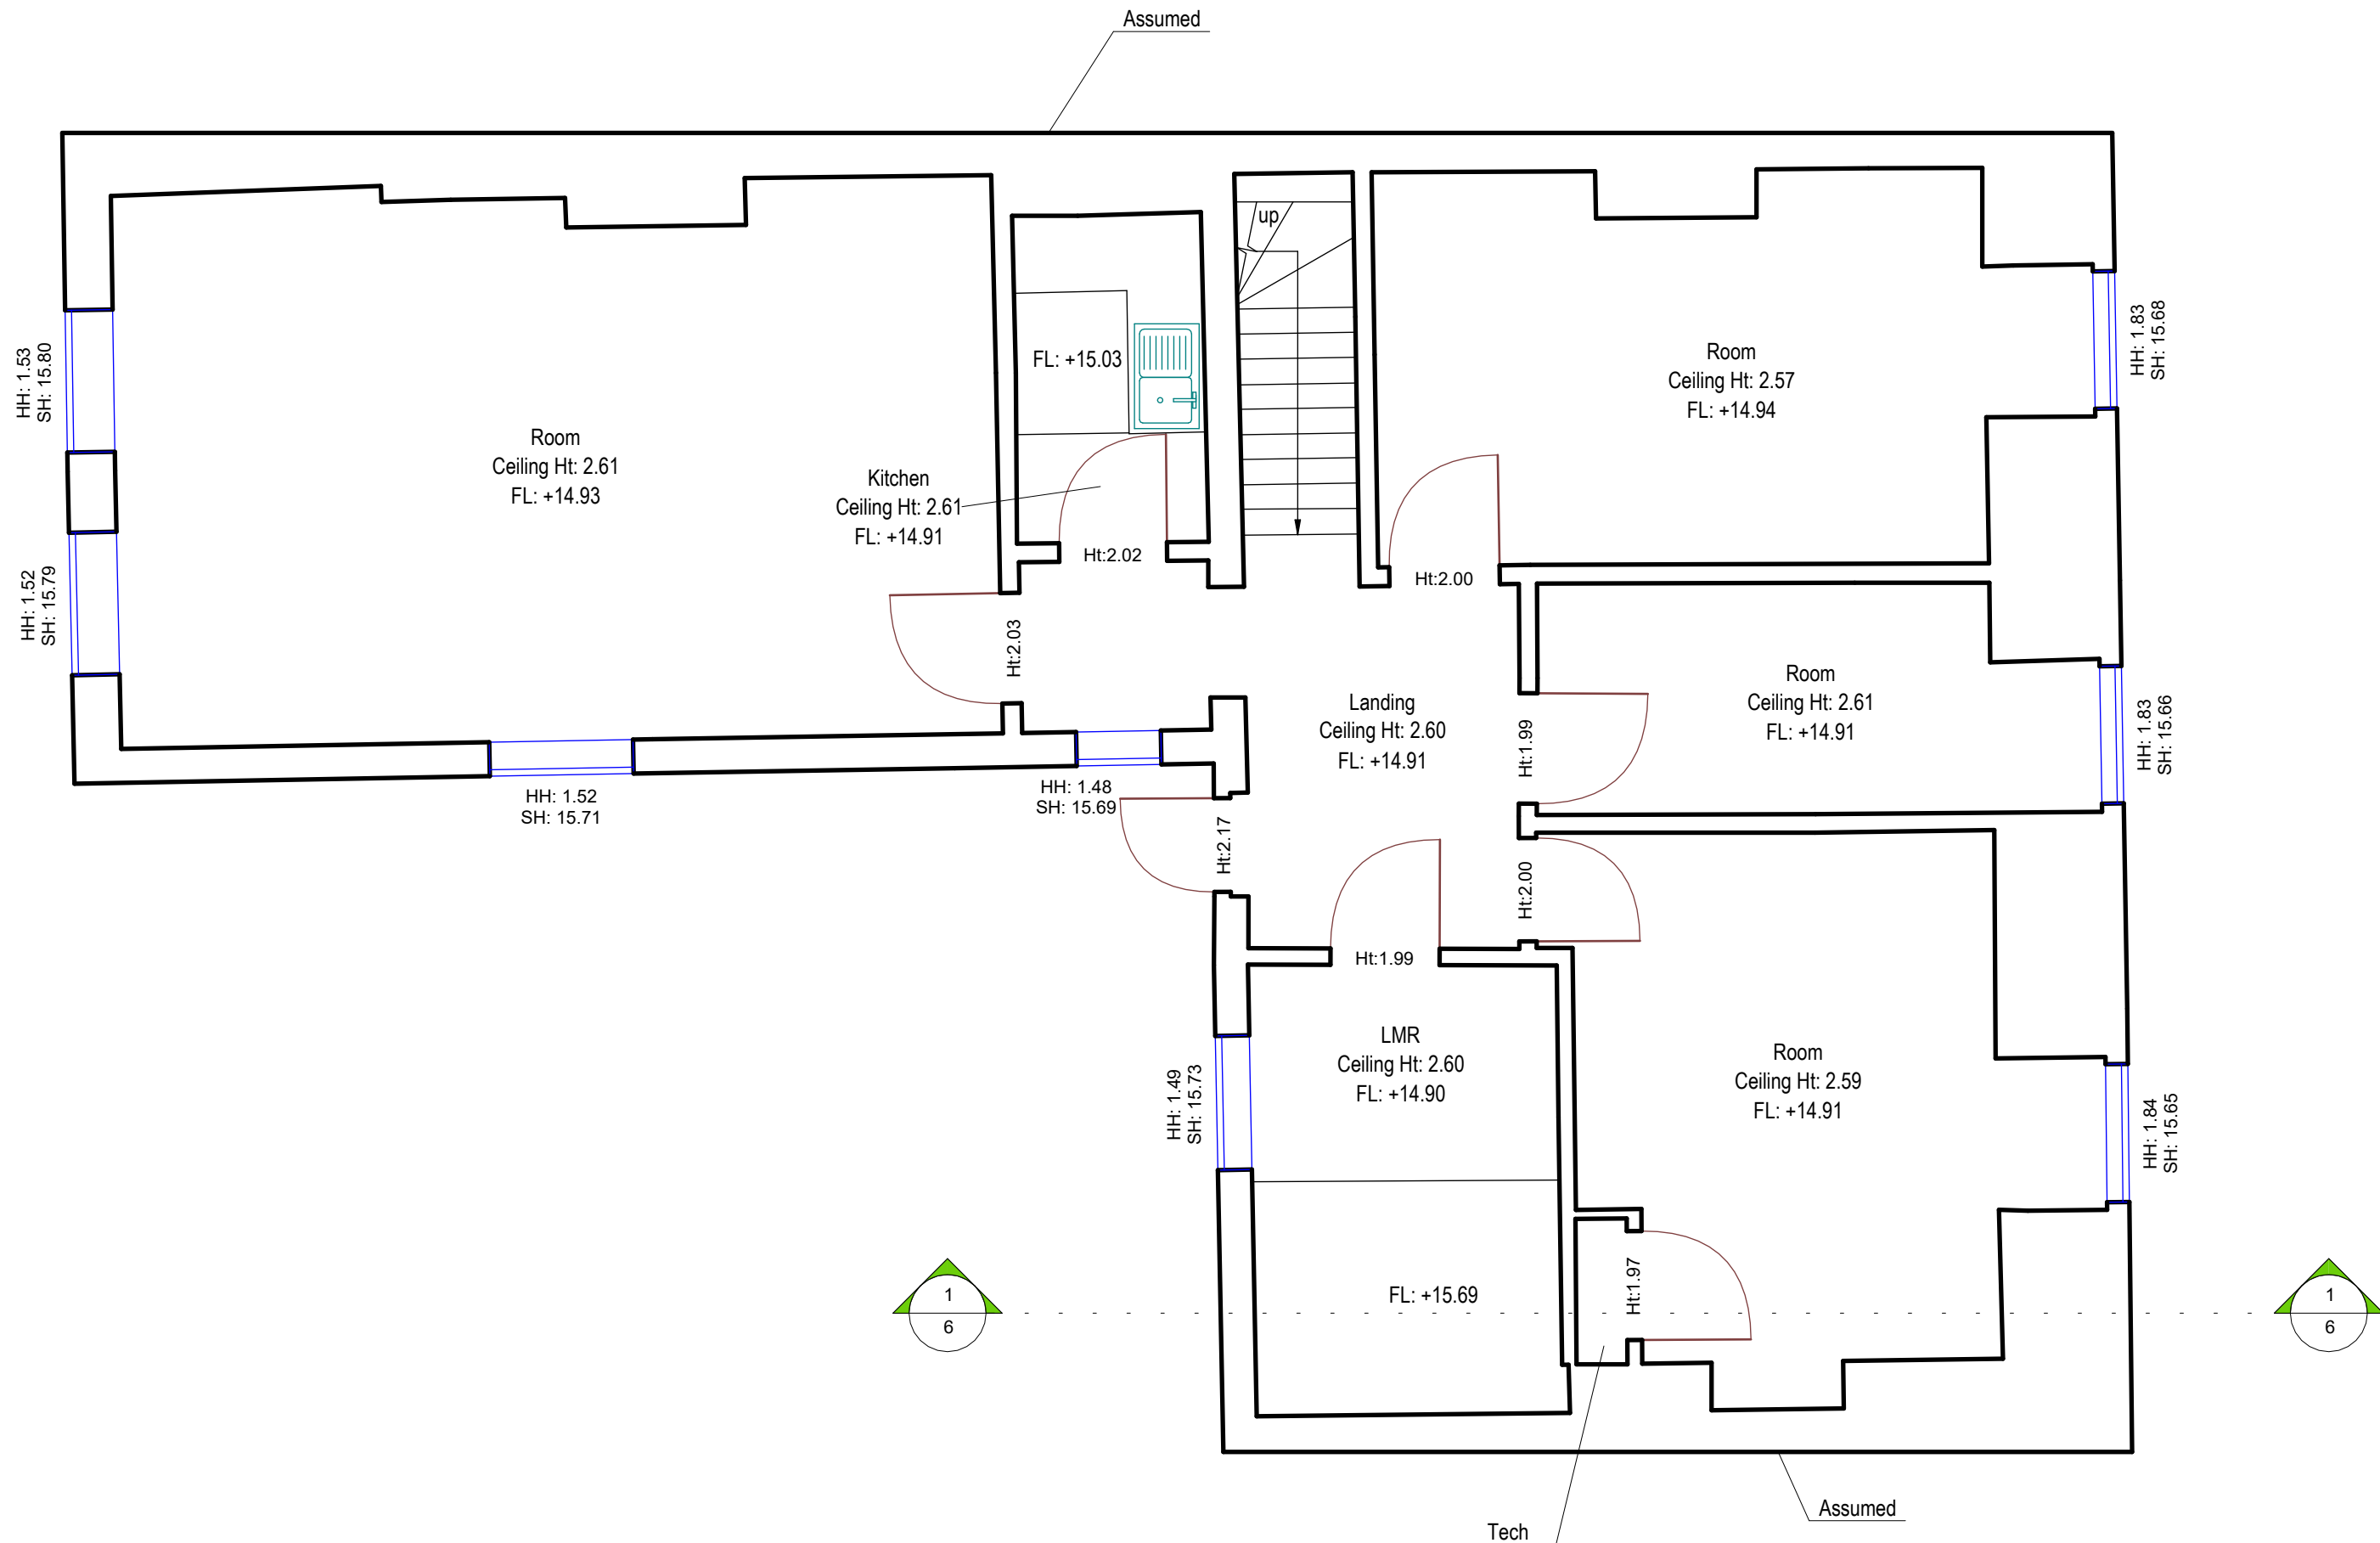

Plan

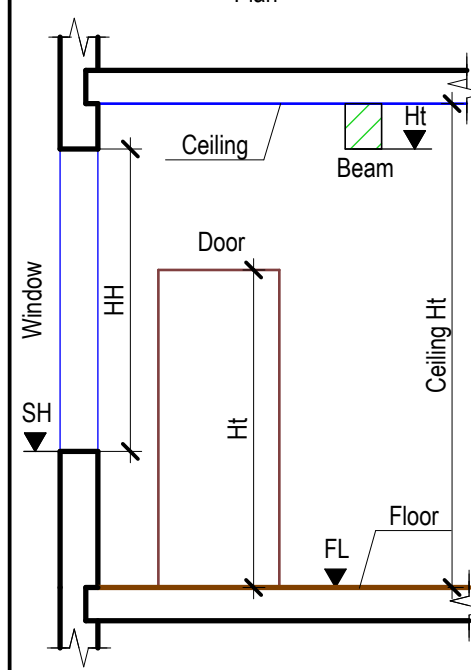

Beam on plan view

Fireplace

Built-in storage

Shower

Ceiling hole, Ceiling level change

Elevation

Section

Site plan

Outline of a neighboring bld.

Fence

Landscaping

Manhole

Abbreviations

FL - Floor Level

HT - Leaf Height (Door)

HT - Bottom Level (Beam)

SH - Window Sill Level

HH - Window Height

TL - Top Level

BL - Bottom Level

Section Number

1

Sheet Number

3

Coordination Point

1 Existing Section 1

1 : 50

All information contained in this drawing should be checked and verified prior to any fabrication or construction.

Any discrepancies between this drawing and any other information should be reported to Measured Survey Pro within 60 days after the native CAD DWG drawings are released.

Project number

MS - 152020 - 18508

Client address

43 Upper Grosvenor St, London, W1K 2NJ

Client name

Existing Section

Scale bar

150

AO

6

Scale


150

AO

6

Reference symbol

Plan

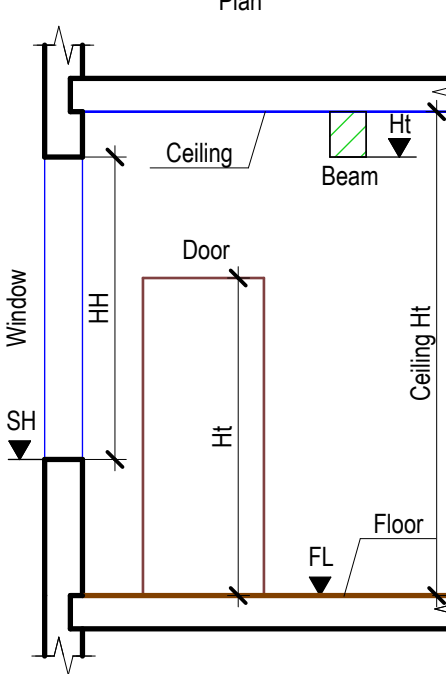

Legend

- Beam on plan view
- Fireplace
- Built-in storage
- Shower
- Ceiling hole, Ceiling level change

Elevation

- Roof

Section

- Ceiling
- Floor

Site plan

- Outline of a neighboring bld.
- Fence
- Landscaping
- Manhole

Abbreviations

FL - Floor Level

HT - Leaf Height (Door)

HT - Bottom Level (Beam)

SH - Window Sill Level

HH - Window Height

TL - Top Level

BL - Bottom Level

Section Number

1

3

Sheet Number

Point

Notes

- All information contained in this drawing should be checked and verified prior to any fabrication or construction.

- Any discrepancies between this drawing and any other information should be reported to Measured Survey Pro within 60 days after the native CAD DWG drawings are released.

Project number

MS - 152020 - 18508

Project address

43 Upper Grosvenor St, London, W1K 2NJ

Description

Existing Elevations

Drawn

SK

Checked

CP

Scale bar

0

1

2

3

Scale

1:50

Format

A1

Sheet No

7



1

Existing Front Elevation

1 : 50



2

Existing Rear Elevation

1 : 50



1 Existing Side Elevation
1 : 50

Reference symbol

Plan

Window
SH
HH
Door
HT
Ceiling
Beam
Ceiling HT
Floor
FL

- Beam on plan view
- Fireplace
- Built-in storage
- Shower
- Ceiling hole, Ceiling level change

Elevation

- Roof

Section

- Ceiling
- Floor

Site plan

- Outline of a neighboring bld.
- Fence
- Landscaping
- Manhole

Abbreviations

FL - Floor Level
HT - Leaf Height (Door)
HT - Bottom Level (Beam)
SH - Window Sill Level
HH - Window Height
TL - Top Level
BL - Bottom Level

Section Number
1
3

Sheet Number
8

Coordination Point

Notes

- All information contained in this drawing should be checked and verified prior to any fabrication or construction.
- Any discrepancies between this drawing and any other information should be reported to Measured Survey Pro within 60 days after the native CAD DWG drawings are released.

Project number
MS - 152020 - 18508

Project address
43 Upper Grosvenor St, London, W1K 2NJ

Description
Existing Elevations

Drawn
SK

Checked
CP

Scale bar
0 1 2 3

Scale
1:50

Format
A1

Sheet No
8