



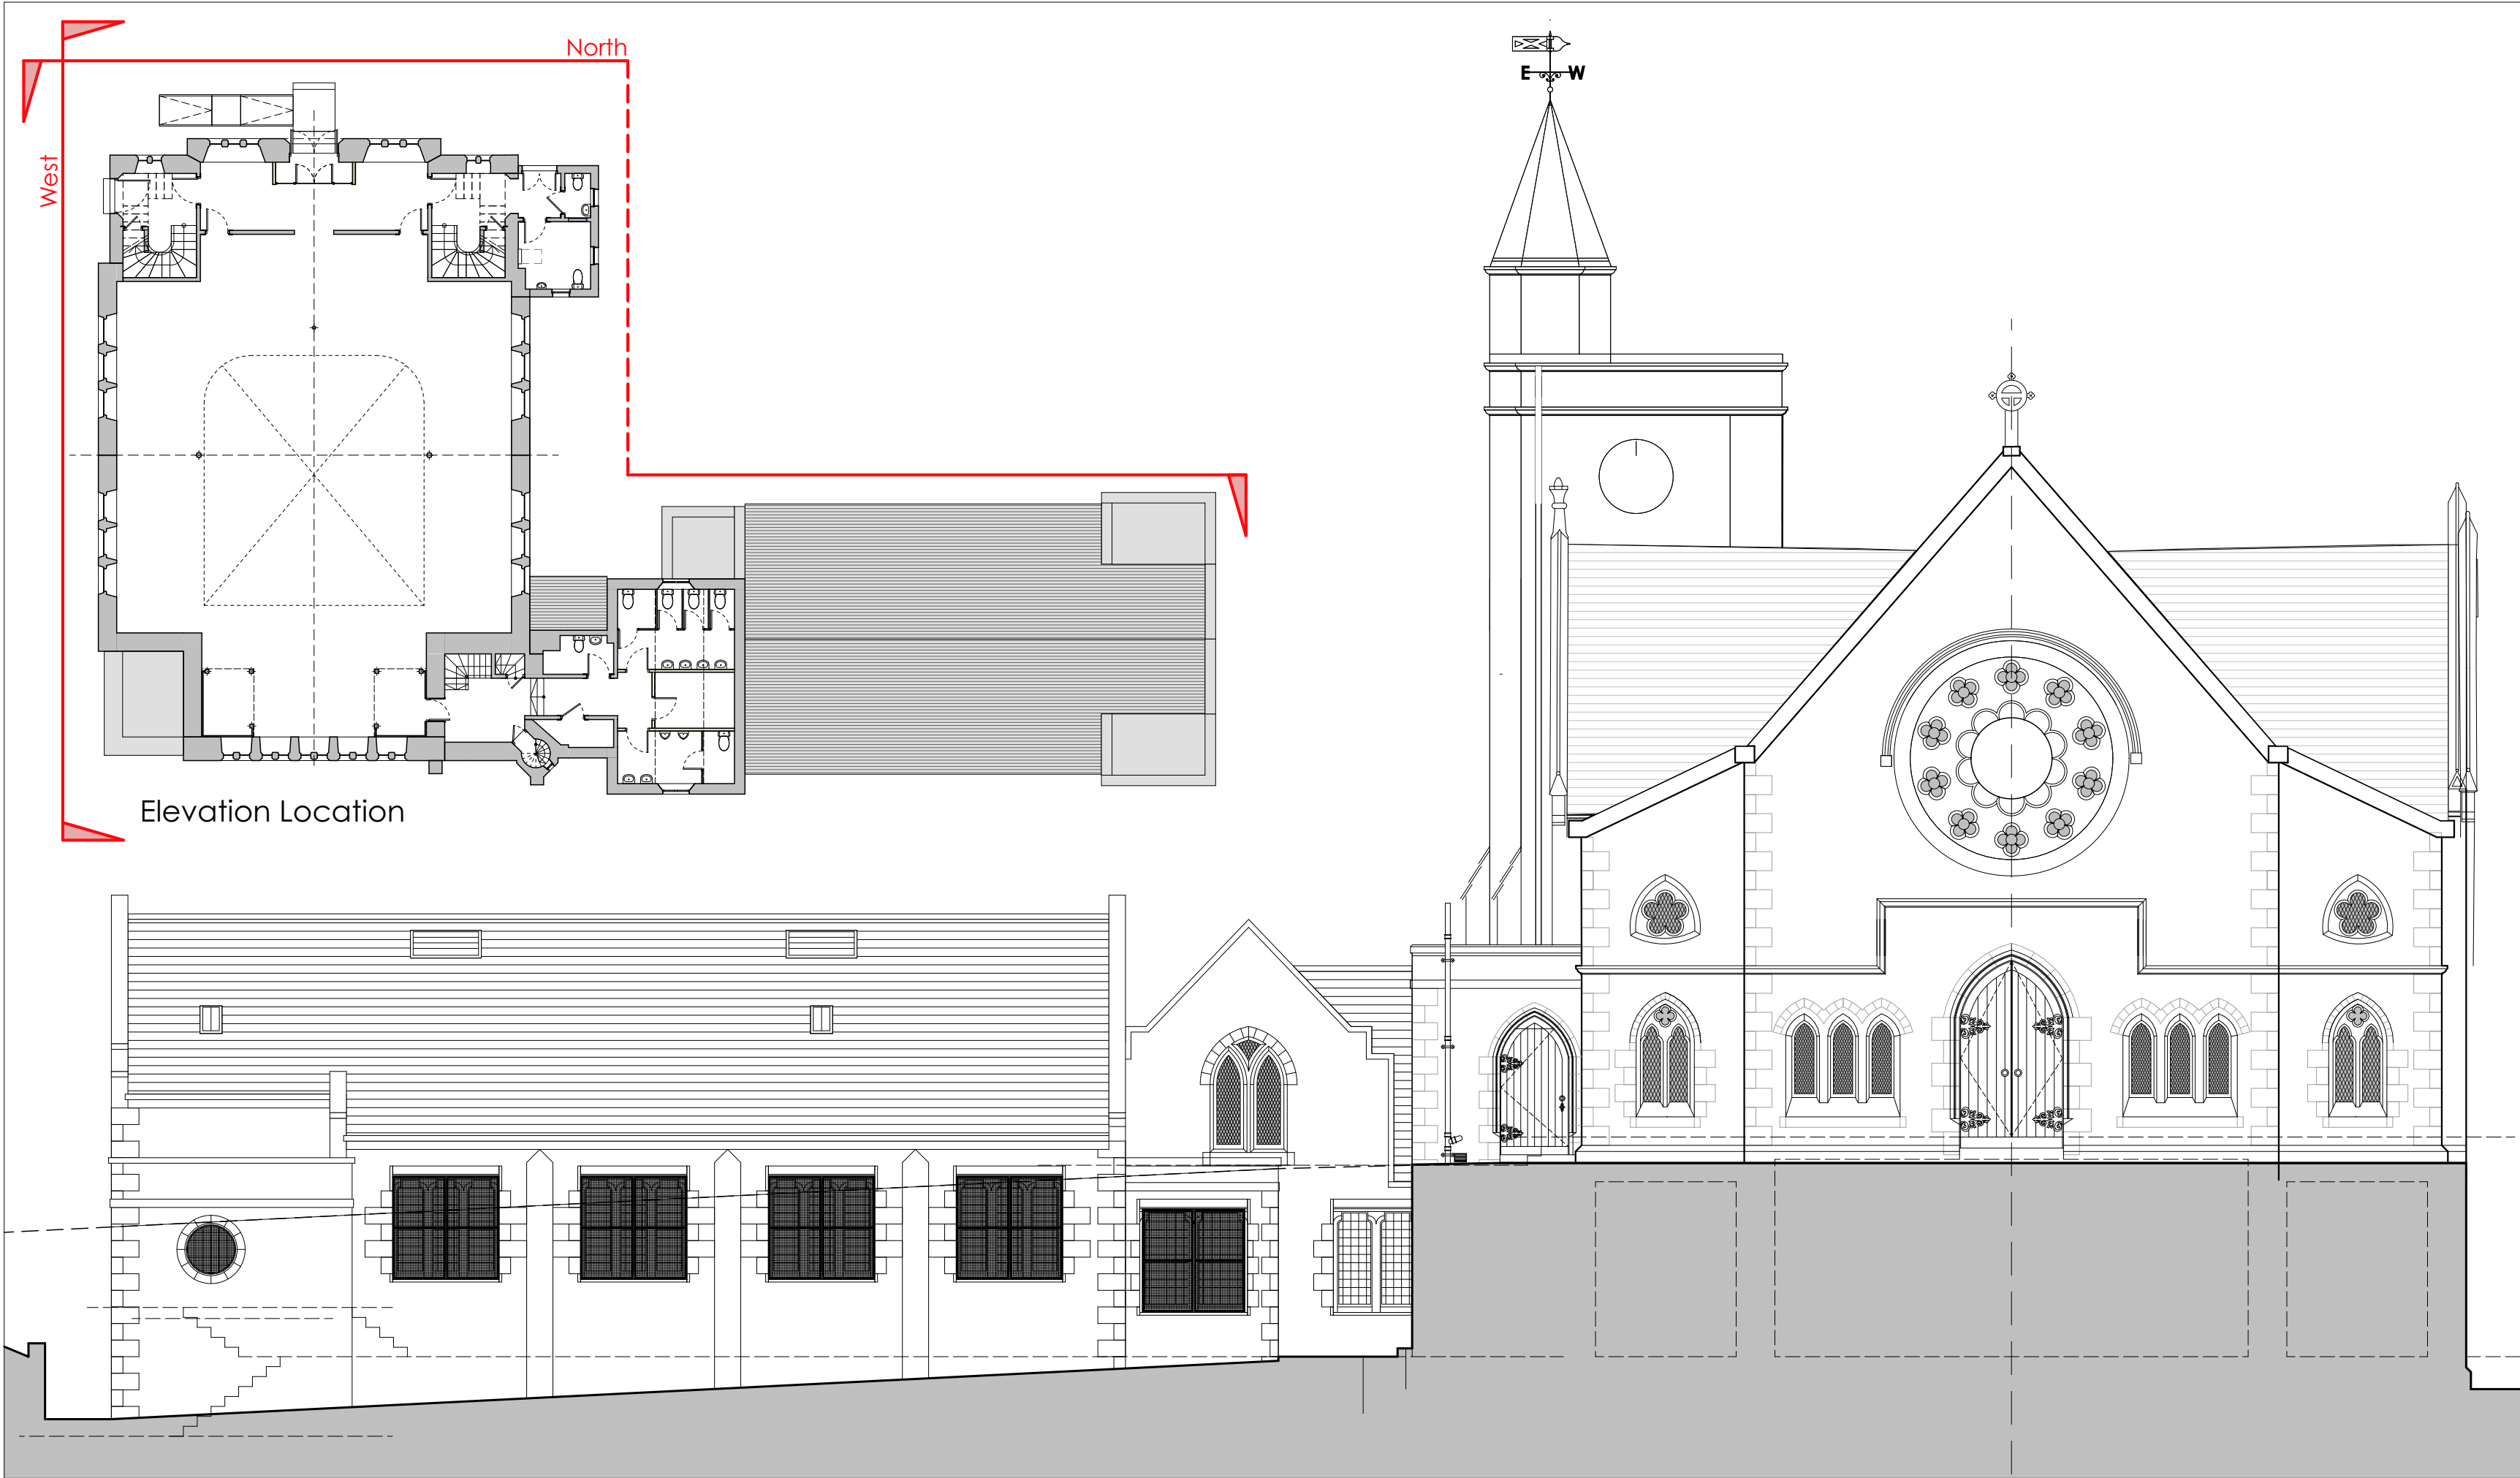


NORTH ELEVATION AS EXISTING




WEST ELEVATION AS EXISTING

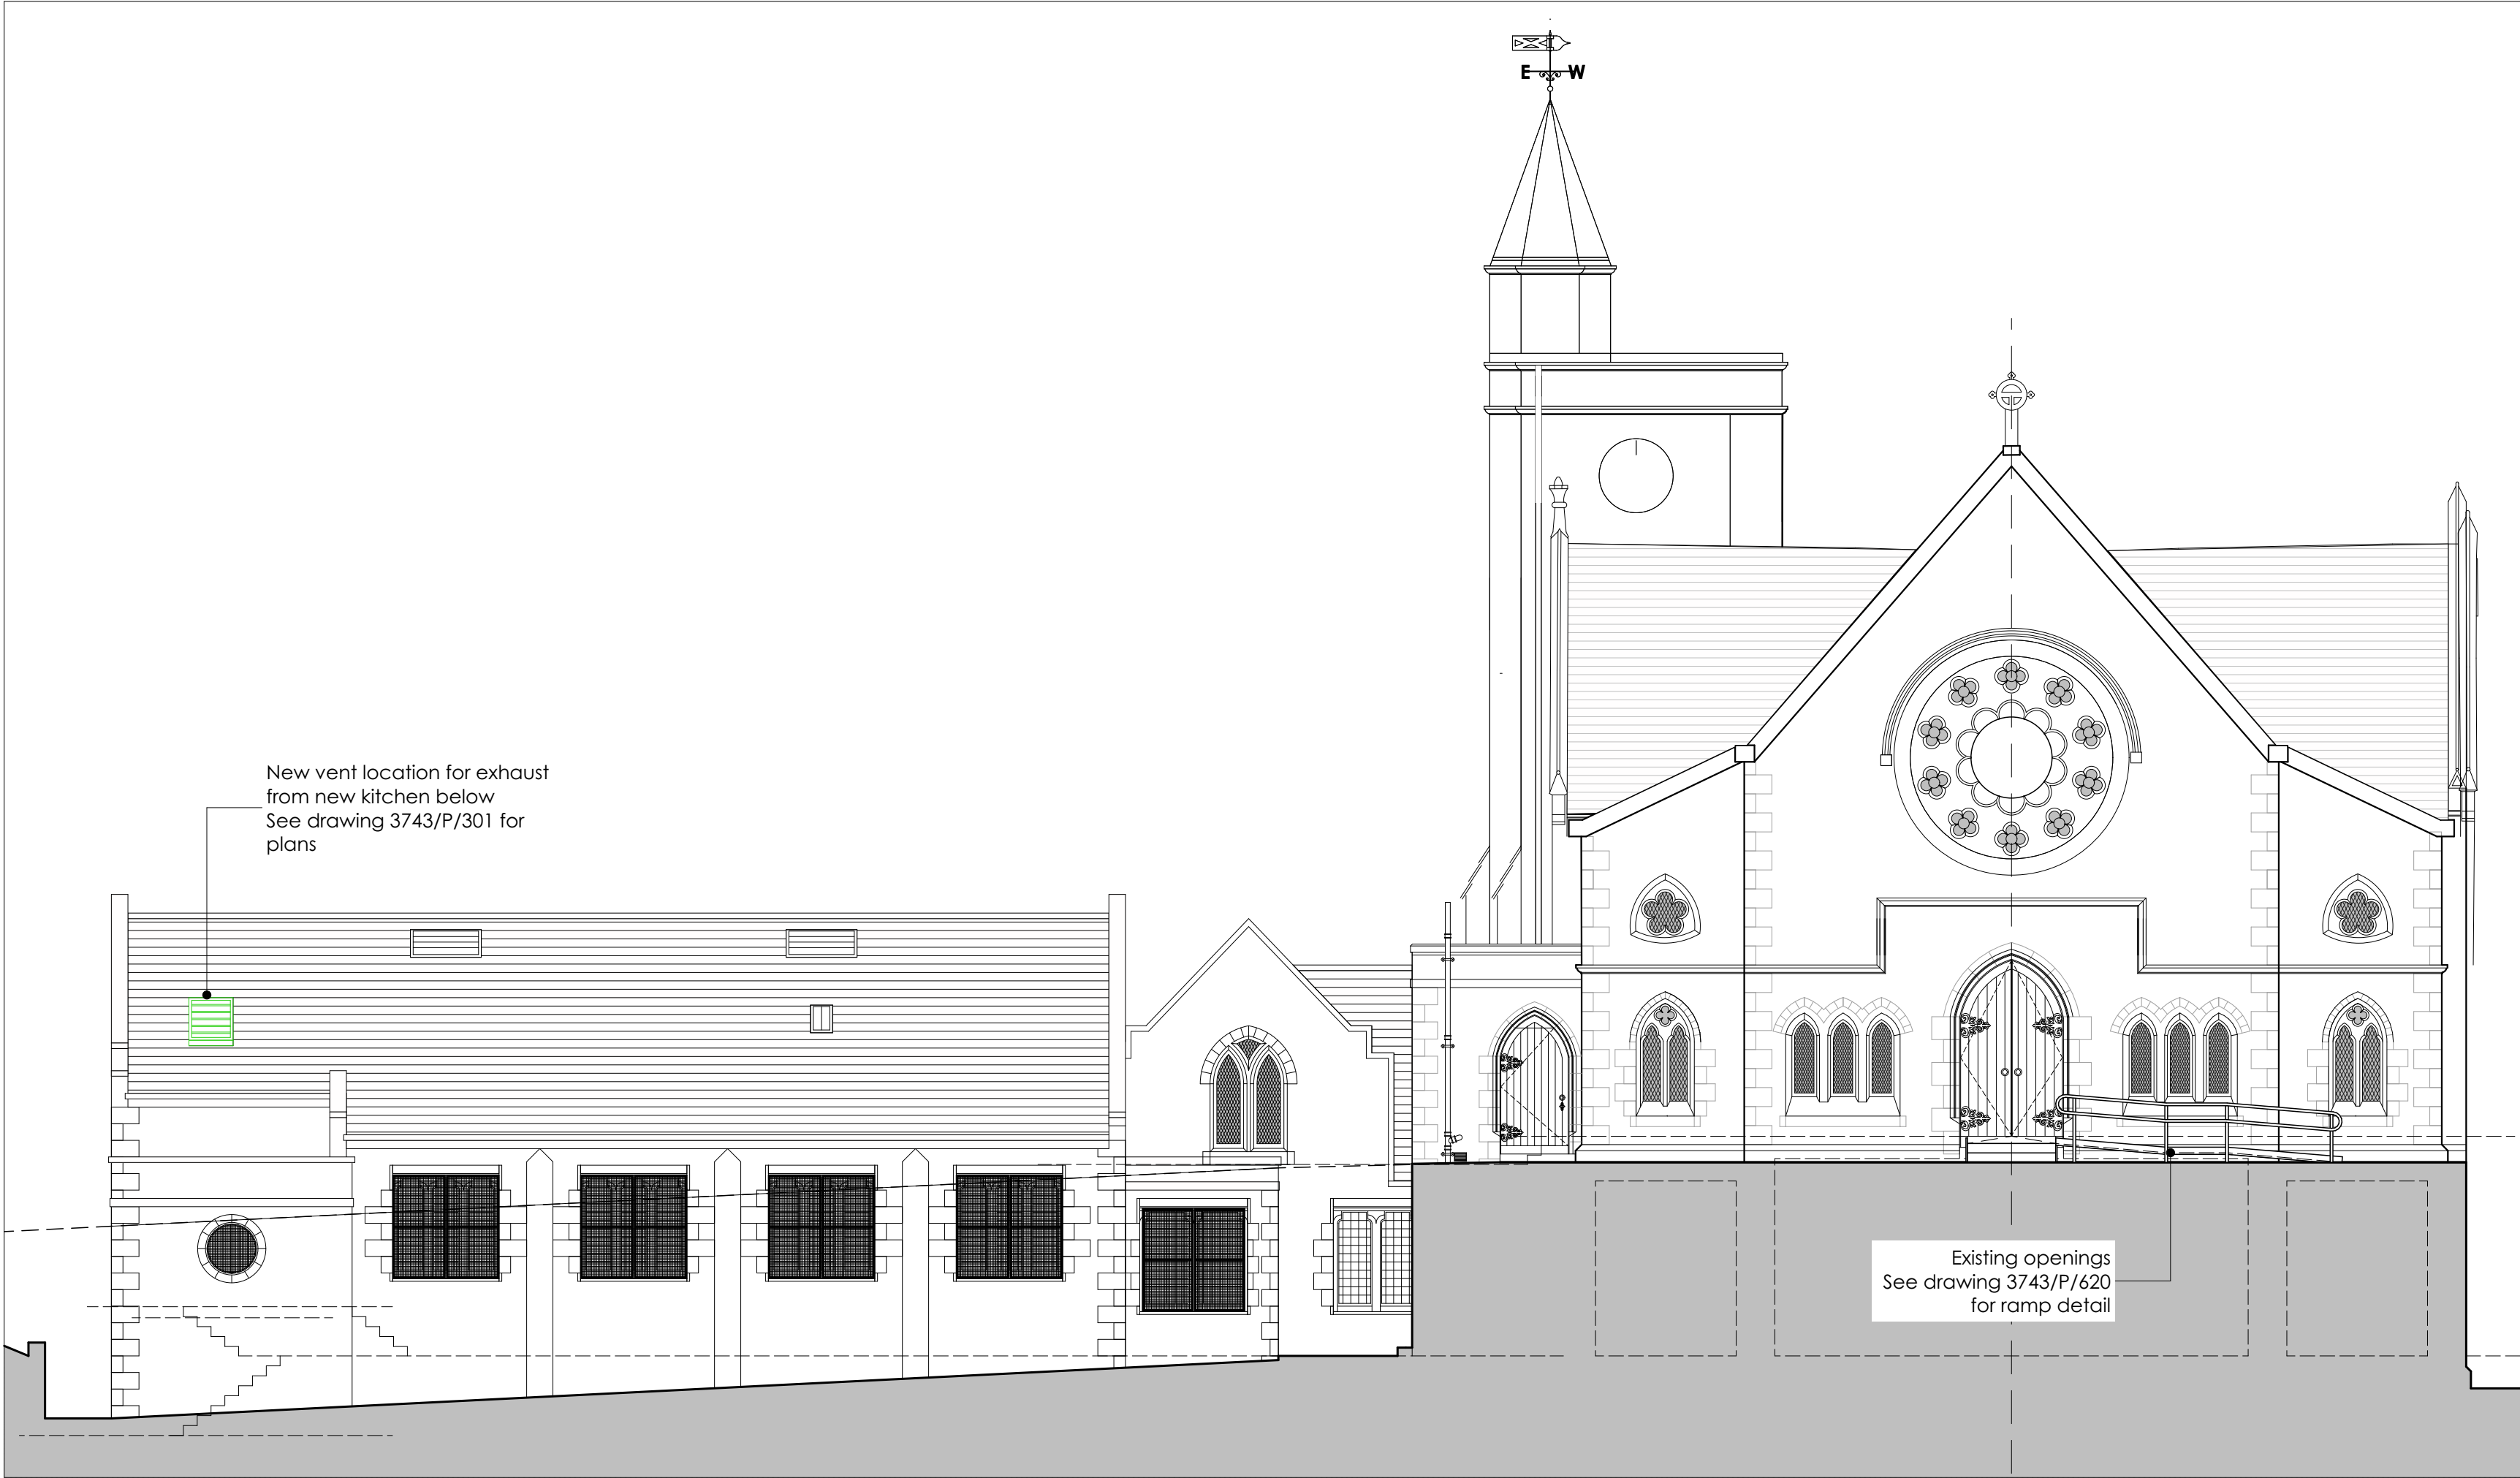

NORTH ELEVATION AS PROPOSED

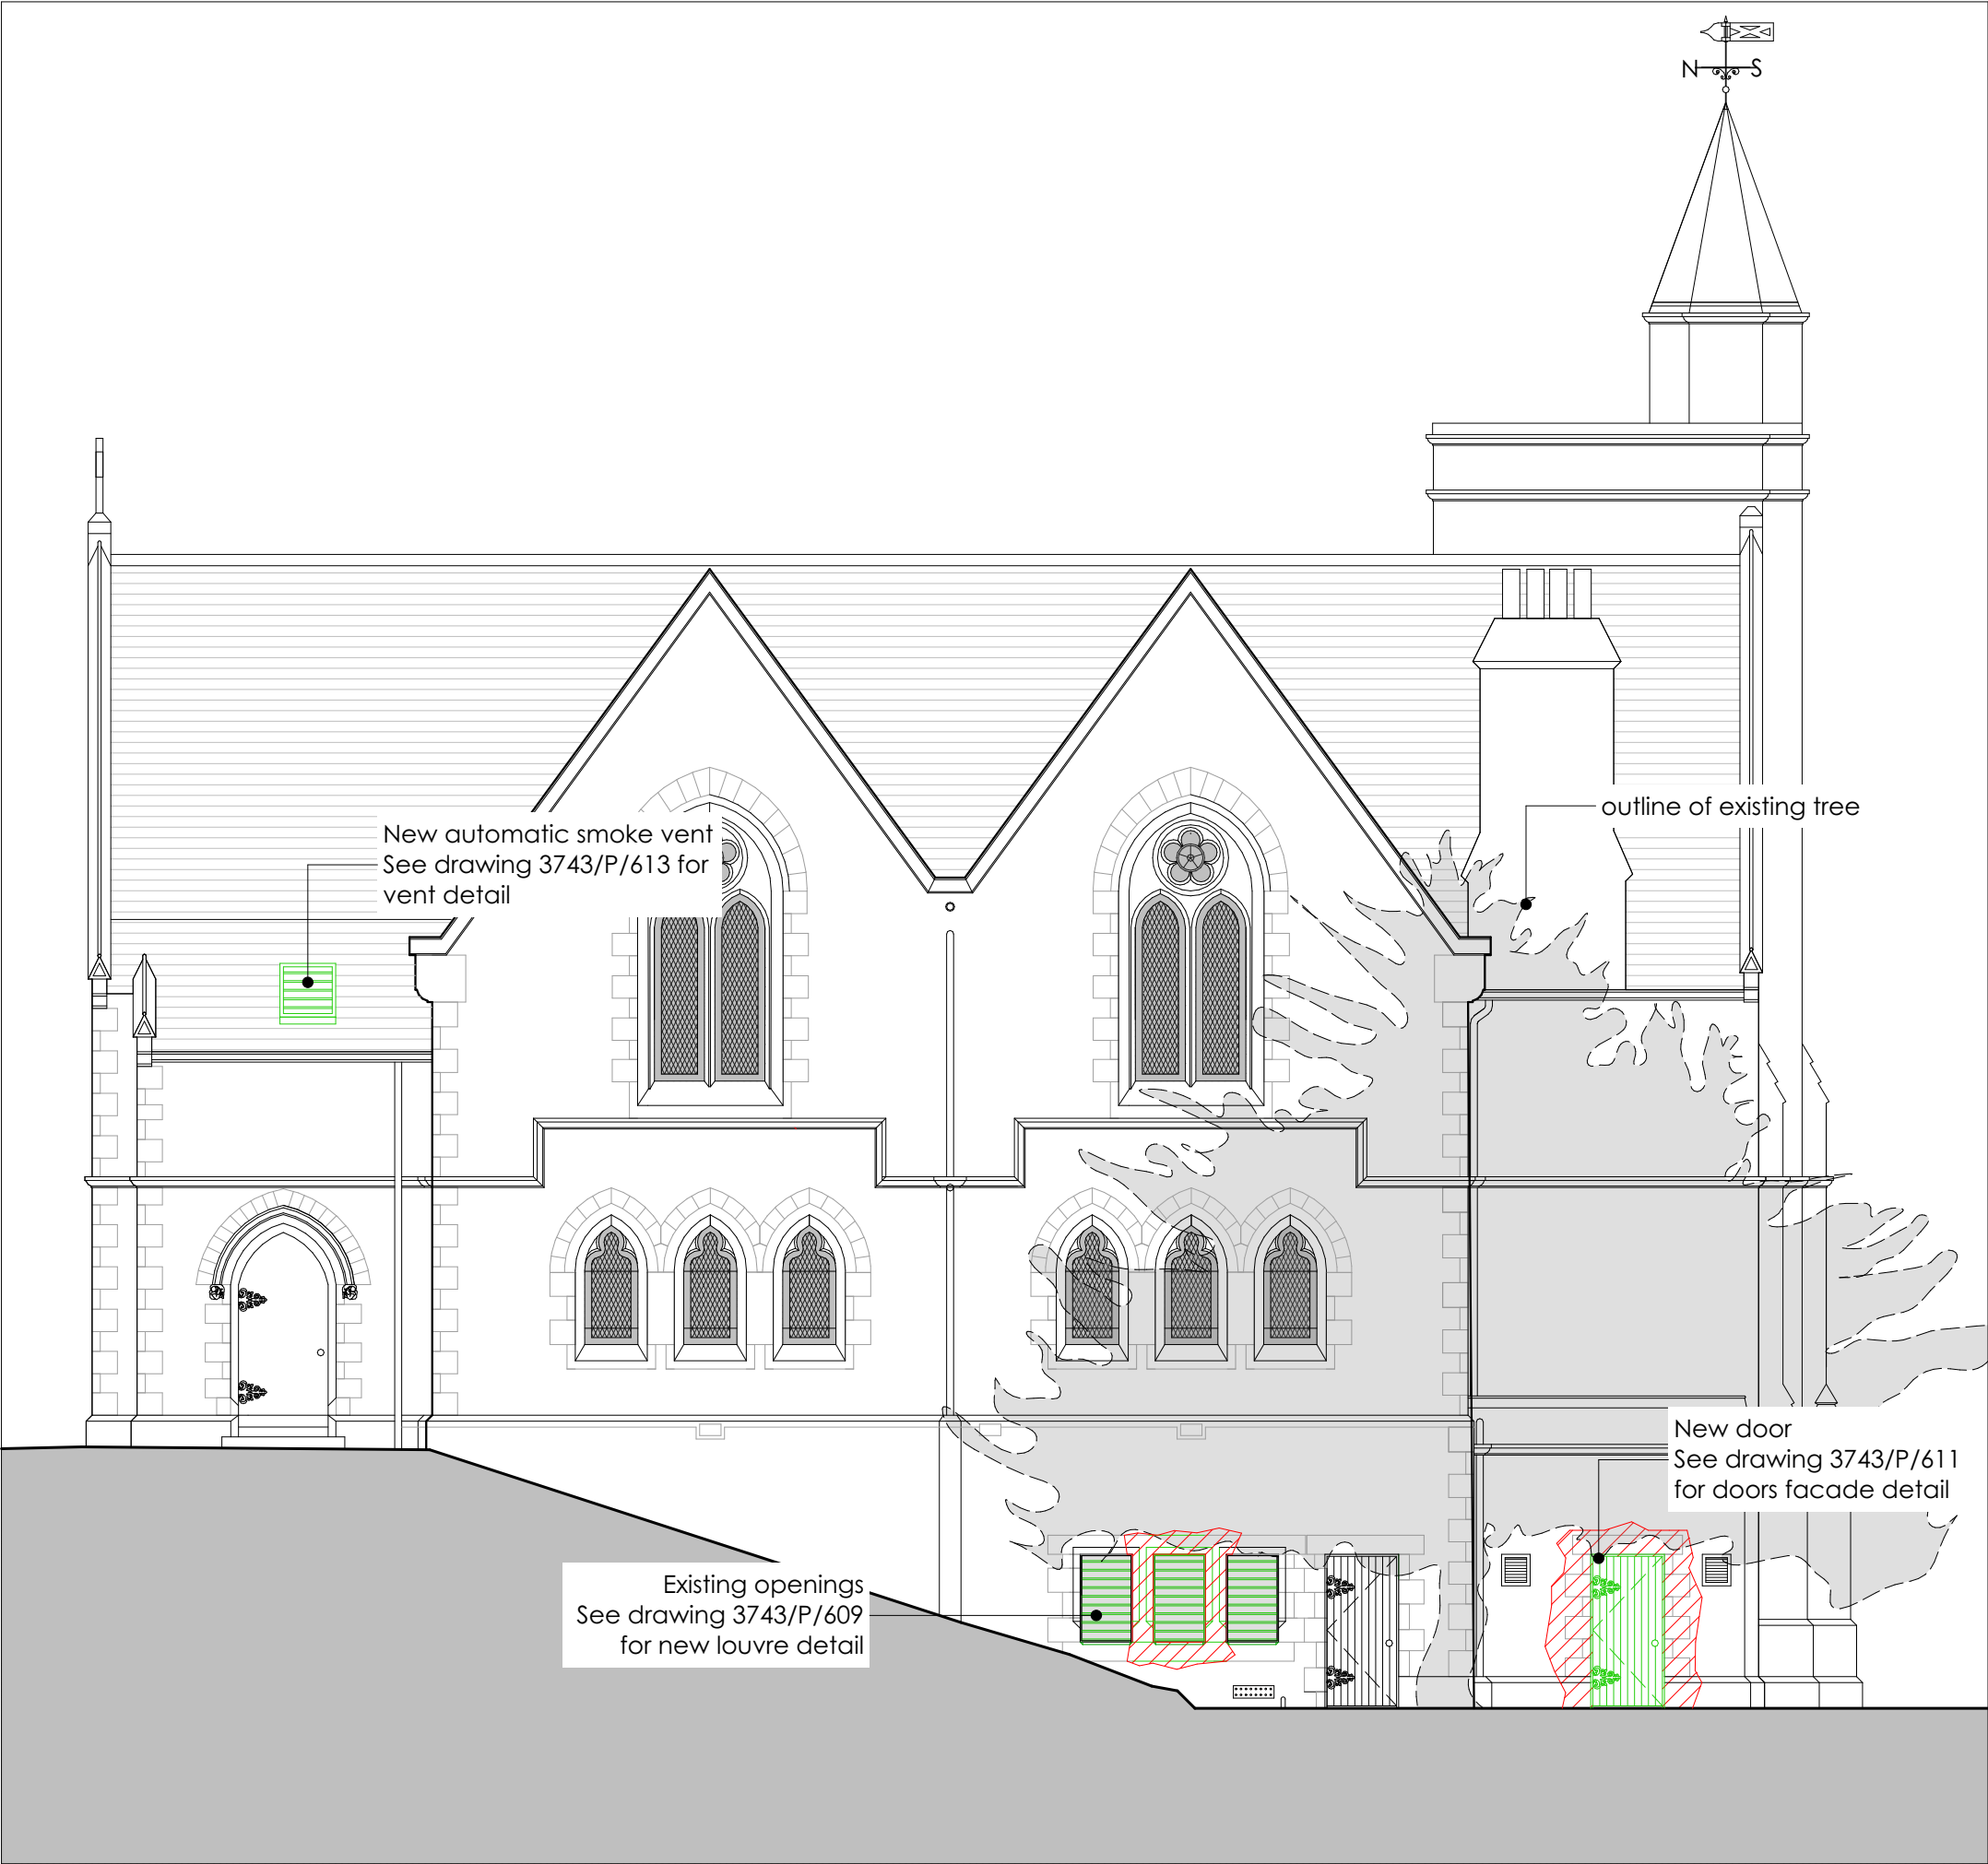

WEST ELEVATION AS PROPOSED

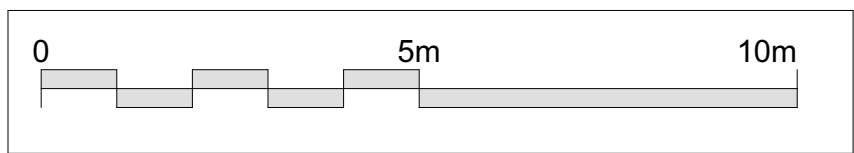

NOTE: ALL DIMENSIONS TO BE CHECKED ON SITE PRIOR TO WORK COMMENCING

REV B 28/05/2025 RJ
Updated to show entrance ramp to north
REV A 17/03/2025 RJ
Drawing updated to A1 to show North elevations

REVISIONS

A1

Do not scale. All dimensions to be checked on site prior to commencement of work.

Jewitt and Wilkie
architects

38 New City Road
Glasgow - G4 9JT
0141 552 6929
info@jwarchitects.co.uk
www.jwarchitects.co.uk

JOB TITLE

**Former Allan Park South Church, Stirling
for
Hot World Cuisine Ltd.**

DRAWING TITLE

**Existing and Proposed North
and West Elevations A1**

SCALE: 1:100

DATE:

DRAWN BY:

CHECKED BY:

DRAWING NO:

REV:

3743/P/500/B

PLANNING APPLICATION