


- Dimensions are in millimeters, unless stated otherwise.
 - Scaling of this drawing is not recommended.
 - It is the recipient's responsibility to print this document to the correct scale.
 - All relevant drawings and specifications should be read in conjunction with this drawing.

- Layout to be confirmed

C1 - Revision reference

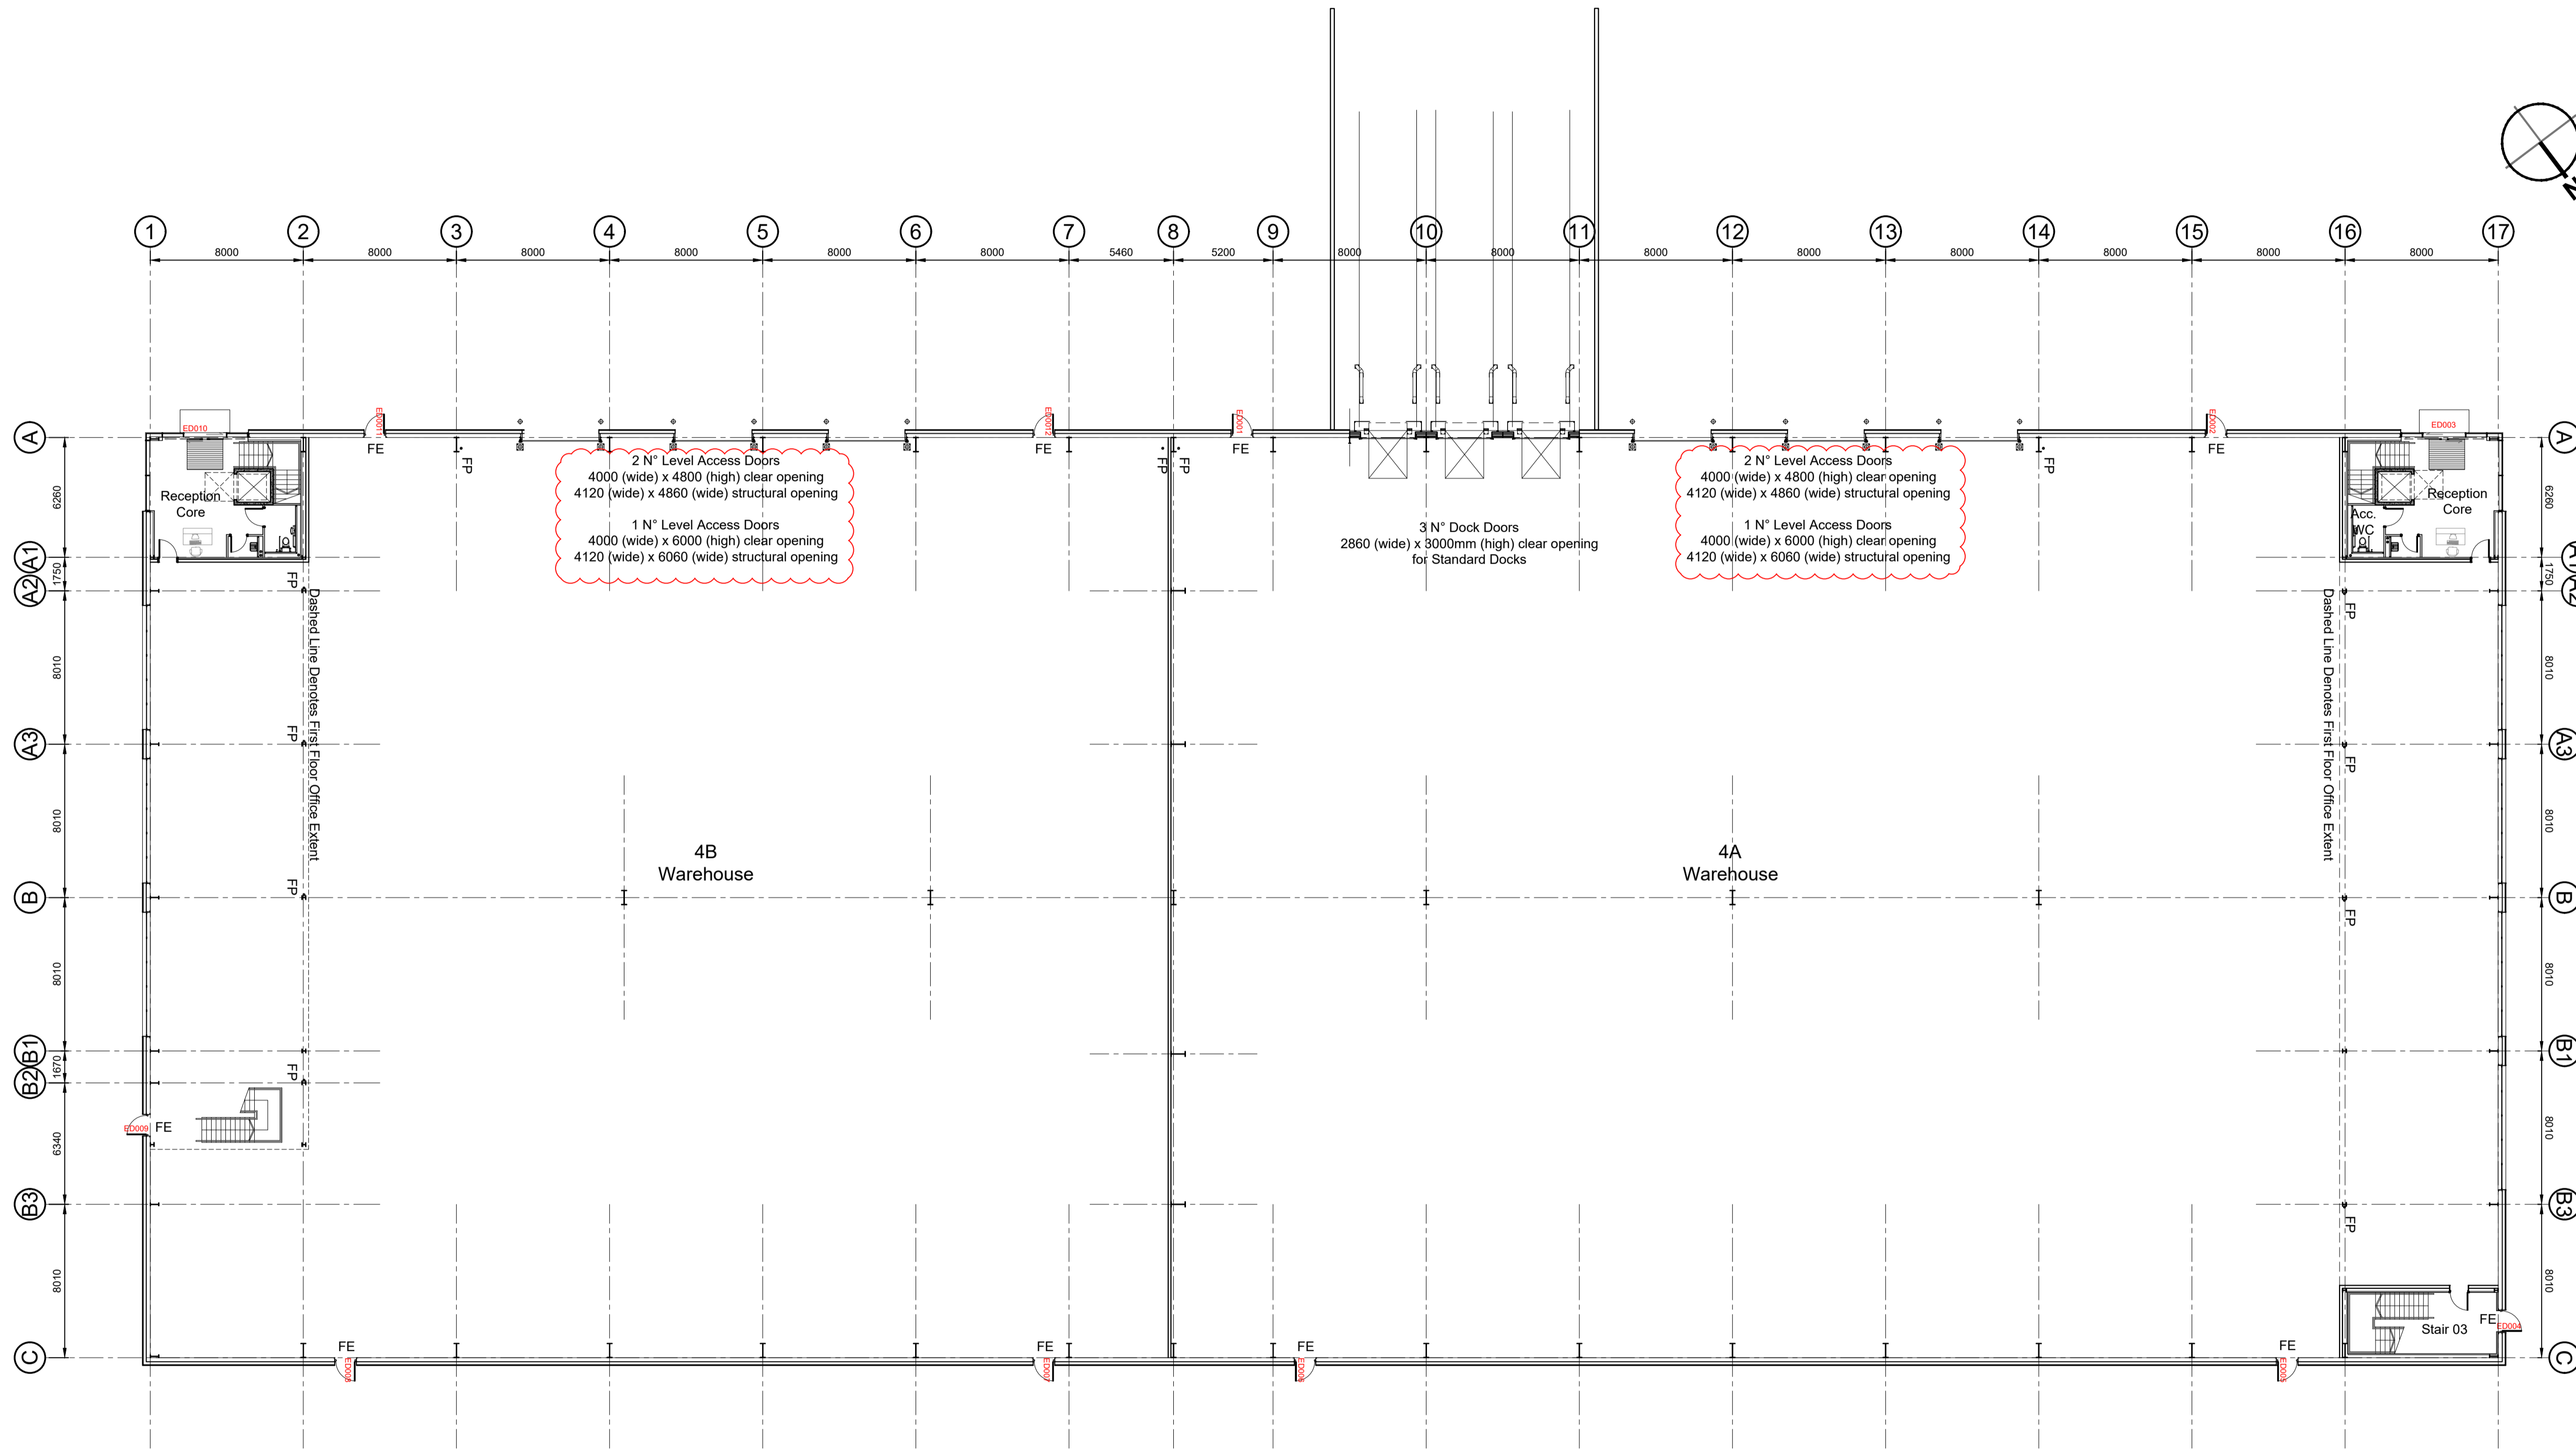

Unit 4A & 4B Building Plan Scale 1:200

B	Updated to suit subcontractor design	JJM	MD	06.04.21
A	Initial Issue	CJD	LF	14.10.20
rev	amendments	by	ckd	date

Bedford Commercial Park

Unit 4A & 4B Building Plan



Drawing Status:	Preliminary
Drawn / Checked:	CJD / LF
Date:	14.10.2020
Scale:	1:200 A1
Drawing no:	Revision:
18219 D1000	B

1m SCALE 1:200