

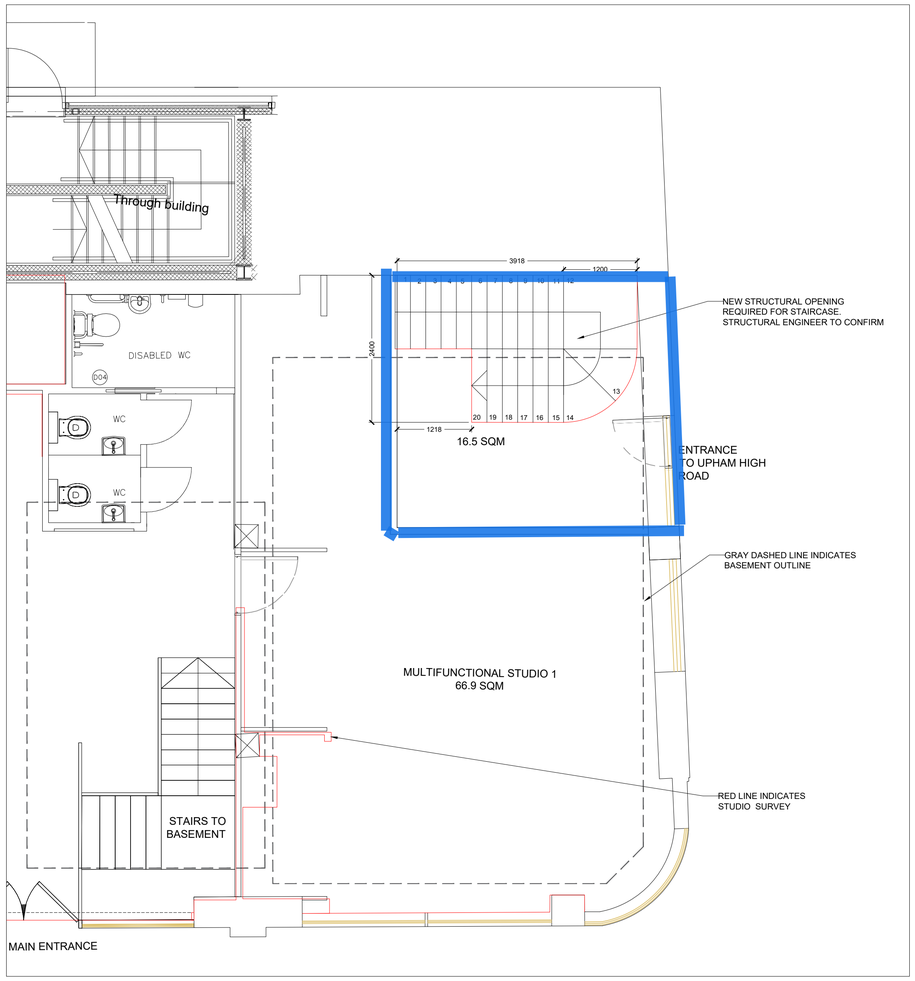



1 GROUND FLOOR PROPOSED PLAN 1:50

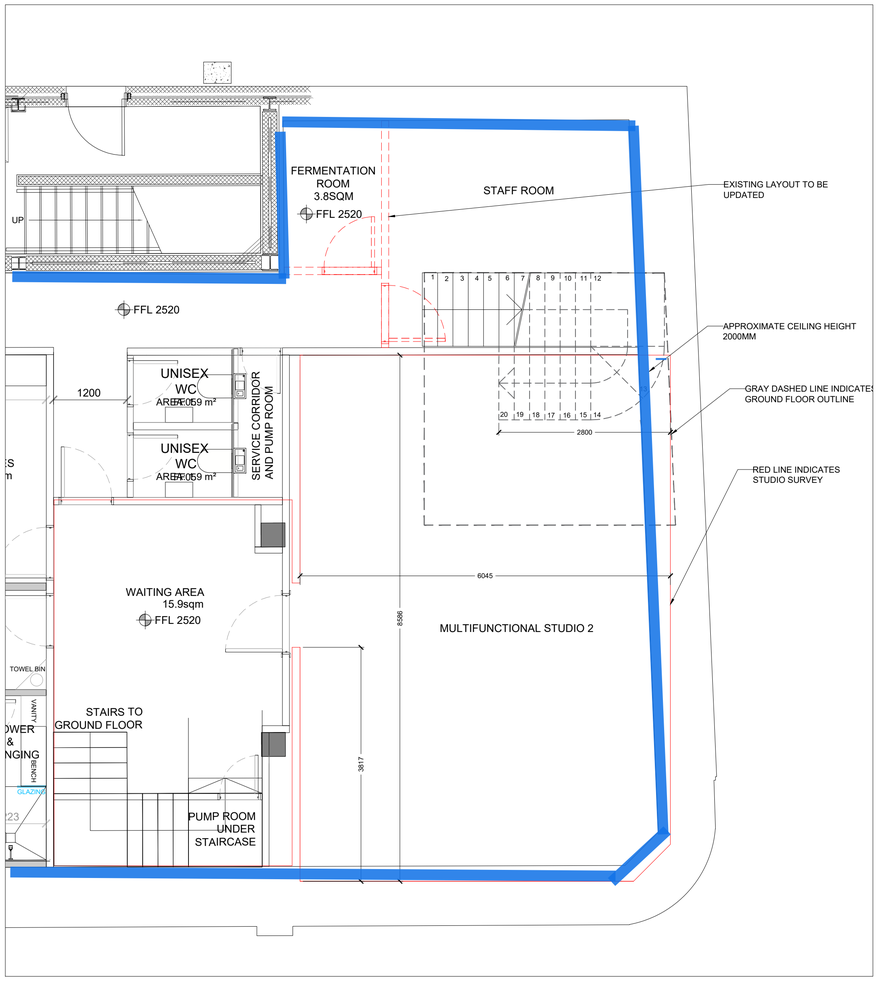

2 BESEMENT PROPOSED PLAN 1:50

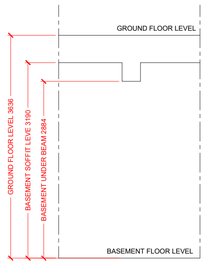

3 BASEMENT SCHEMATIC SECTION 1:50

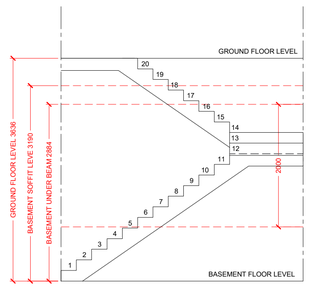

4 BASEMENT SCHEMATIC NEW STAIRCASE SECTION 1:50

GENERAL NOTES

NOTE:
EXISTING BEAMS LOCATIONS ARE NOT INDICATED. TO BE INVESTIGATE AND SURVEYED ON SITE.

REV	DATE	DESCRIPTION	DRW BY	CHK BY
D2	29/10/26	ISSUED FOR INFORMATION	TI	SA
D1	16/10/26	ISSUED FOR INFORMATION	TI	SA

PROPOSED STAICASE PLANS & SECTION OP. B

LEVEL

DESIGN
S220+
JETSET
104-108 CHISWICK HIGH ROAD

© STUDI+O Limited
All designs are the sole property of STUDI+O Ltd. and may not be used, transferred, or disclosed to a third party without their express permission. Electronic copies of this drawing are supplied for convenience only. No dimensions or other information should be inferred from the electronic copy unless specifically shown on the hard copy drawings or specifications. Do not scale from this drawing. Figured dimensions only are to be used 'For Construction' and any scaling of the drawing will be at the Contractor's risk. Contractor to verify all dimensions, levels, and components on-site. Any discrepancies shall be addressed in writing to this office for clarification prior to the commencement of the work, otherwise the Contractor shall bear full responsibility for any associated cost. Any claims for variations or extras shall be submitted to this office for assessment prior to approval of any such variation or extra. This drawing is to be read on conjunction with all other contract documentation.

www.studio-london.co.uk
hello@studio-london.co.uk

DRAWING NO.	REVISION	SCALE
AP-01-B	**D2**	**1:50 @ A1**