

FLOOR AREA (FA)
532 m² / 5726 sq.ft

NET USABLE AREA (NIA)
476 m² / 5124 sq.ft
(excluding Lobby, Lifts, Staircases and WC's Areas)

CLIENT'S NAME
Salmon


OCCUPANCY

TOTAL HEADCOUNT 78 POSITIONS
WORKSTATIONS 72
HOT DESK POSITIONS 6

MEETING SPACES 10 POSITIONS
MEETING ROOM (6P) 1
MEETING ROOM (4P) 1

COLLABORATION/ BREAKOUT SPACES 28 POSITIONS
HIGH PERCH TABLES (4P) 3
FURNITURE BOOTH SYSTEMS (4P) 2
WORKING LOUNGE (4P) 1
QUIET SPACE (SINGLE POSITIONS) 4

ANCILLARY AREAS
DRINKS STATION 1
PRINT HUB (1 PRINTER/ HUB) 2

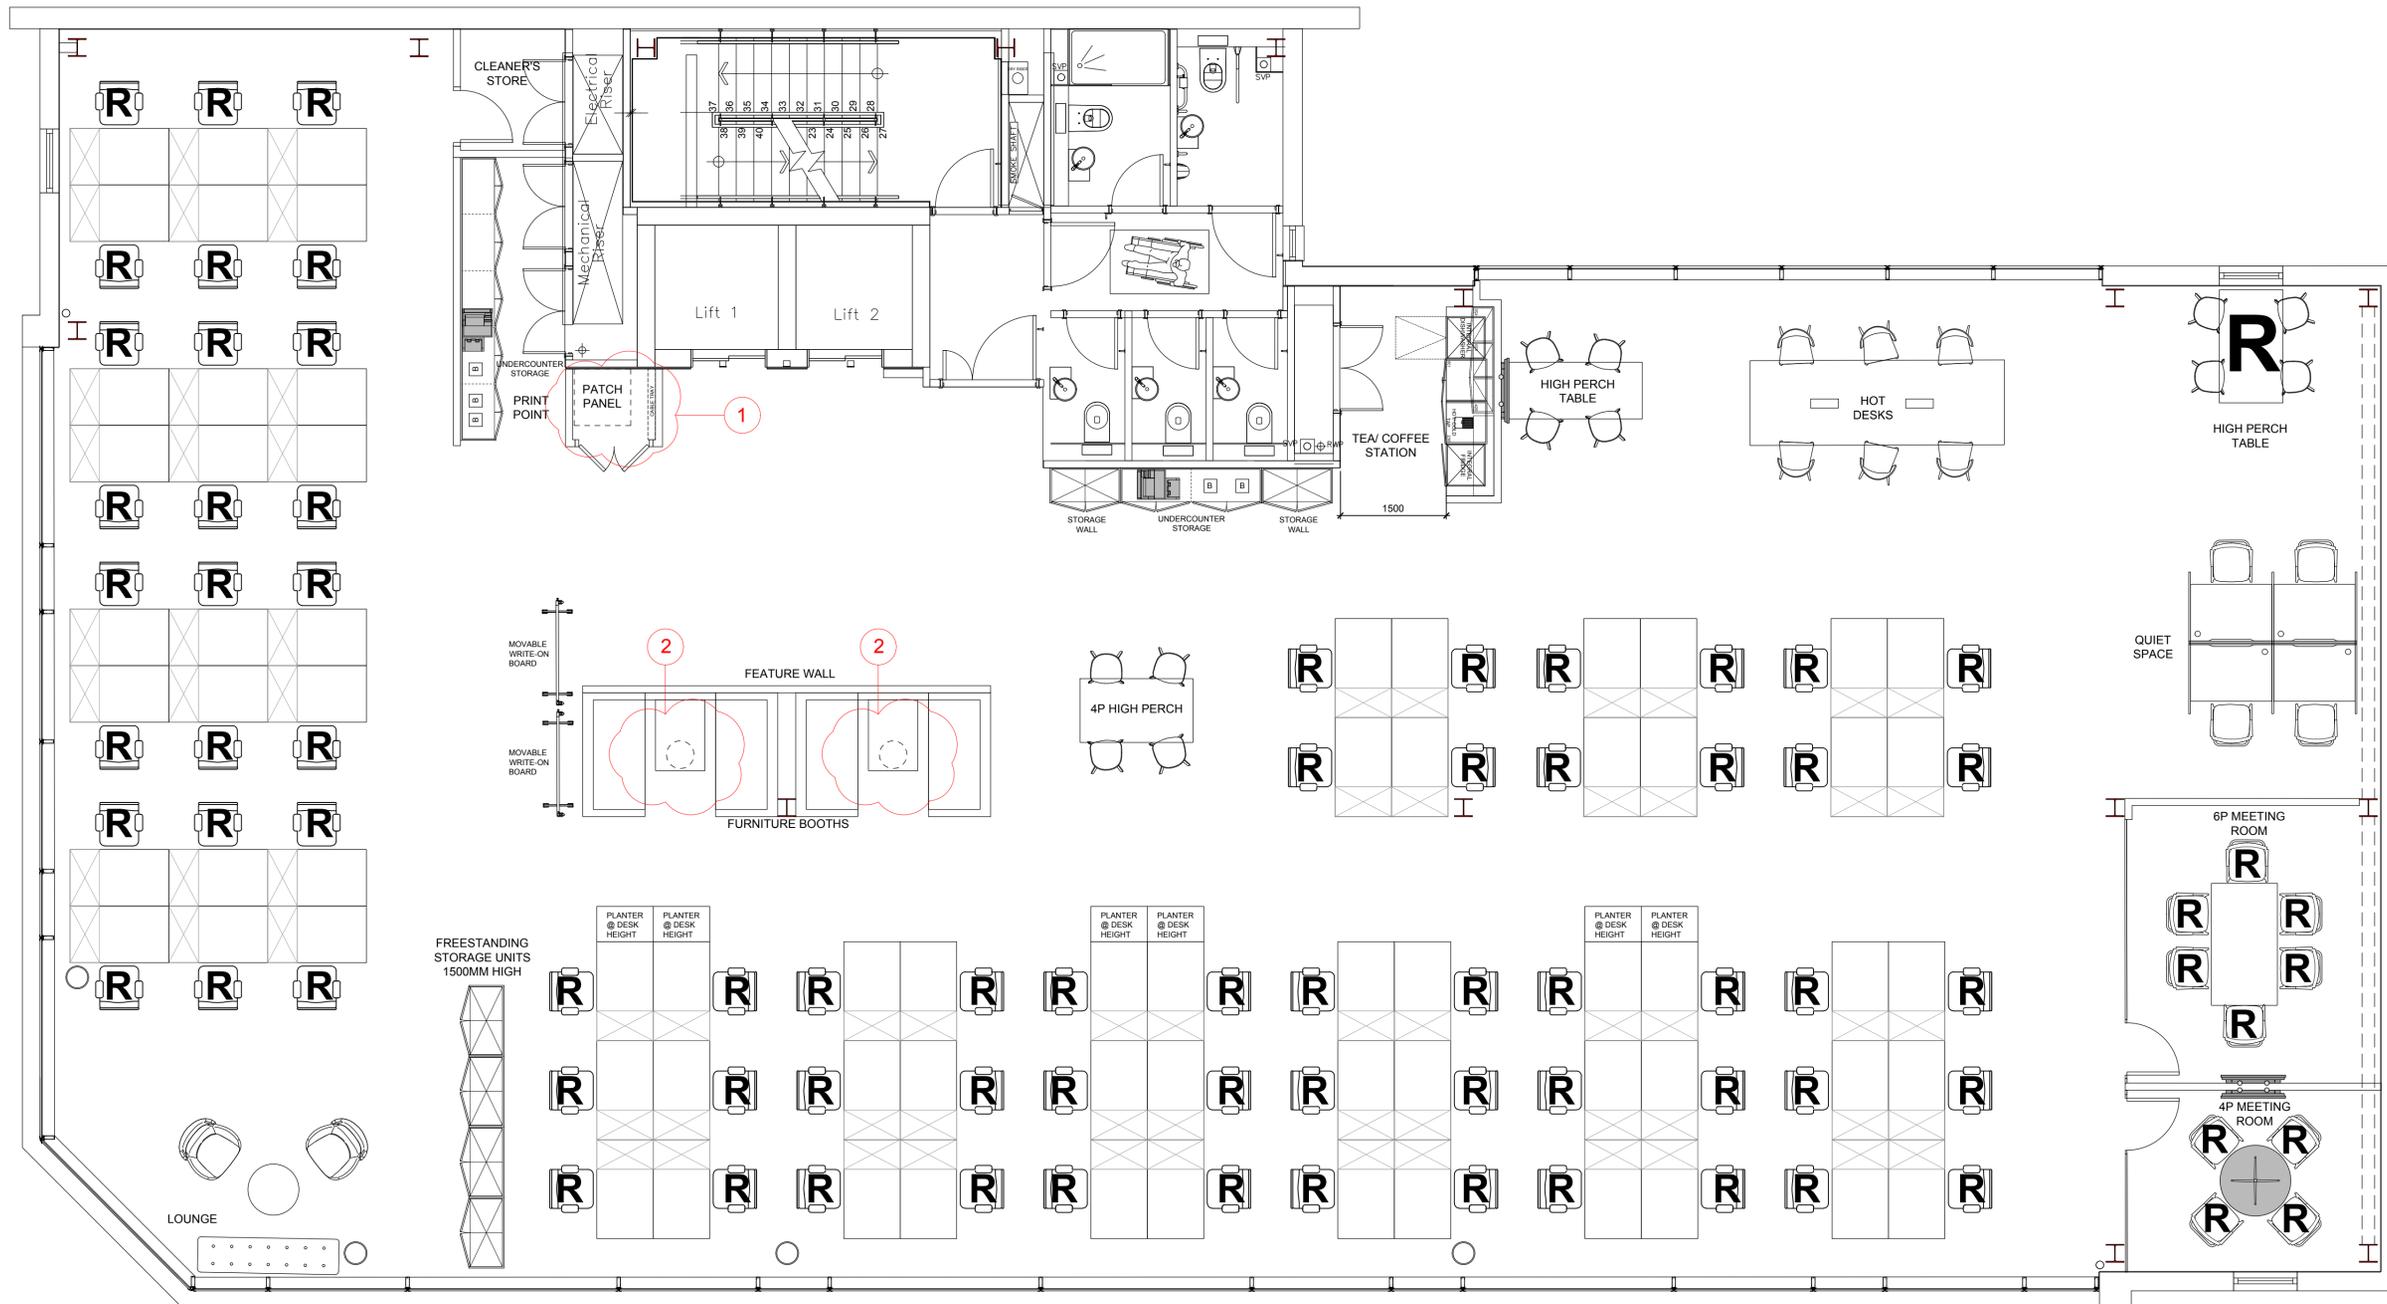

LEGEND:

- R FURNITURE BEING RELOCATED FROM THE PREVIOUS OFFICES
- B BASE UNIT TO CONTAIN INTEGRATED RECYCLING BIN

REVISIONS:

- 1 PATCH PANEL CUPBOARD INCREASED IN SIZE TO ALLOW FOR ACCESS TO TWO SIDES OF THE FLOOR STANDING CABINET
- 2 PENDANT LIGHT ADDED ABOVE EACH FURNITURE BOOTH. REFER TO FINISHES SCHEDULE FOR DETAIL

NOTES:

ALL SCREEN/ AV LOCATIONS ARE INDICATIVE. REFER TO AV CONTRACTORS DRAWINGS FOR EXACT LOCATION, DIMENSIONS AND PLACEMENT

Peldon Rose
Workplace thinkers & makers™

CLIENT
Salmon

LOCATION
36 Clarendon Road, London
FLOOR
First

DRAWING NAME
General arrangement plan

DRAWING NUMBER: EN2147-01-01
DATE: 30.01.2018
SCALE: 1:50 @ A1
REVISION: P12

Peldon Rose Limited
Sterling House, 42 Worple Road
London SW19 4EQ
Telephone: 020 8971 7777
web: www.peldonrose.com

This drawing is protected under copyright and at no time should this drawing be reproduced in whole or in part without the permission of Peldon Rose Limited.
© COPYRIGHT

