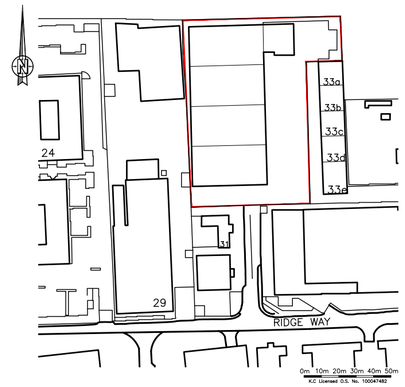

Location Plan - 1:2500

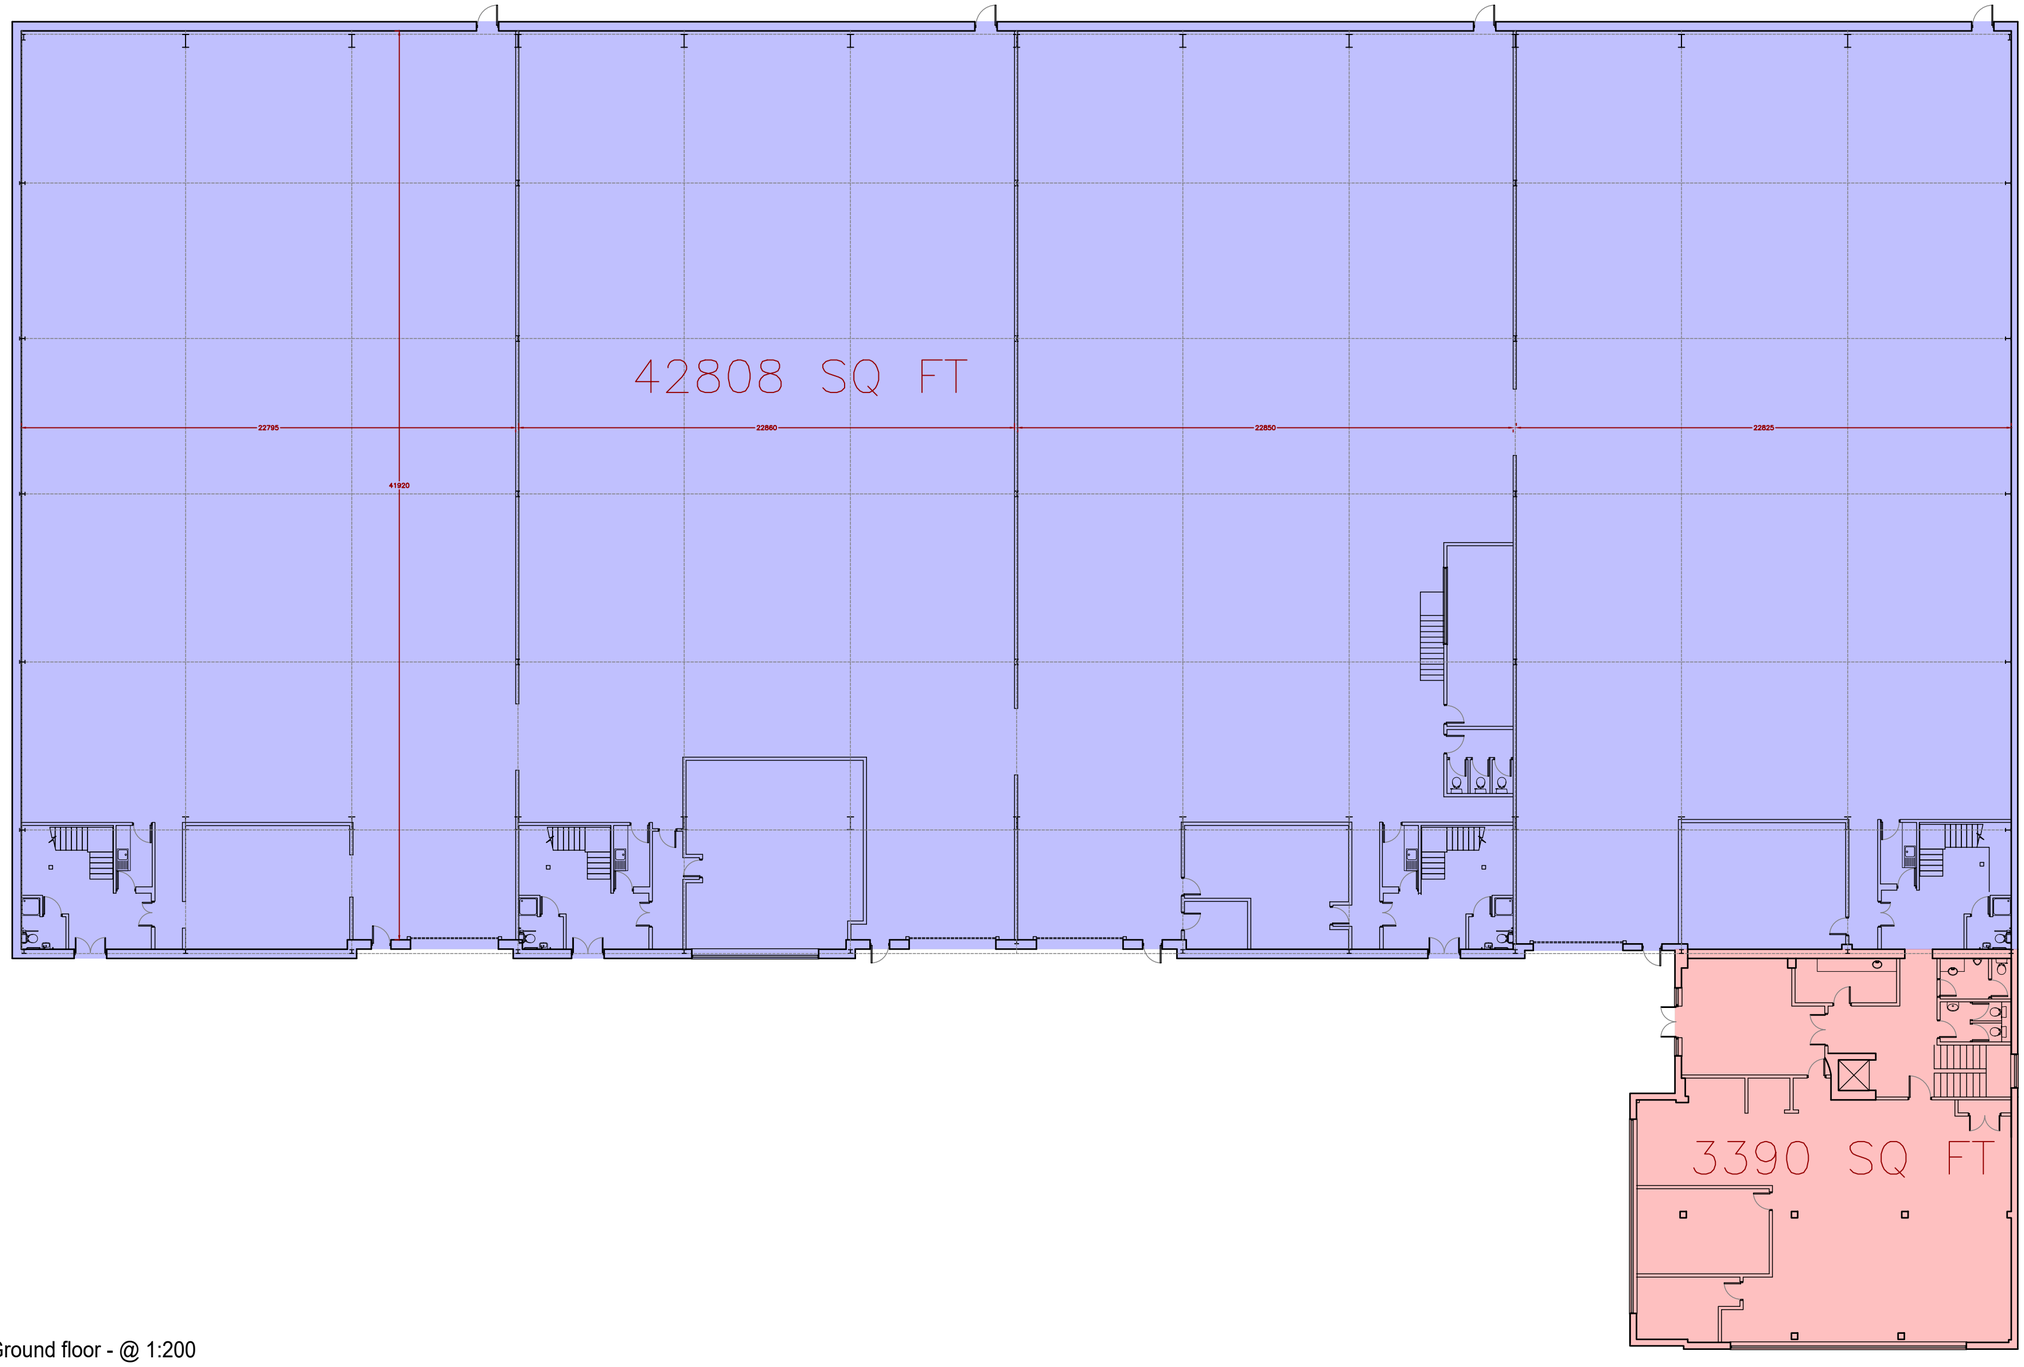

Ground floor - @ 1:200

ACCOMMODATION & FLOOR AREAS		
UNITS A – D WAREHOUSE / ANCILLARY	42808	SQ FT
FIRST FLOOR OFFICES	4423	SQ FT
UNIT E OFFICES	10,117	SQ FT
TOTAL GEA	57,348	SQ FT

KEY:

: Warehouse A – D

: Unit E Offices

: First Floor Offices

0m 2m 4m 6m 8m 10m 12m 14m 16m 18m 20m

Rev	Revision	By	Date

KNIGHT Consulting
ARCHITECTURE - SURVEYING - PLANNING
First Floor Unit 7
The Quarterdeck
Port Solent
PO6 4TP
T: 01489 660194
admin@knight-consulting.co.uk
www.knight-consulting.co.uk

Client

COGENT

Project

THE RIDGEWAY, UNITS A-D
IVER
SL0 9HX

Drawing

GEA

Scale	Date
1:200@A2	MAR 2026

Project no.	Sequential	Bldg/Floor	Detail	Rev
KC	01	A	HMLR	A

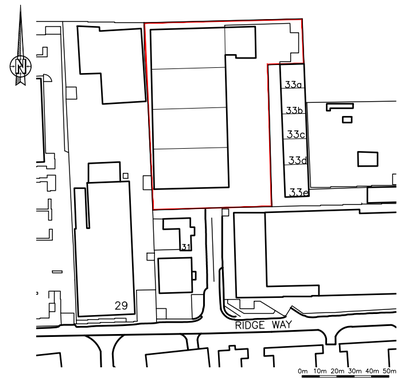

Location Plan - 1:2500

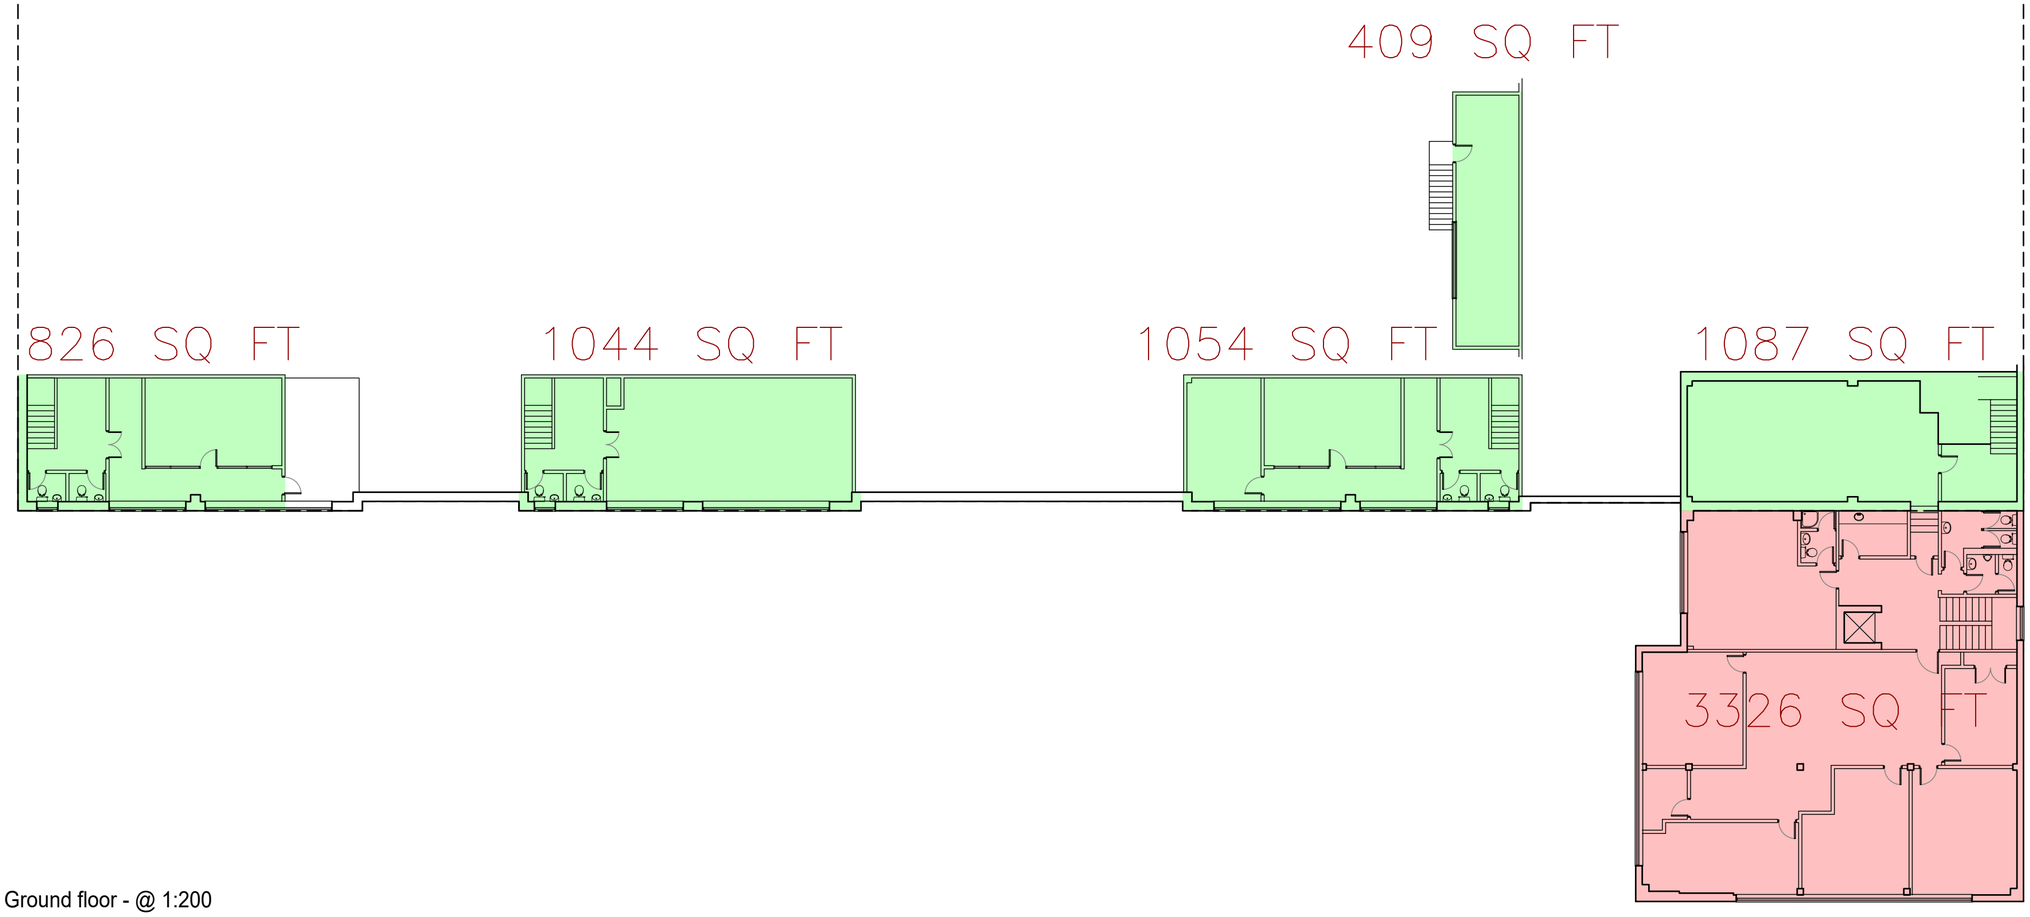

Ground floor - @ 1:200

ACCOMMODATION & FLOOR AREAS		
UNITS A – D WAREHOUSE / ANCILLARY	42,808	SQ FT
FIRST FLOOR OFFICES	4423	SQ FT
UNIT E OFFICES	10,117	SQ FT
TOTAL GEA	57,348	SQ FT

KEY:

: Warehouse A – D

: Unit E Offices

: First Floor Offices

0m 2m 4m 6m 8m 10m 12m 14m 16m 18m 20m

Rev	Revision	By	Date

KNIGHT Consulting
ARCHITECTURE - SURVEYING - PLANNING
First Floor Unit 7
The Quarterdeck
Port Solent
PO6 4TP
T: 01489 660194
admin@knight-consulting.co.uk www.knight-consulting.co.uk

Client
COGENT

Project
THE RIDGEWAY, UNITS A-D
IVER
SL0 9HX

Drawing
GEA - FIRST FLOOR

Scale	Date
1:200@A2	MAR 2026

Project no.	Sequential	Bldg/Floor	Detail	Rev
KC	02	A	HMLR	A

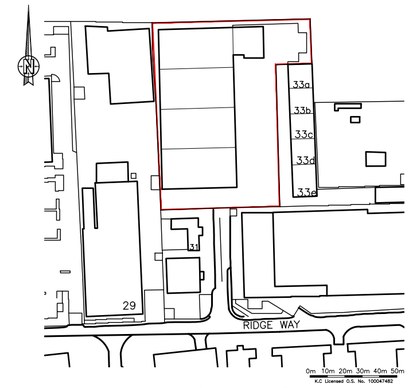

Location Plan - 1:2500

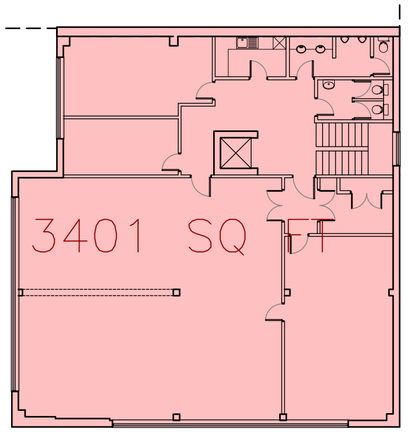

Ground floor - @ 1:200

ACCOMMODATION & FLOOR AREAS

UNITS A – D WAREHOUSE / ANCILLARY	42808	SQ FT
FIRST FLOOR OFFICES	4423	SQ FT
UNIT E OFFICES	10,117	SQ FT
TOTAL GEA	57,348	SQ FT

KEY:

: Warehouse A – D

: Unit E Offices

: First Floor Offices

0m 2m 4m 6m 8m 10m 12m 14m 16m 18m 20m

Rev	Revision	By	Date

KNIGHT Consulting
ARCHITECTURE - SURVEYING - PLANNING
First Floor Unit 7
The Quarterdeck
Port Solent
PO6 4TP
T: 01489 660194
admin@knight-consulting.co.uk www.knight-consulting.co.uk

Client

COGENT

Project

THE RIDGEWAY, UNITS A-D
IVER
SL0 9HX

Drawing

GEA - SECOND FLOOR

Scale	Date
1:200@A2	MAR 2026

Project no.	Sequential	Bldg/Floor	Detail	Rev
KC	03	A	HMLR	A