
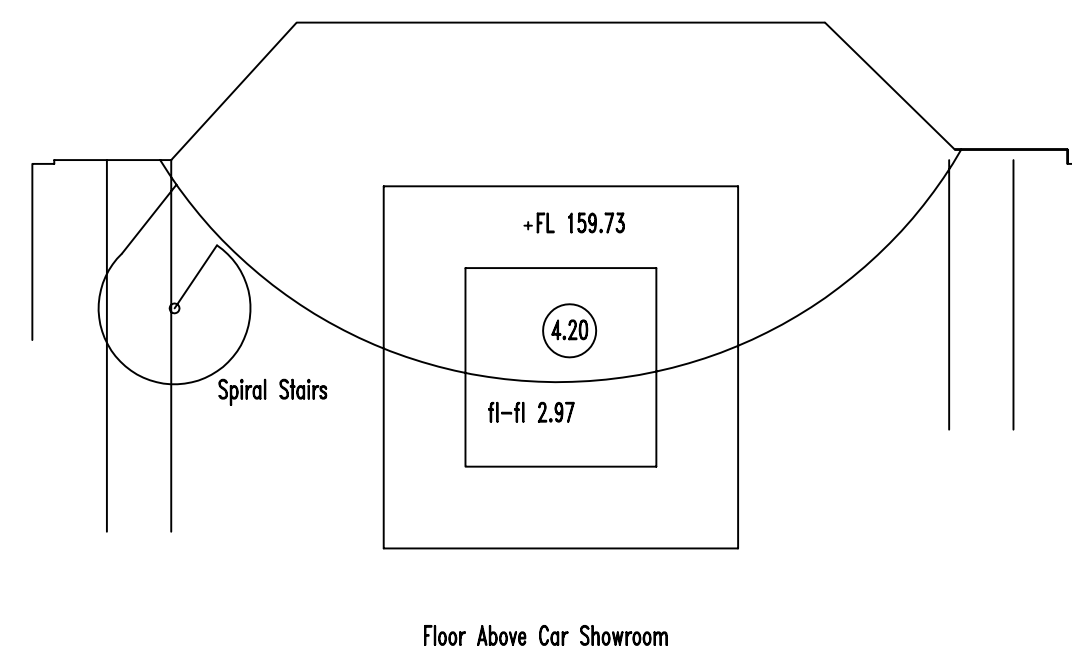
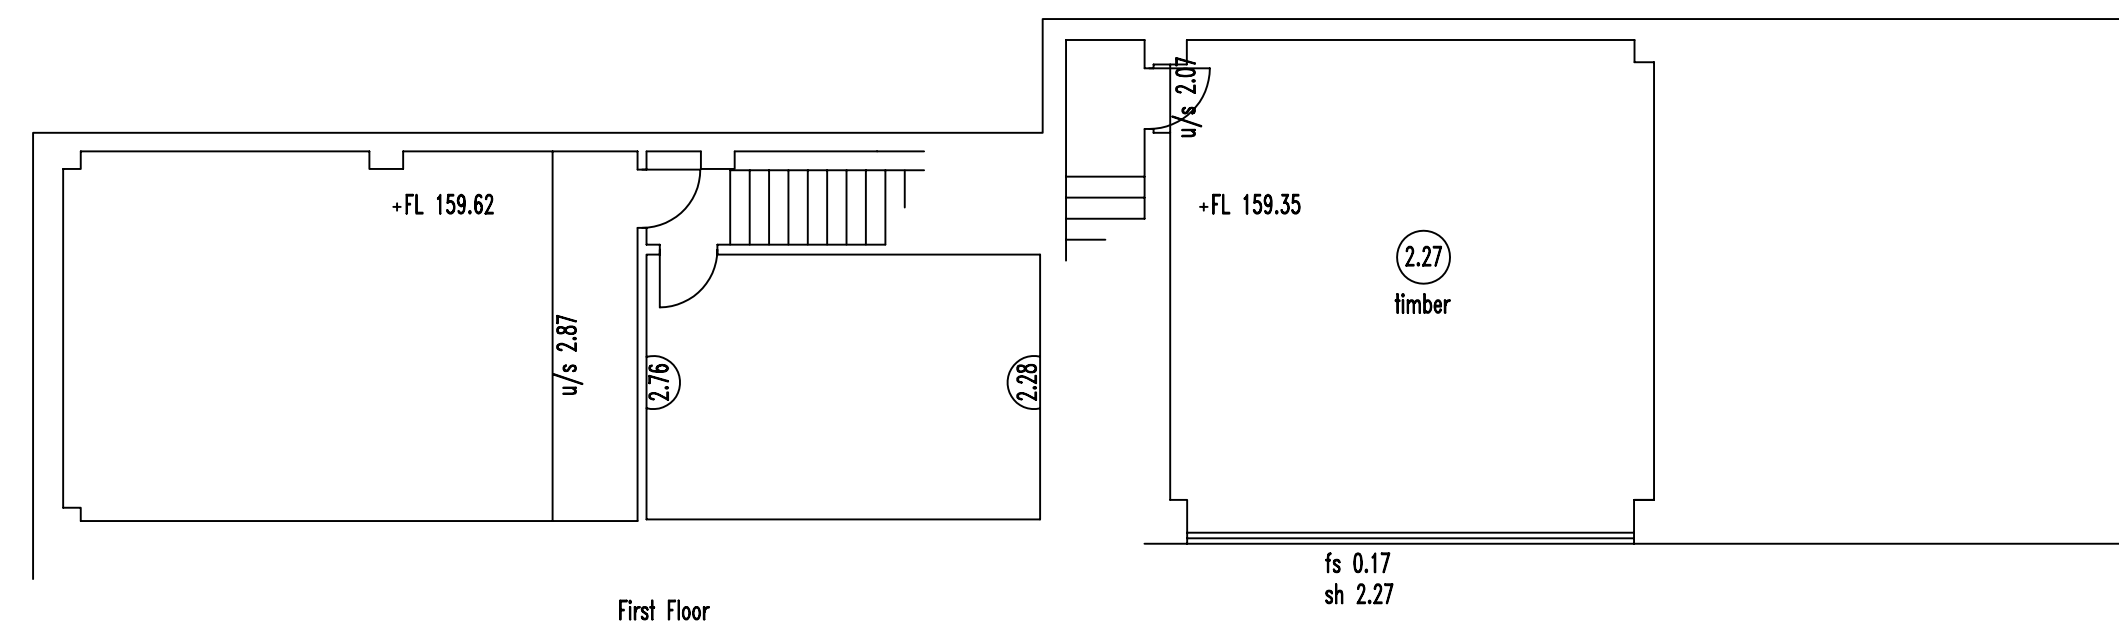


Level Datum = 155.00m

Level Datum = 155.00m

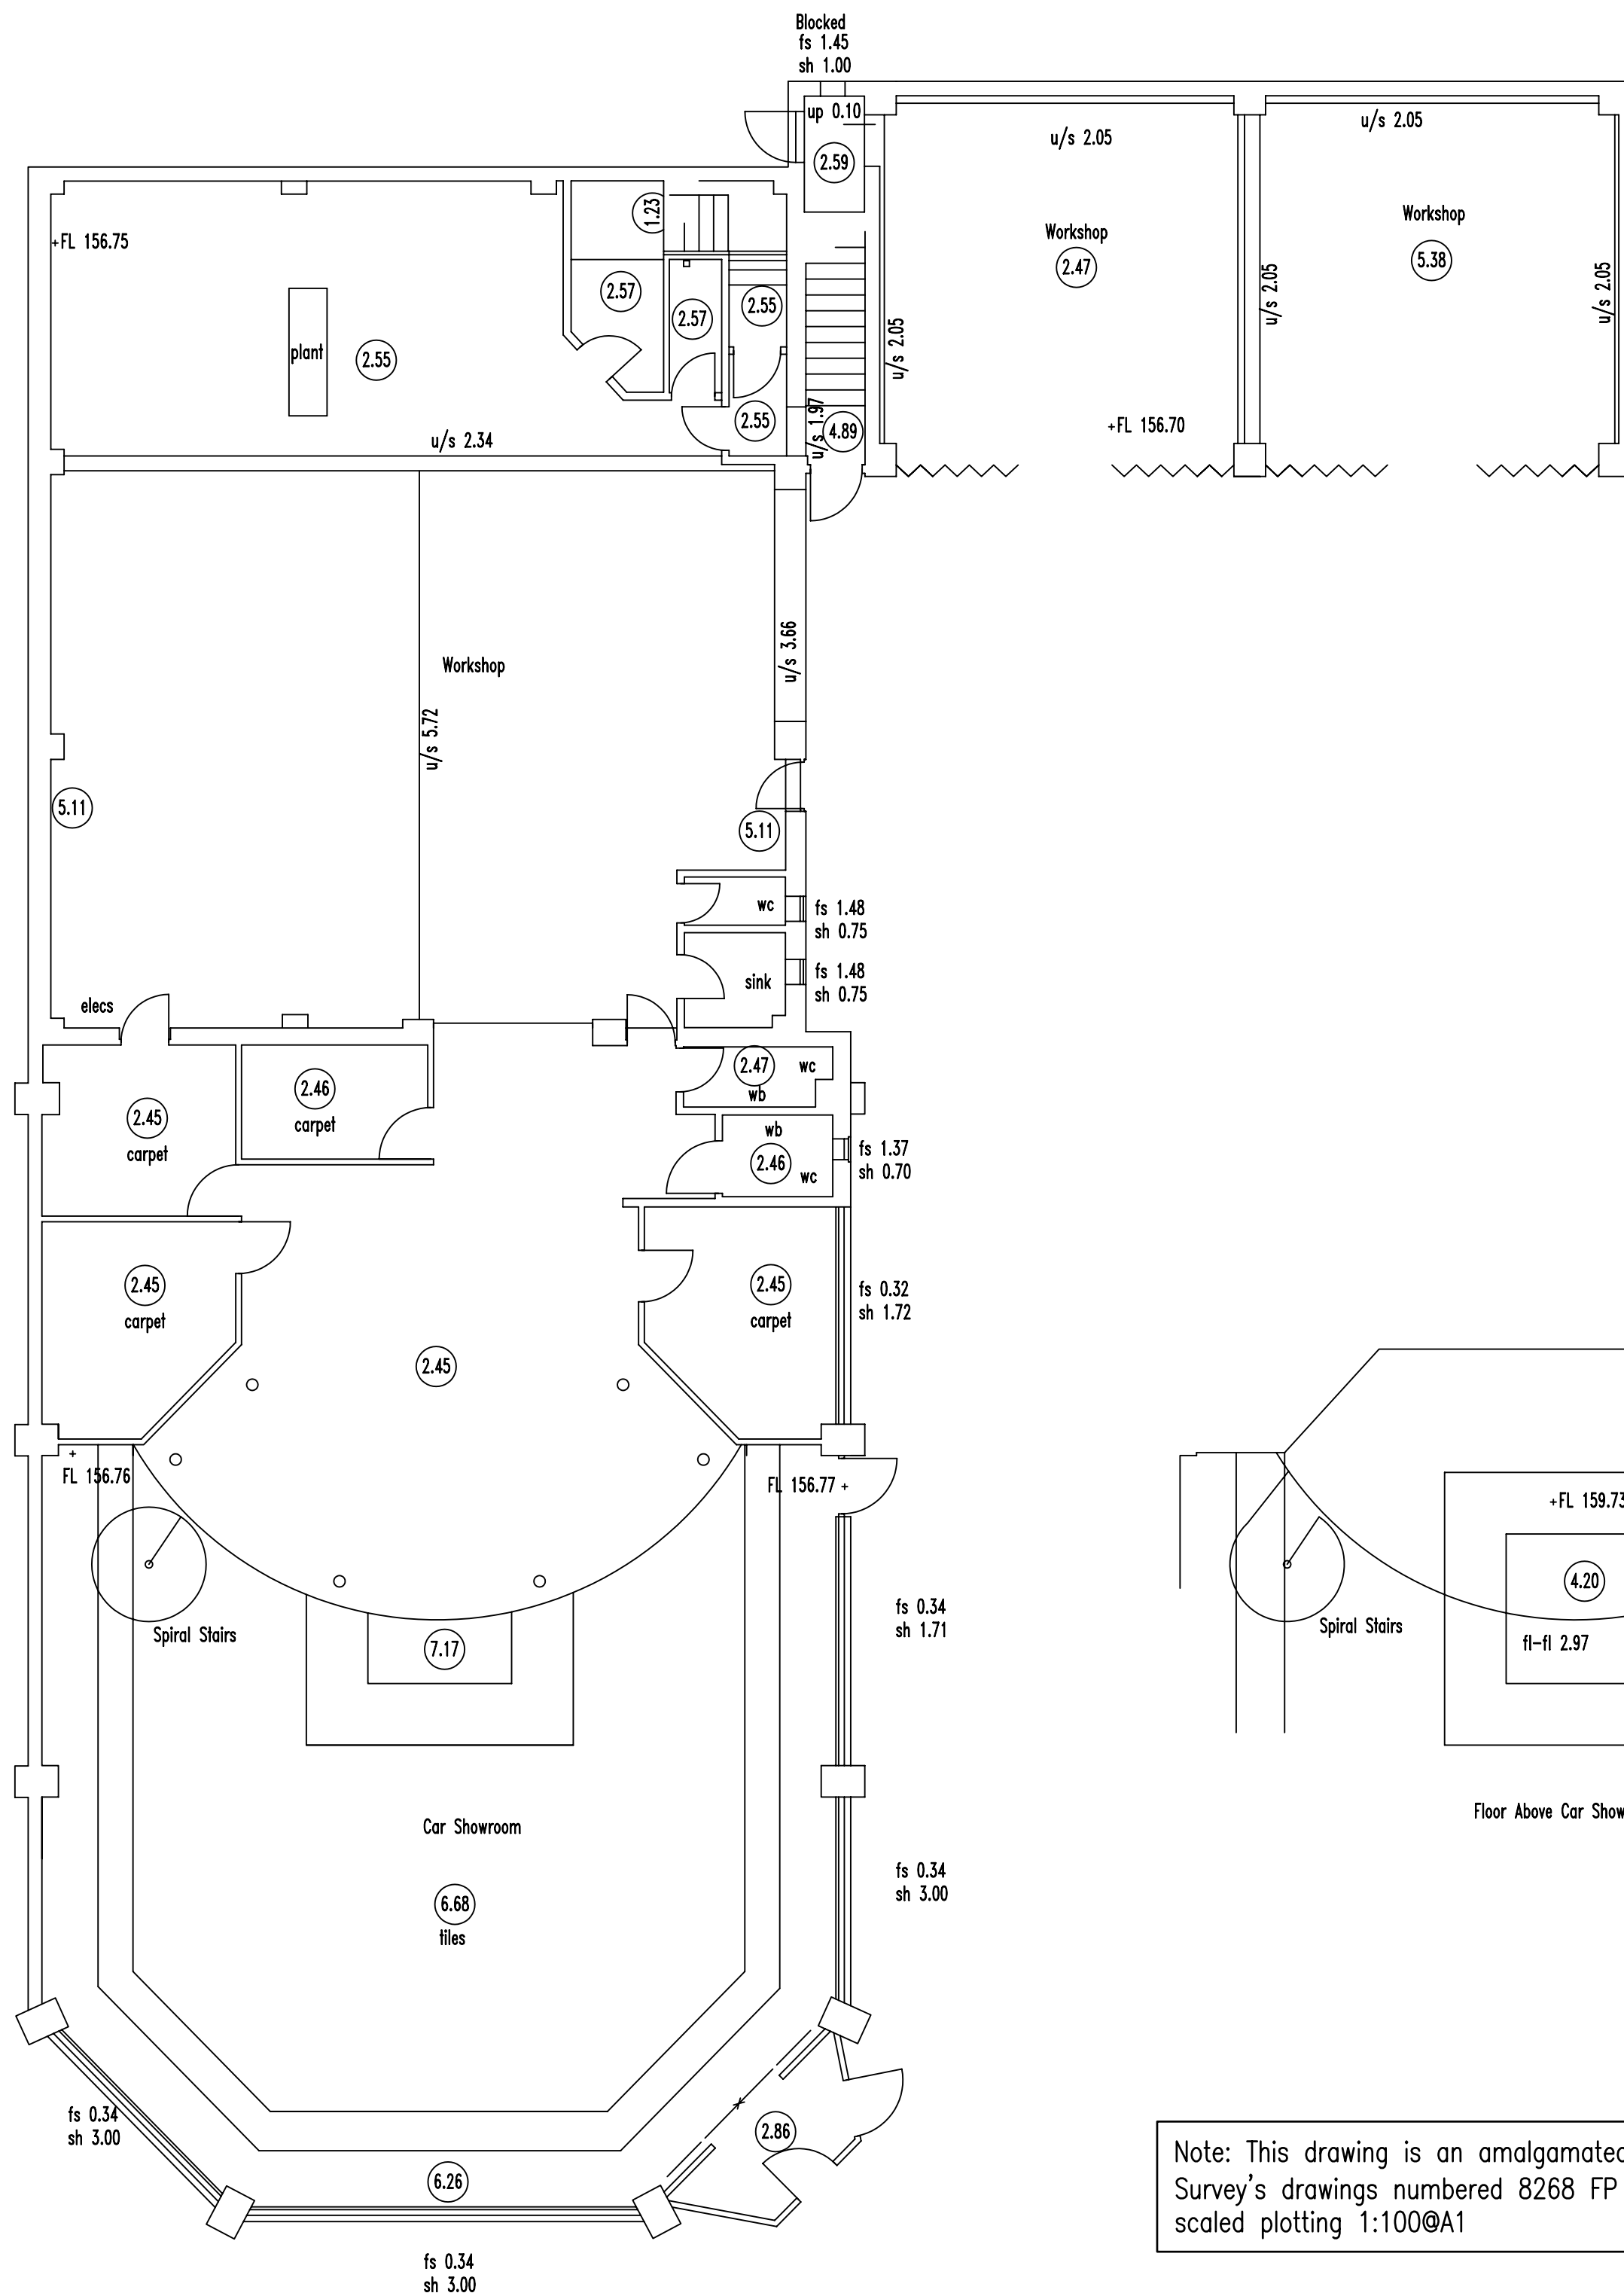

Note: This drawing is an amalgamated CAD file of Interlock Survey's drawings numbered 8268 FP and EL configured for scaled plotting 1:100@A1

Project
FERRARI, MASERATI, NICK WHALE
 BIRMINGHAM ROAD, MARLBROOK

TEMPORARY FACILITY

Axis 3 **Design**
 architectural design and services

2 Chapel Court
 Holly Walk
 Leamington Spa
 Warwickshire CV32 4YS
 Telephone : 01926 833570
 Fax : 01926 334808

Drawing
SURVEY PLANS AND ELEVATIONS

Scale	Date	Drawn
1:100@A1	16/06/08	KJC
Job No.	Drawing No.	Revision
P056	S1	

Survey