


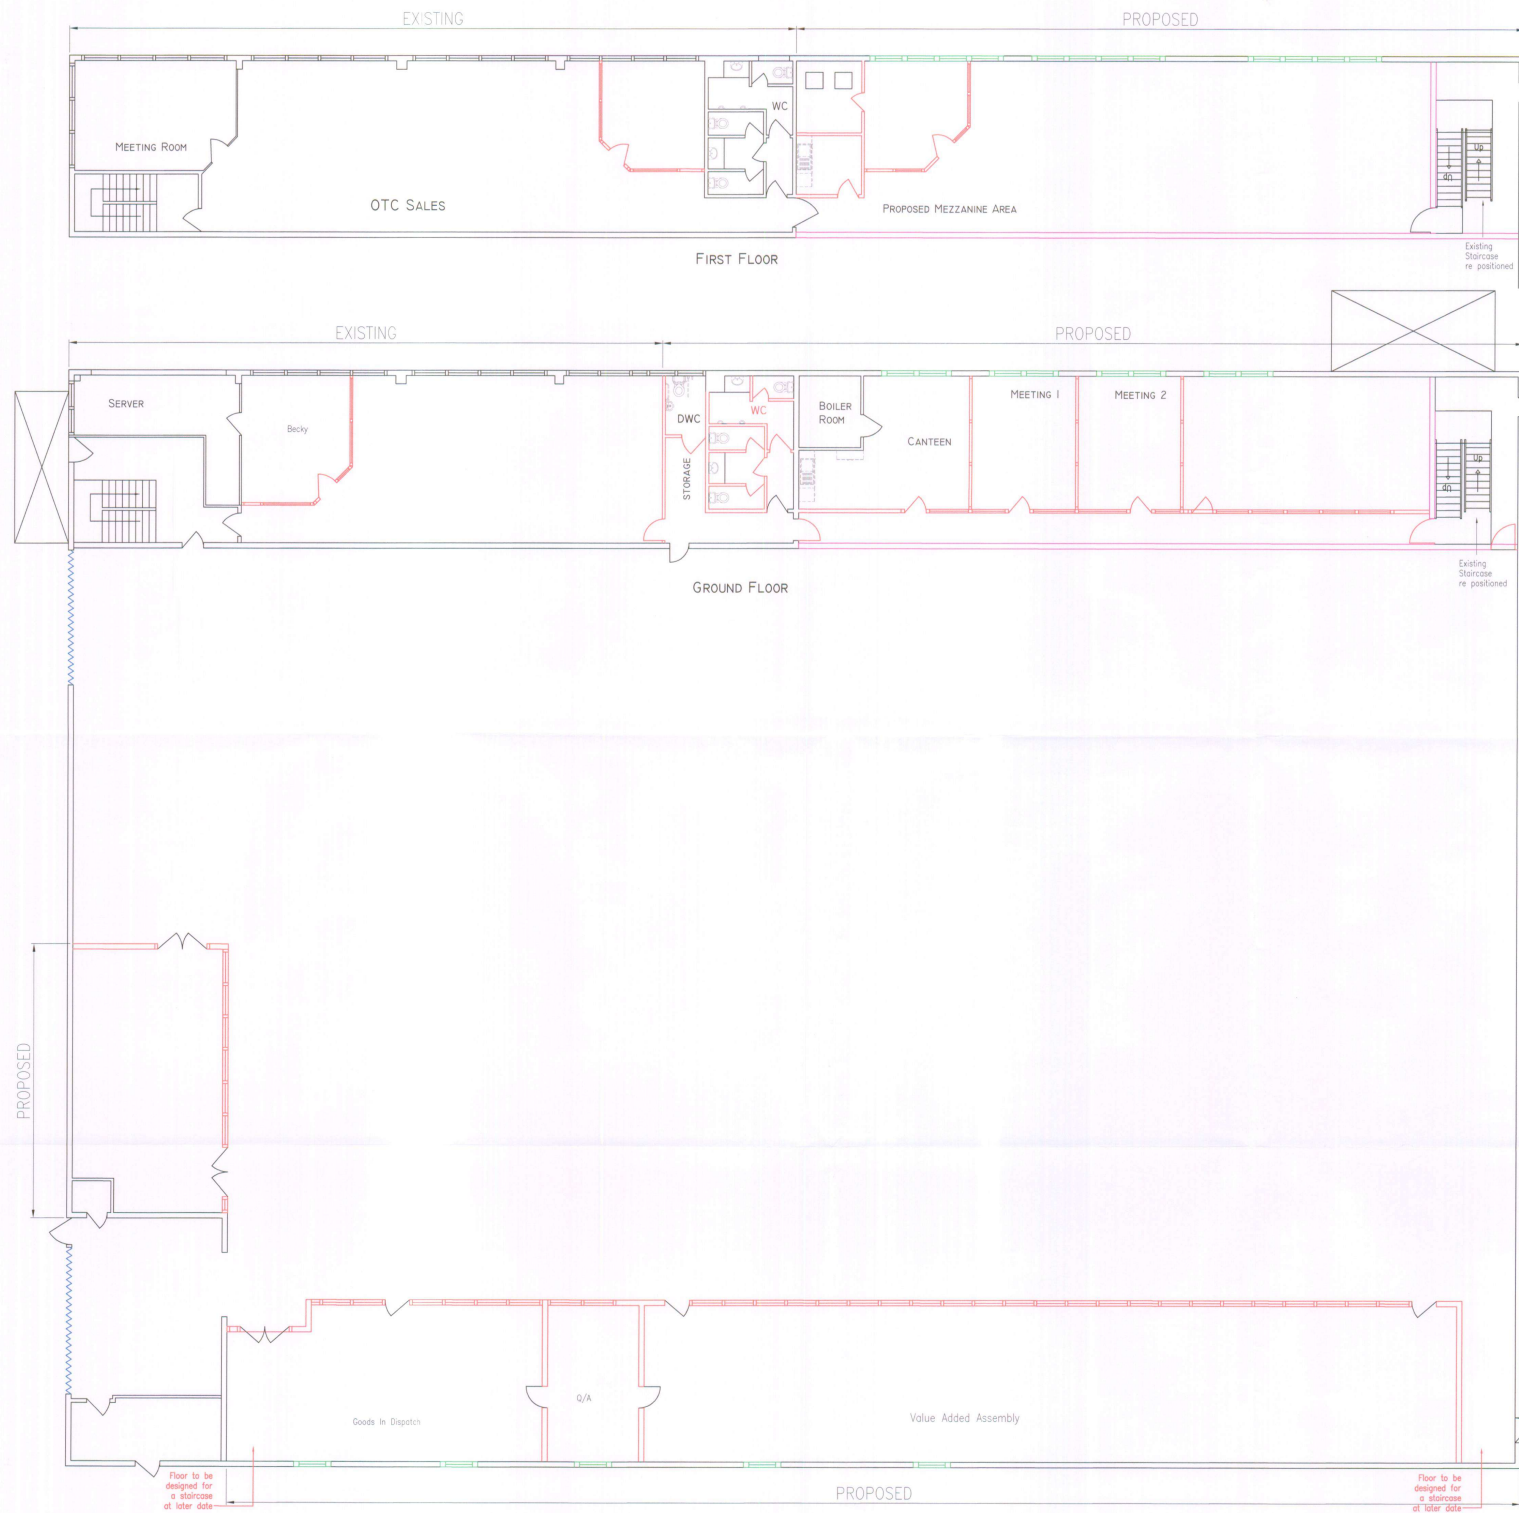

Kapco Areo Limited Bedford Place Petersfield Hampshire GU32 3LJ
Site Address: Bradford House Frenchman's Road Petersfield
Scale: A1 sheet 1:100
Date Drawn: 07/09/2011
Drawn By: RH/AJ
Project No: Q36888 / Block Plan