
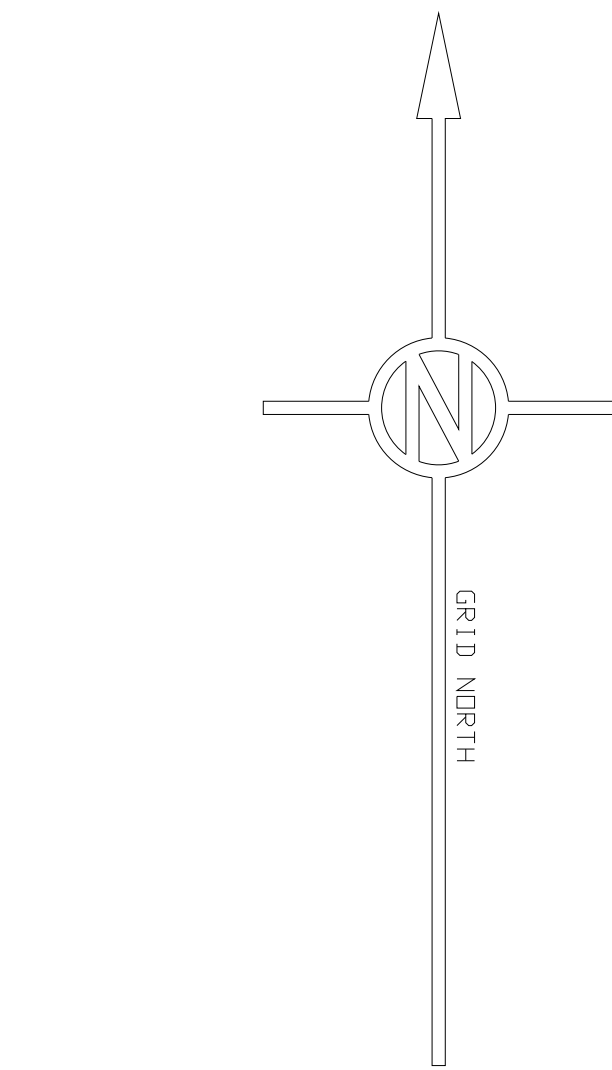


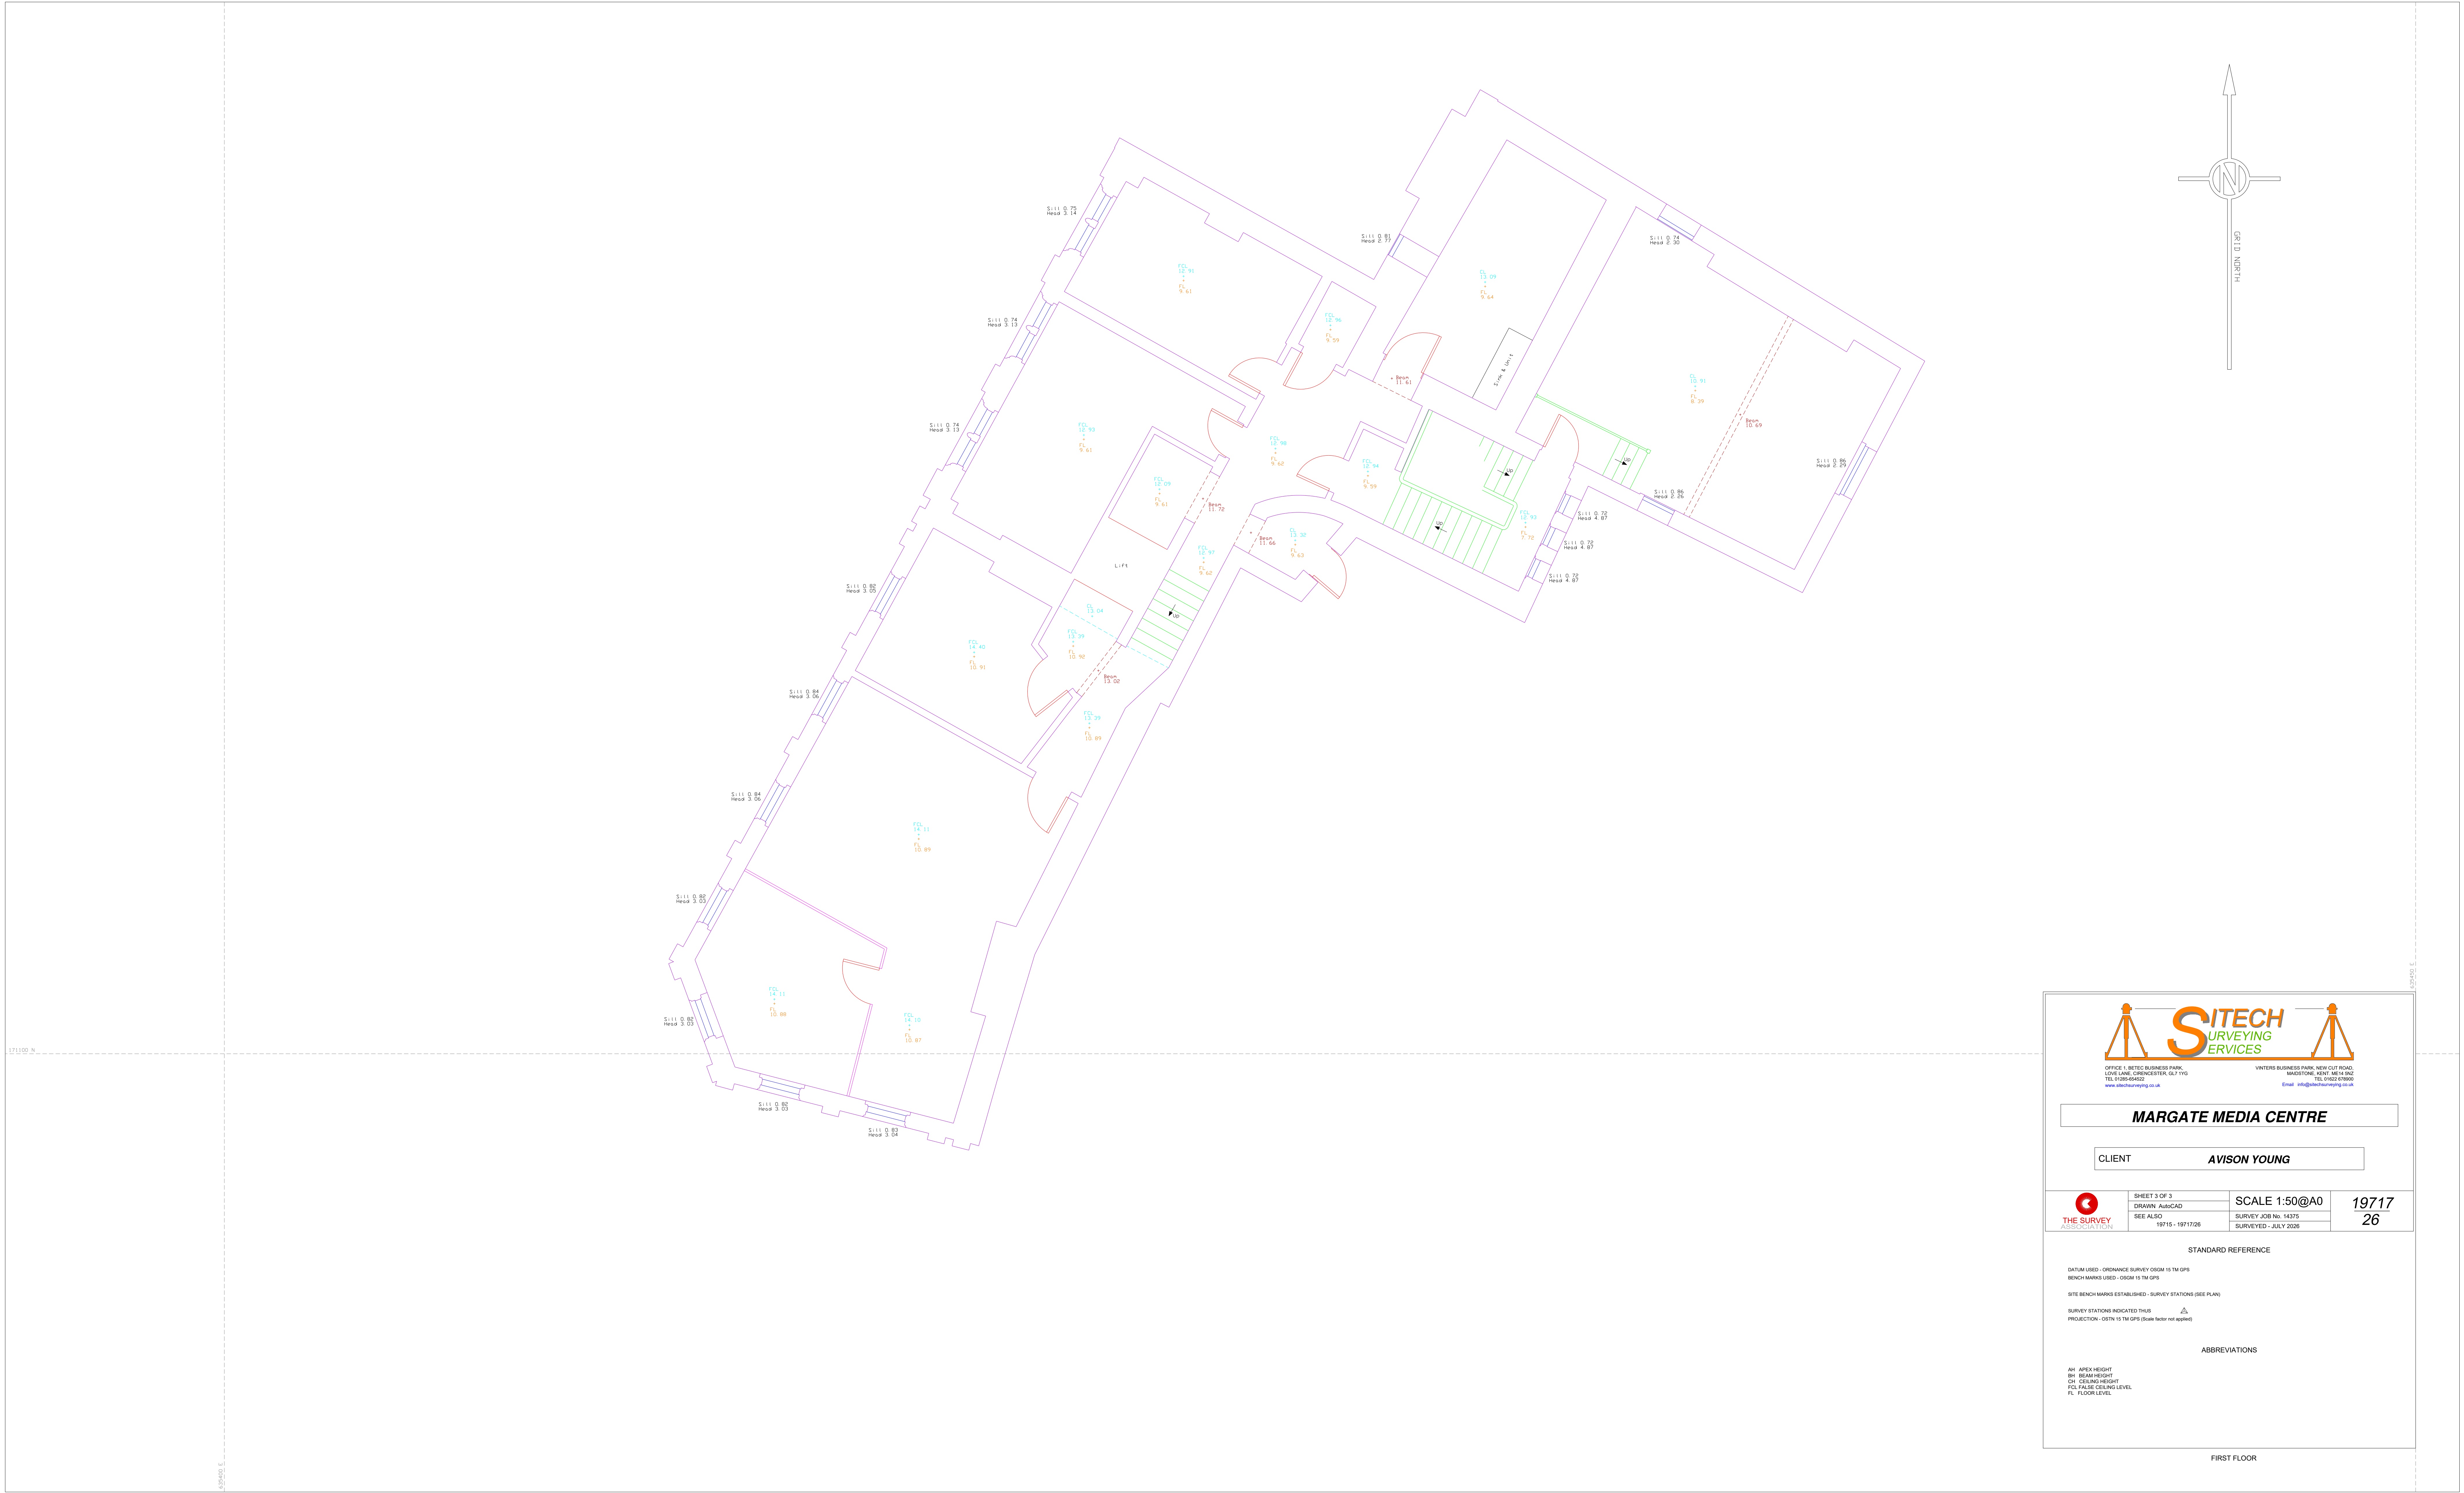

OFFICE: 1, BETCO BUSINESS PARK,
LOVE LANE, CHINGFORD, GL1 1YG
TEL: 0203058400
www.sitechsurveying.co.uk

UNITED BUSINESS PARK, NEW CUT ROAD,
MAIDSTONE, KENT, ME14 2BG
TEL: 01622 33880
Email: info@sitechsurveying.co.uk

MARGATE MEDIA CENTRE

CLIENT **AVISON YOUNG**

	SHEET 3 OF 3	SCALE 1:50@A0	19717 26
	DRAWN: AUTOCAD	SURVEY JOB No: 14375	
SEE ALSO	19715 - 19717/26	SURVEYED - JULY 2005	

STANDARD REFERENCE

DATUM USED - ORDNANCE SURVEY ORIGIN TO TM GPS

BENCH MARKS USED - ODSB 19 TO GPS

SITE BENCH MARKS ESTABLISHED - SURVEY STATIONS (SEE PLAN)

SURVEY STATIONS INDICATED THUS

PROJECTION - OSTN TO TM GPS (Scale factor not applied)

ABBREVIATIONS

AN: APEX HEIGHT
BN: BENCH HEIGHT
CH: CEILING HEIGHT
FL: FLOOR LEVEL

FIRST FLOOR