
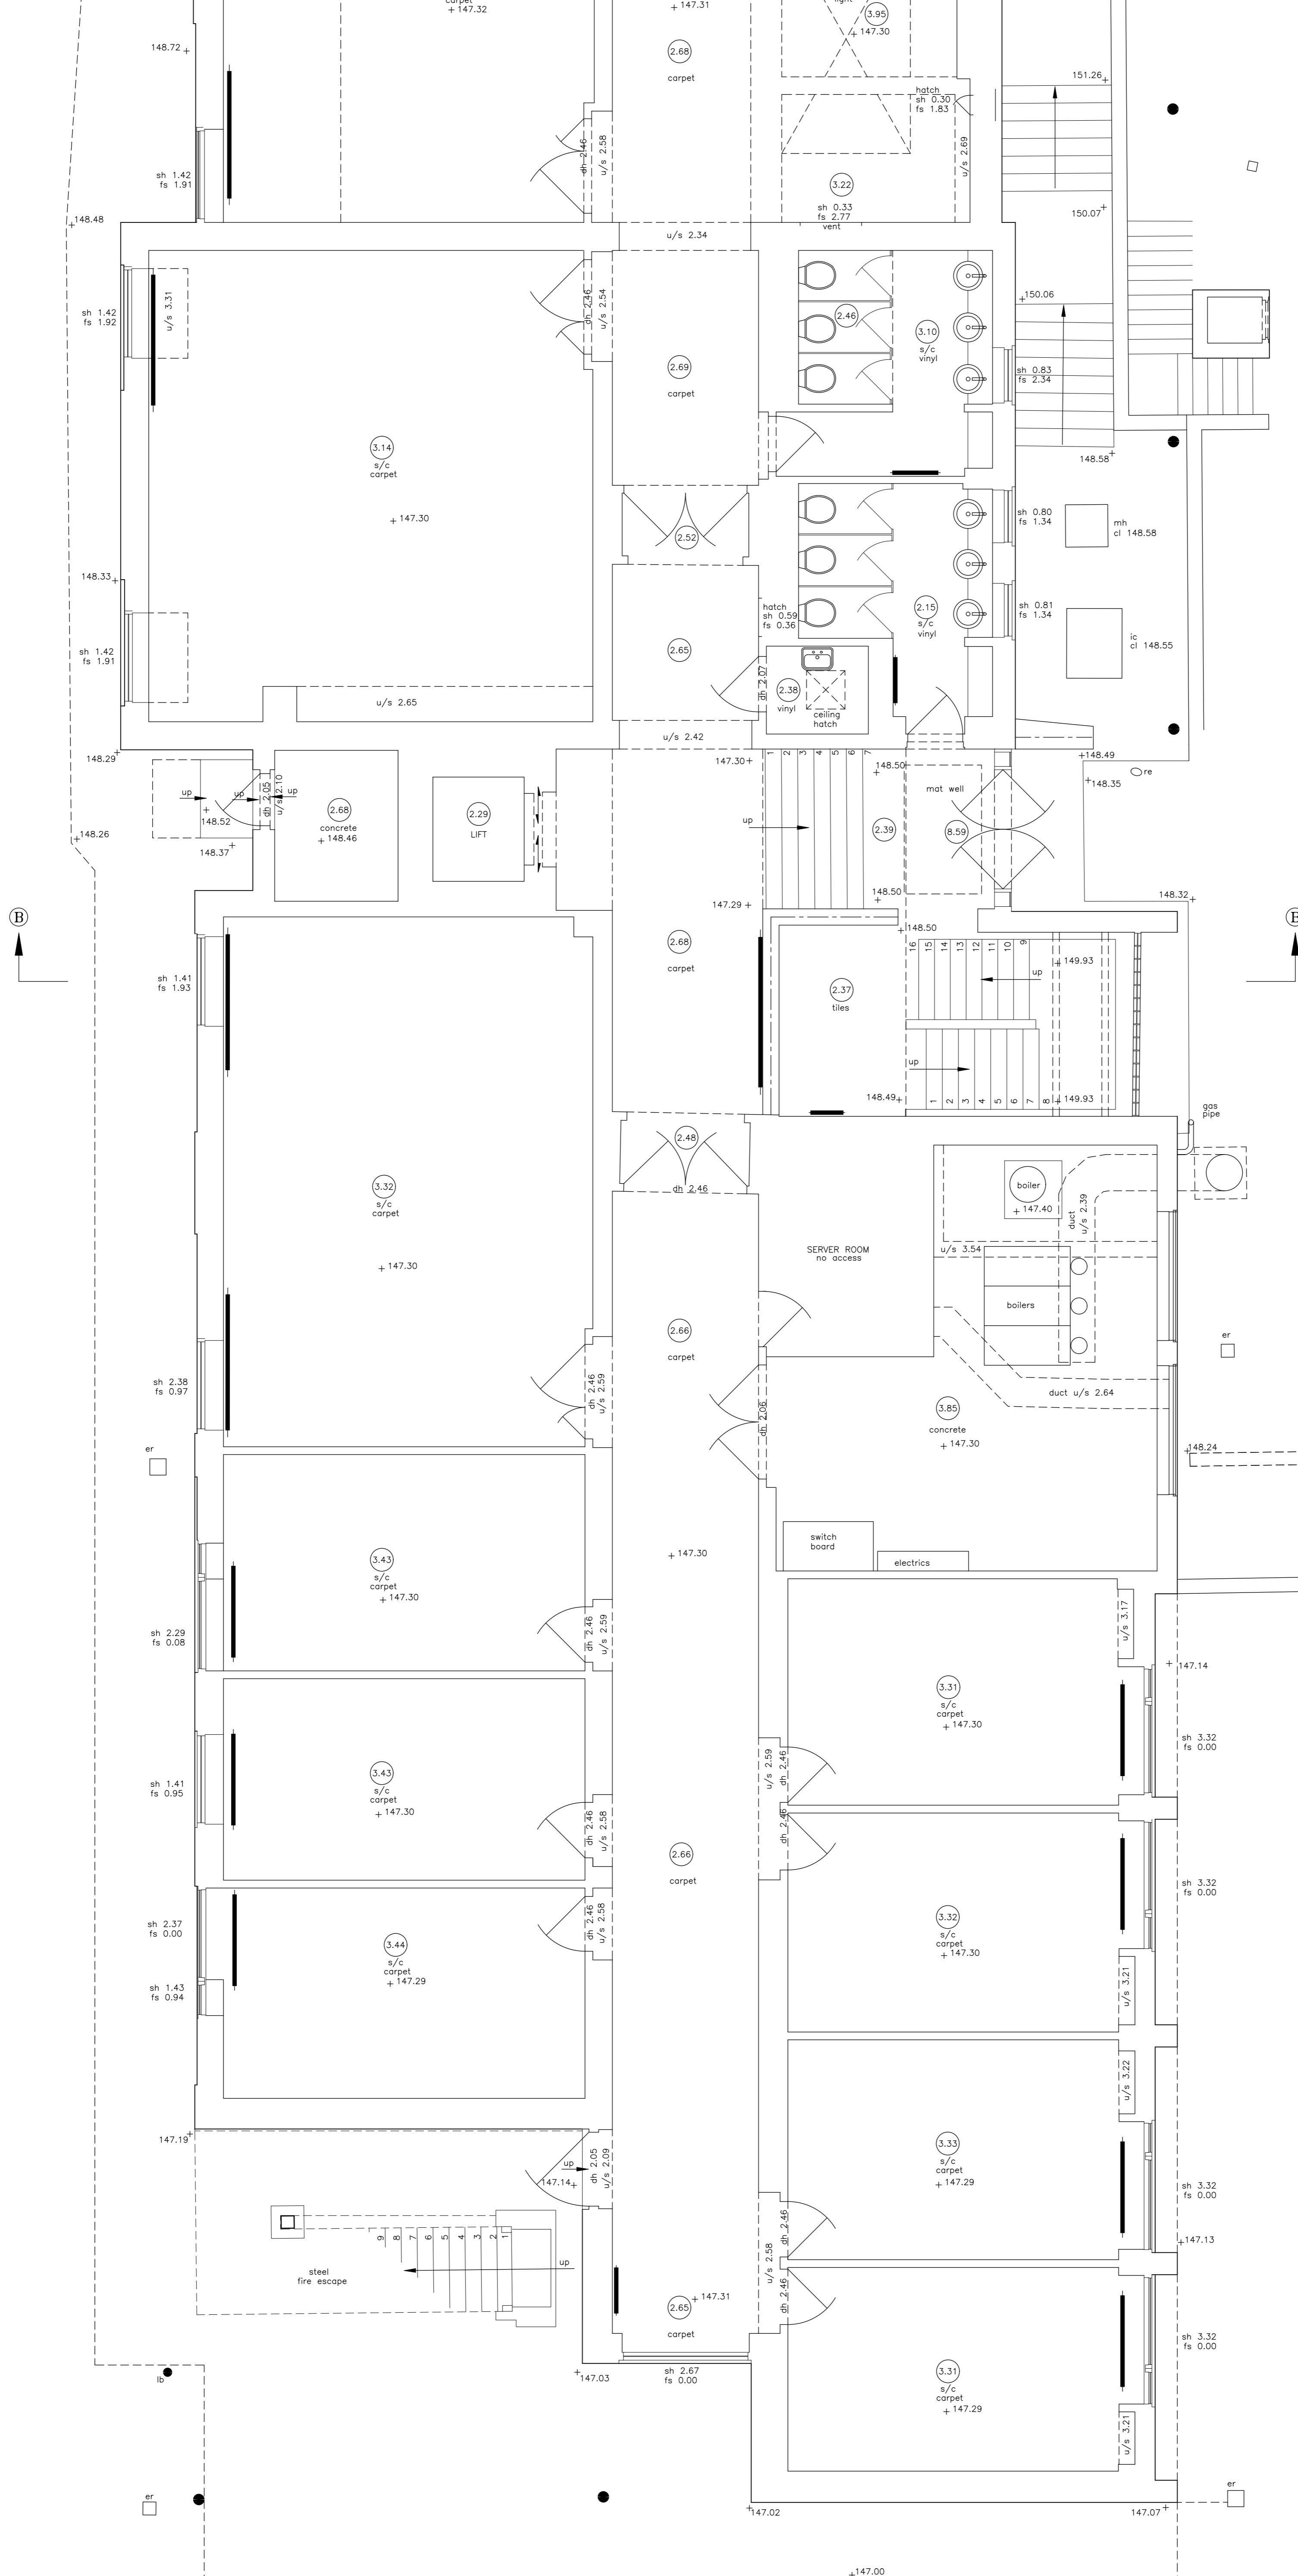


Notes


ALL LEVELS ARE IN METRES DERIVED FROM GPS TRANSFORMATION OSGM15
 THE CO-ORDINATES ARE DERIVED FROM THE ORDNANCE SURVEY ACTIVE STATION NETWORK OSTN15 (BASE STATION ST02)

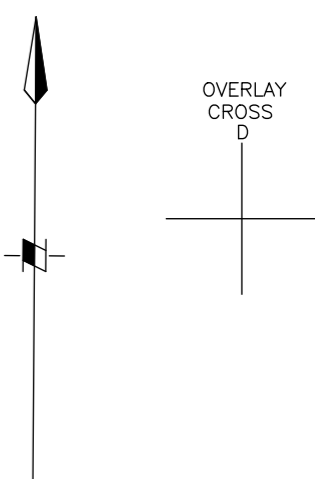

B

B

LOWER GROUND FLOOR

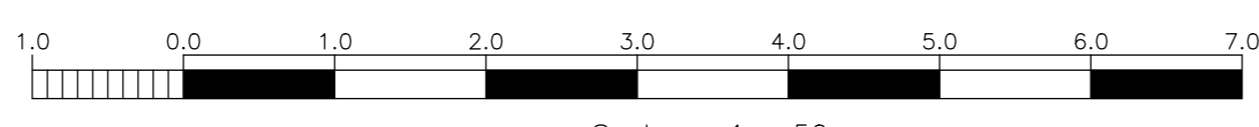

Scale = 1 : 50

AS/HL/RW © ON CENTRE SURVEYS LTD. 2026

job **BEVAN HOUSE & RAVENSBURY HOUSE**
 9 WESTBOURNE ROAD
 BIRMINGHAM
 WEST MIDLANDS
 B15 3TR

client **CALTHORPE ESTATES**

title LOWER GROUND FLOOR BEVAN HOUSE	dwg no. 29785A/8/1
--	-----------------------

scale 1/50	date 9th March 2026
---------------	------------------------

ON CENTRE SURVEYS LTD.
 LAND & BUILDING SURVEYORS
 GEODETIC ENGINEERS
 2 CHARLES COURT, BUDBROOKE ROAD, WARWICK CV34 5LZ
 TEL: 01926 494294
 E-MAIL: info@oncentre.co.uk
 A member of The Survey Association

