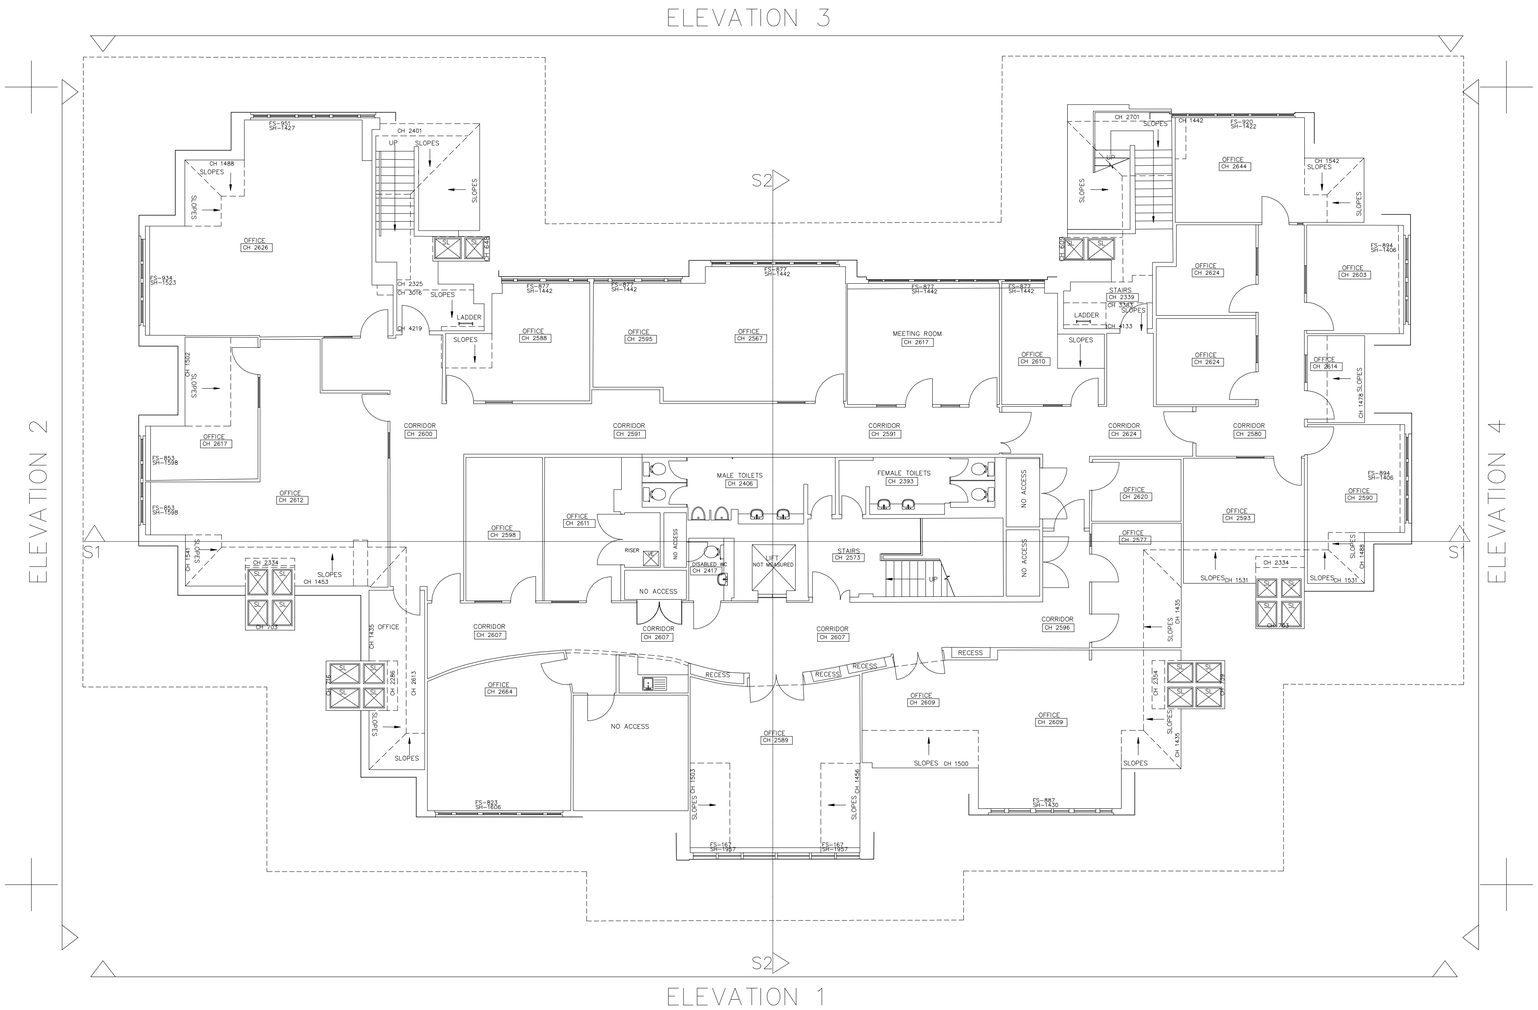

SECOND FLOOR

0 2 10 meters

DRAWING NOTES

This drawing (and associated documentation) is the copyright of UKBS LTD. The drawing (or any part thereof) may not be copied, transmitted or disclosed to any third party or unauthorised person without the prior written consent of the UK Building Surveys.

Under no circumstances should dimensions be scaled from this drawing, all dimensions and/or levels are to be checked on-site prior to the commencement of any work. Any discrepancies to be reported to the UKBS Offices or representative thereof immediately. 'IF IN DOUBT ASK'.

Rev	Description	Drawn	Date	Ch'k'd	App'd
.	.	.	.	.	.

AMENDMENTS

UK Building Surveys
15 Broughton Close
Grappenhall Heys
Warrington
Cheshire WA4 3DR
Telephone 01925 960048
Mobile 07731 333 637
E-mail: mark.sutcliffe@ukbuildingsurveys.co.uk

Site

Title

Dorset House,
Regents Park,
Leatherhead,
KT22 7PL

Surveyed By	MAS	Checked By	HJH	Status	Original
Designed by	____	Approved By	MAS		
Scale	1:100	Sheet Size	A1	CAD File	UKBS-9311
Date	10/01/2023	Existing Second Floor Plan			
Drawing No	UKBS-9311	Rev			