

NB: FLOOR LEVELS AND STRUCTURE TO BE FURTHER COORDINATED FOLLOWING REVIEW OF POST STRIP SURVEY

Key Plan



Do not scale from this drawing. Check drawing on receipt and immediately report any discrepancies to the Architect. Verify all dimensions and levels on site prior to construction. The contents of this drawing are Stiff + Trevillion Architects Ltd. Copyright and shall not be re-used without their written permission.

Notes:

- Denotes New Structure
- Denotes Existing Structure

Notes:

1. To be read in conjunction with all existing building information, reports, surveys.
2. Any variation to existing conditions found on site to be confirmed with Architect and Structural Engineer before commencement of works to the area involved.
3. Thickness of existing facade is to be established after soft strip-out. Line of inside face indicates position of existing finishes. Floor levels and structure to be further coordinated following review of post strip survey.
4. Existing Terraces SSLs to be verified on site by the main contractor.
5. To be read in conjunction with all Stage 4 Consultant's Documentations.

Rev	Date	Description
C1	25/03/22	STAGE 5 ISSUE - REVISIONS
CO	18/03/22	STAGE 5 ISSUE
3	17/11/21	STAGE 4 REVISION
2	06/08/21	STAGE 4 ISSUE
1	06/04/21	STAGE 3 ISSUE

## Stiff + Trevillion

Stiff + Trevillion Architects Ltd  
16 Woodfield Road  
London W9 2BE

T +44(0)20 8960 5550  
mail@stiffandtrevillion.com  
www.stiffandtrevillion.com

Client  
**Pilgrim Street London Real Estate SARL**

Project  
**11 Pilgrim Street**

Drawing Status

**STAGE 5**


Drawing Title

**Seventh Floor Plan**

Draw By: DD Checked By: ND Suitability Code: C1 Revision: C1

Project No: 4467 Date: 01/06/2020 Scale @ A1: 1 : 100

Code: 4467 -ST - PR - 02-107

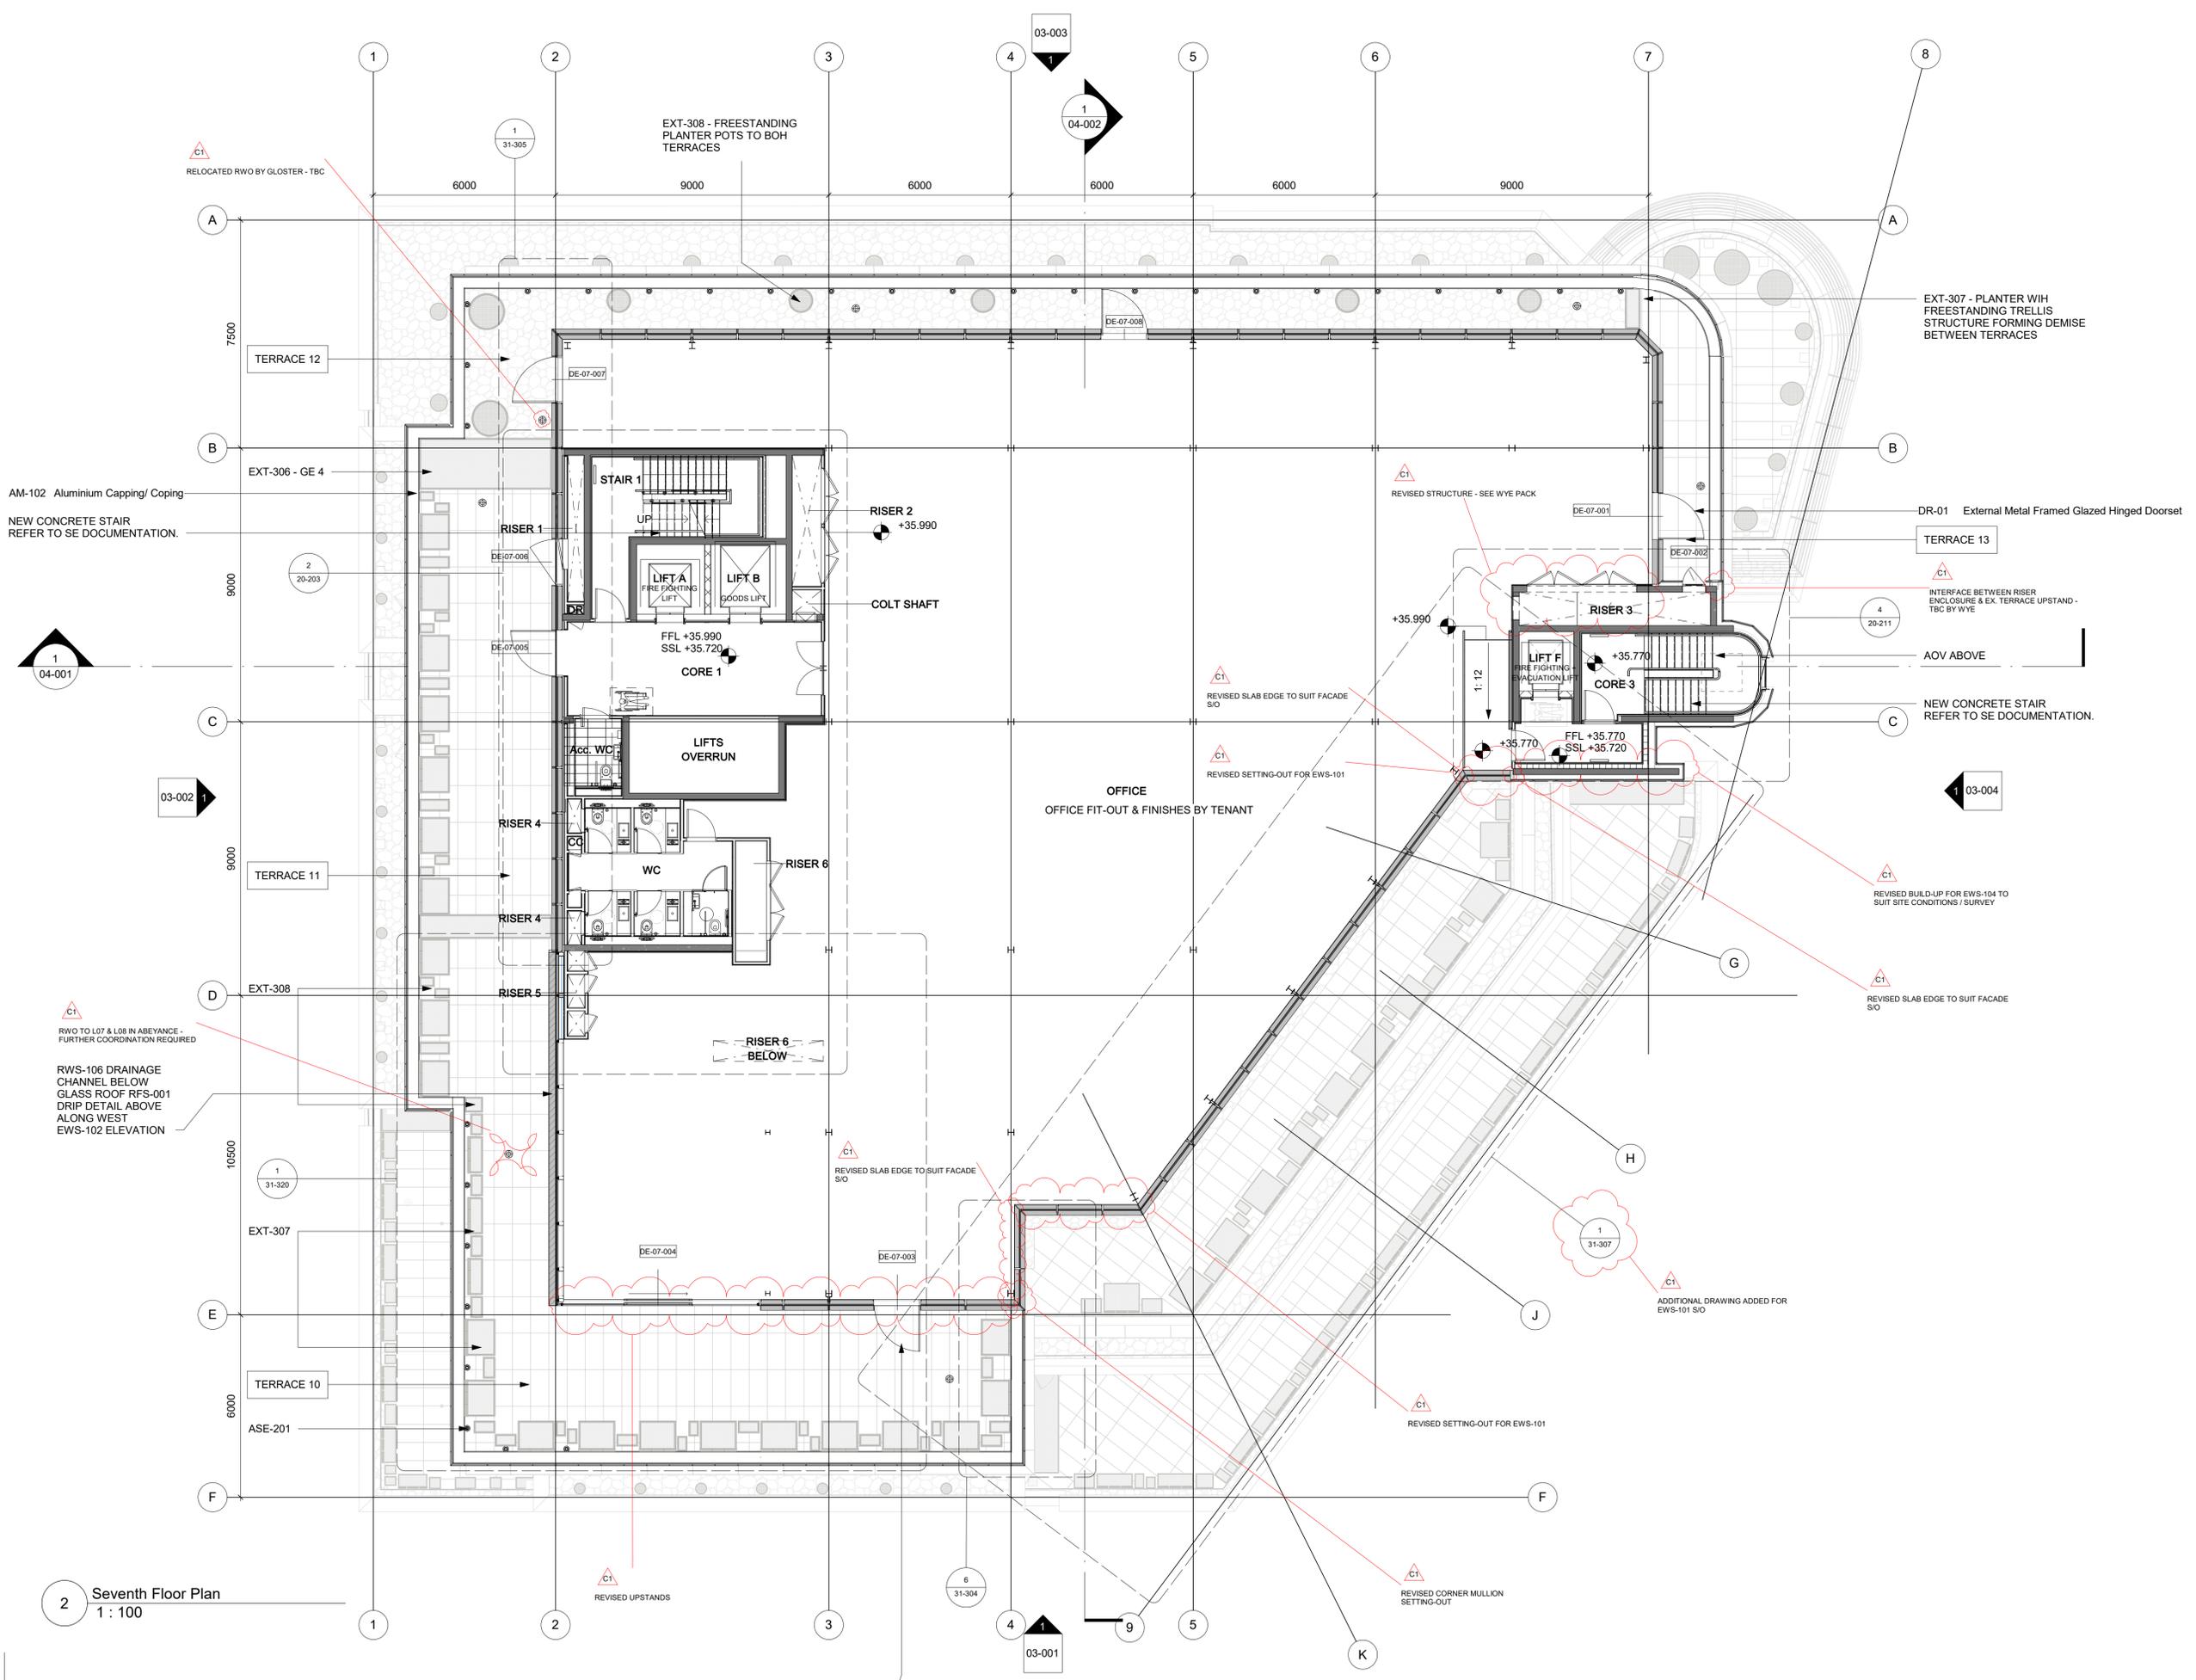

2 Seventh Floor Plan  
1 : 100

DR-01 External Metal Framed Glazed Hinged Doorset