


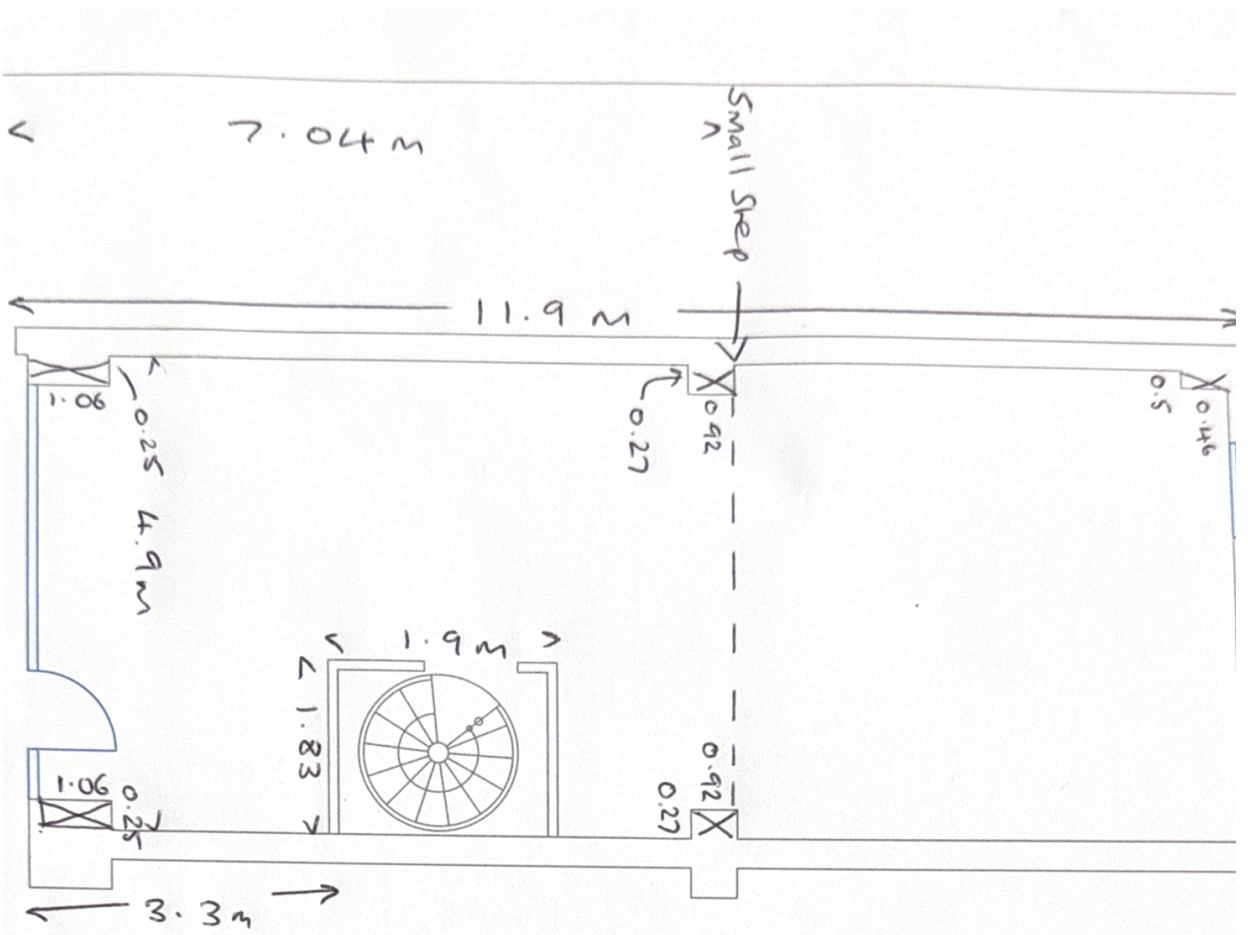

Basement

