


south court
FIRST FLOOR

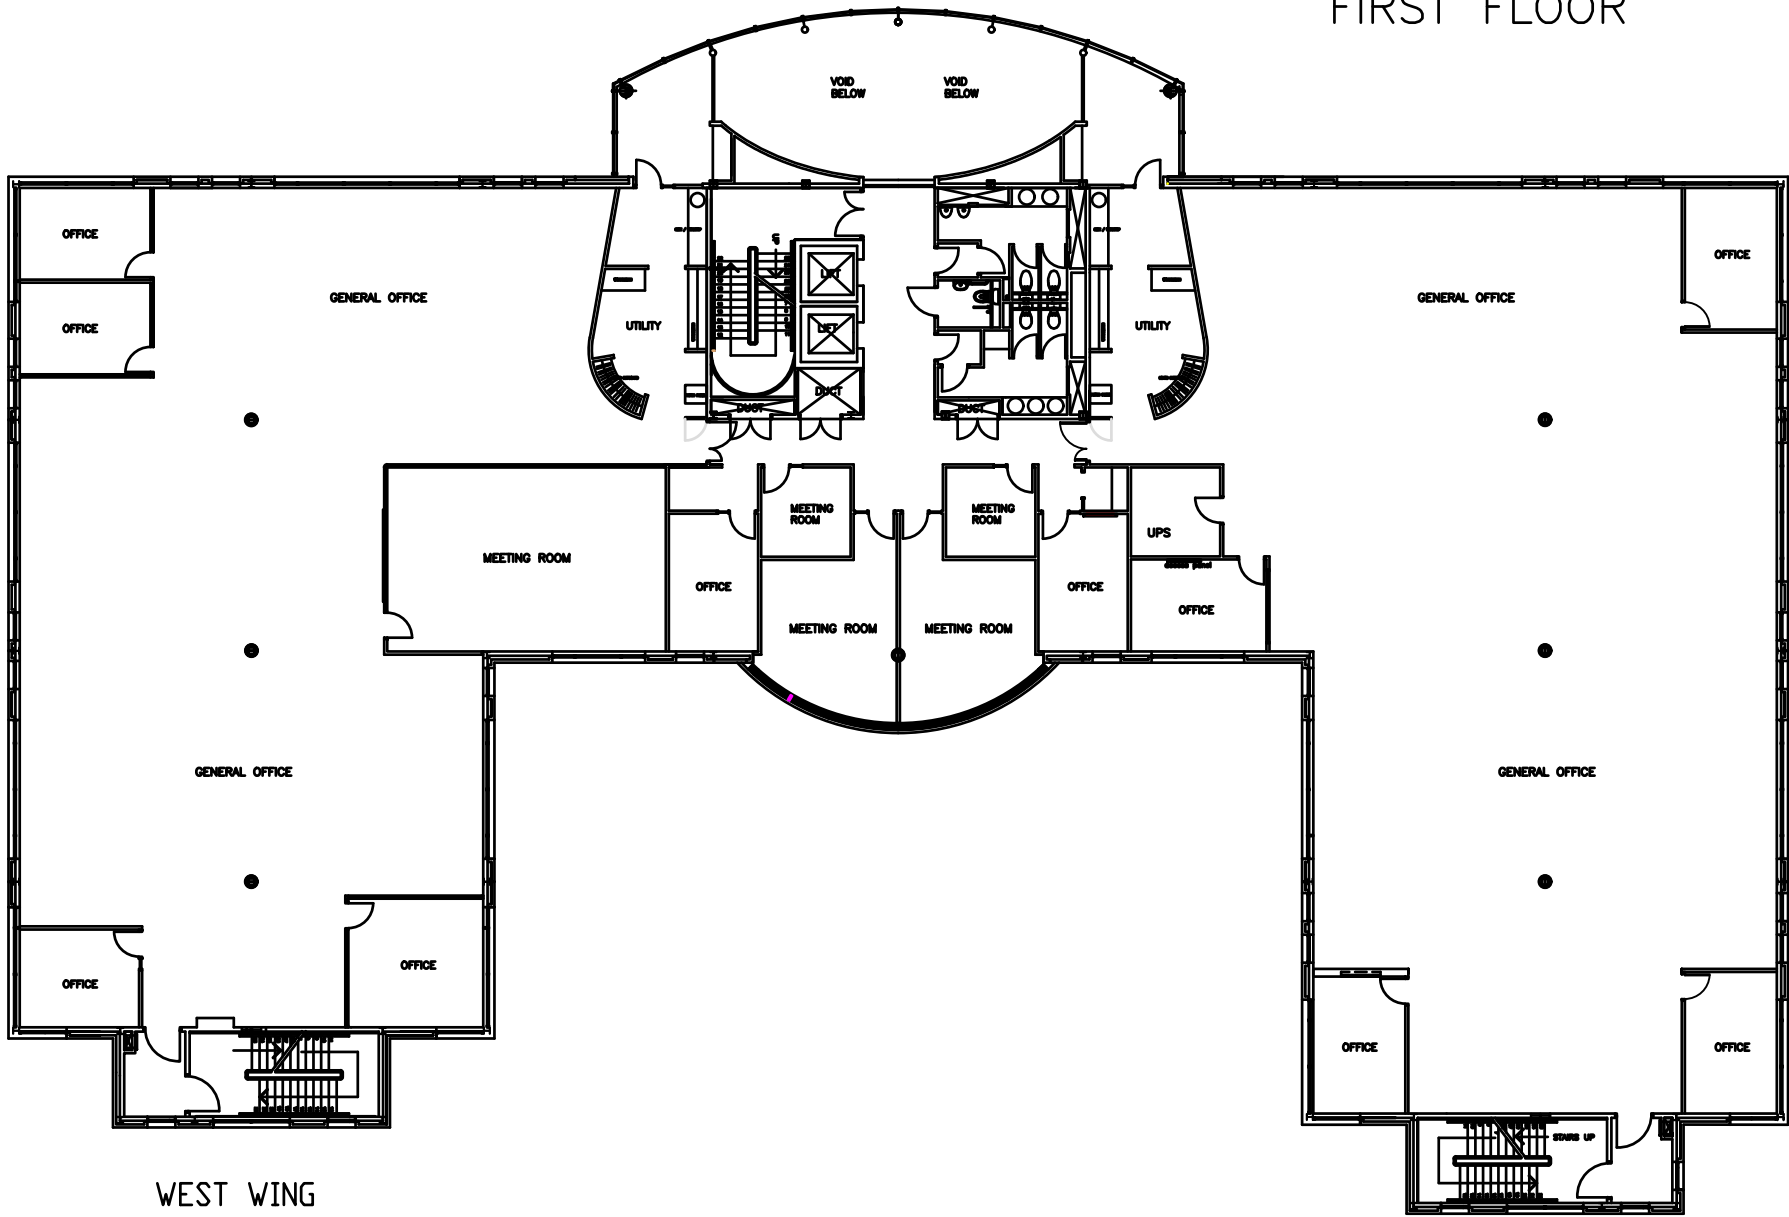

WEST WING

PLAN AS EXISTING 2021

EAST WING