



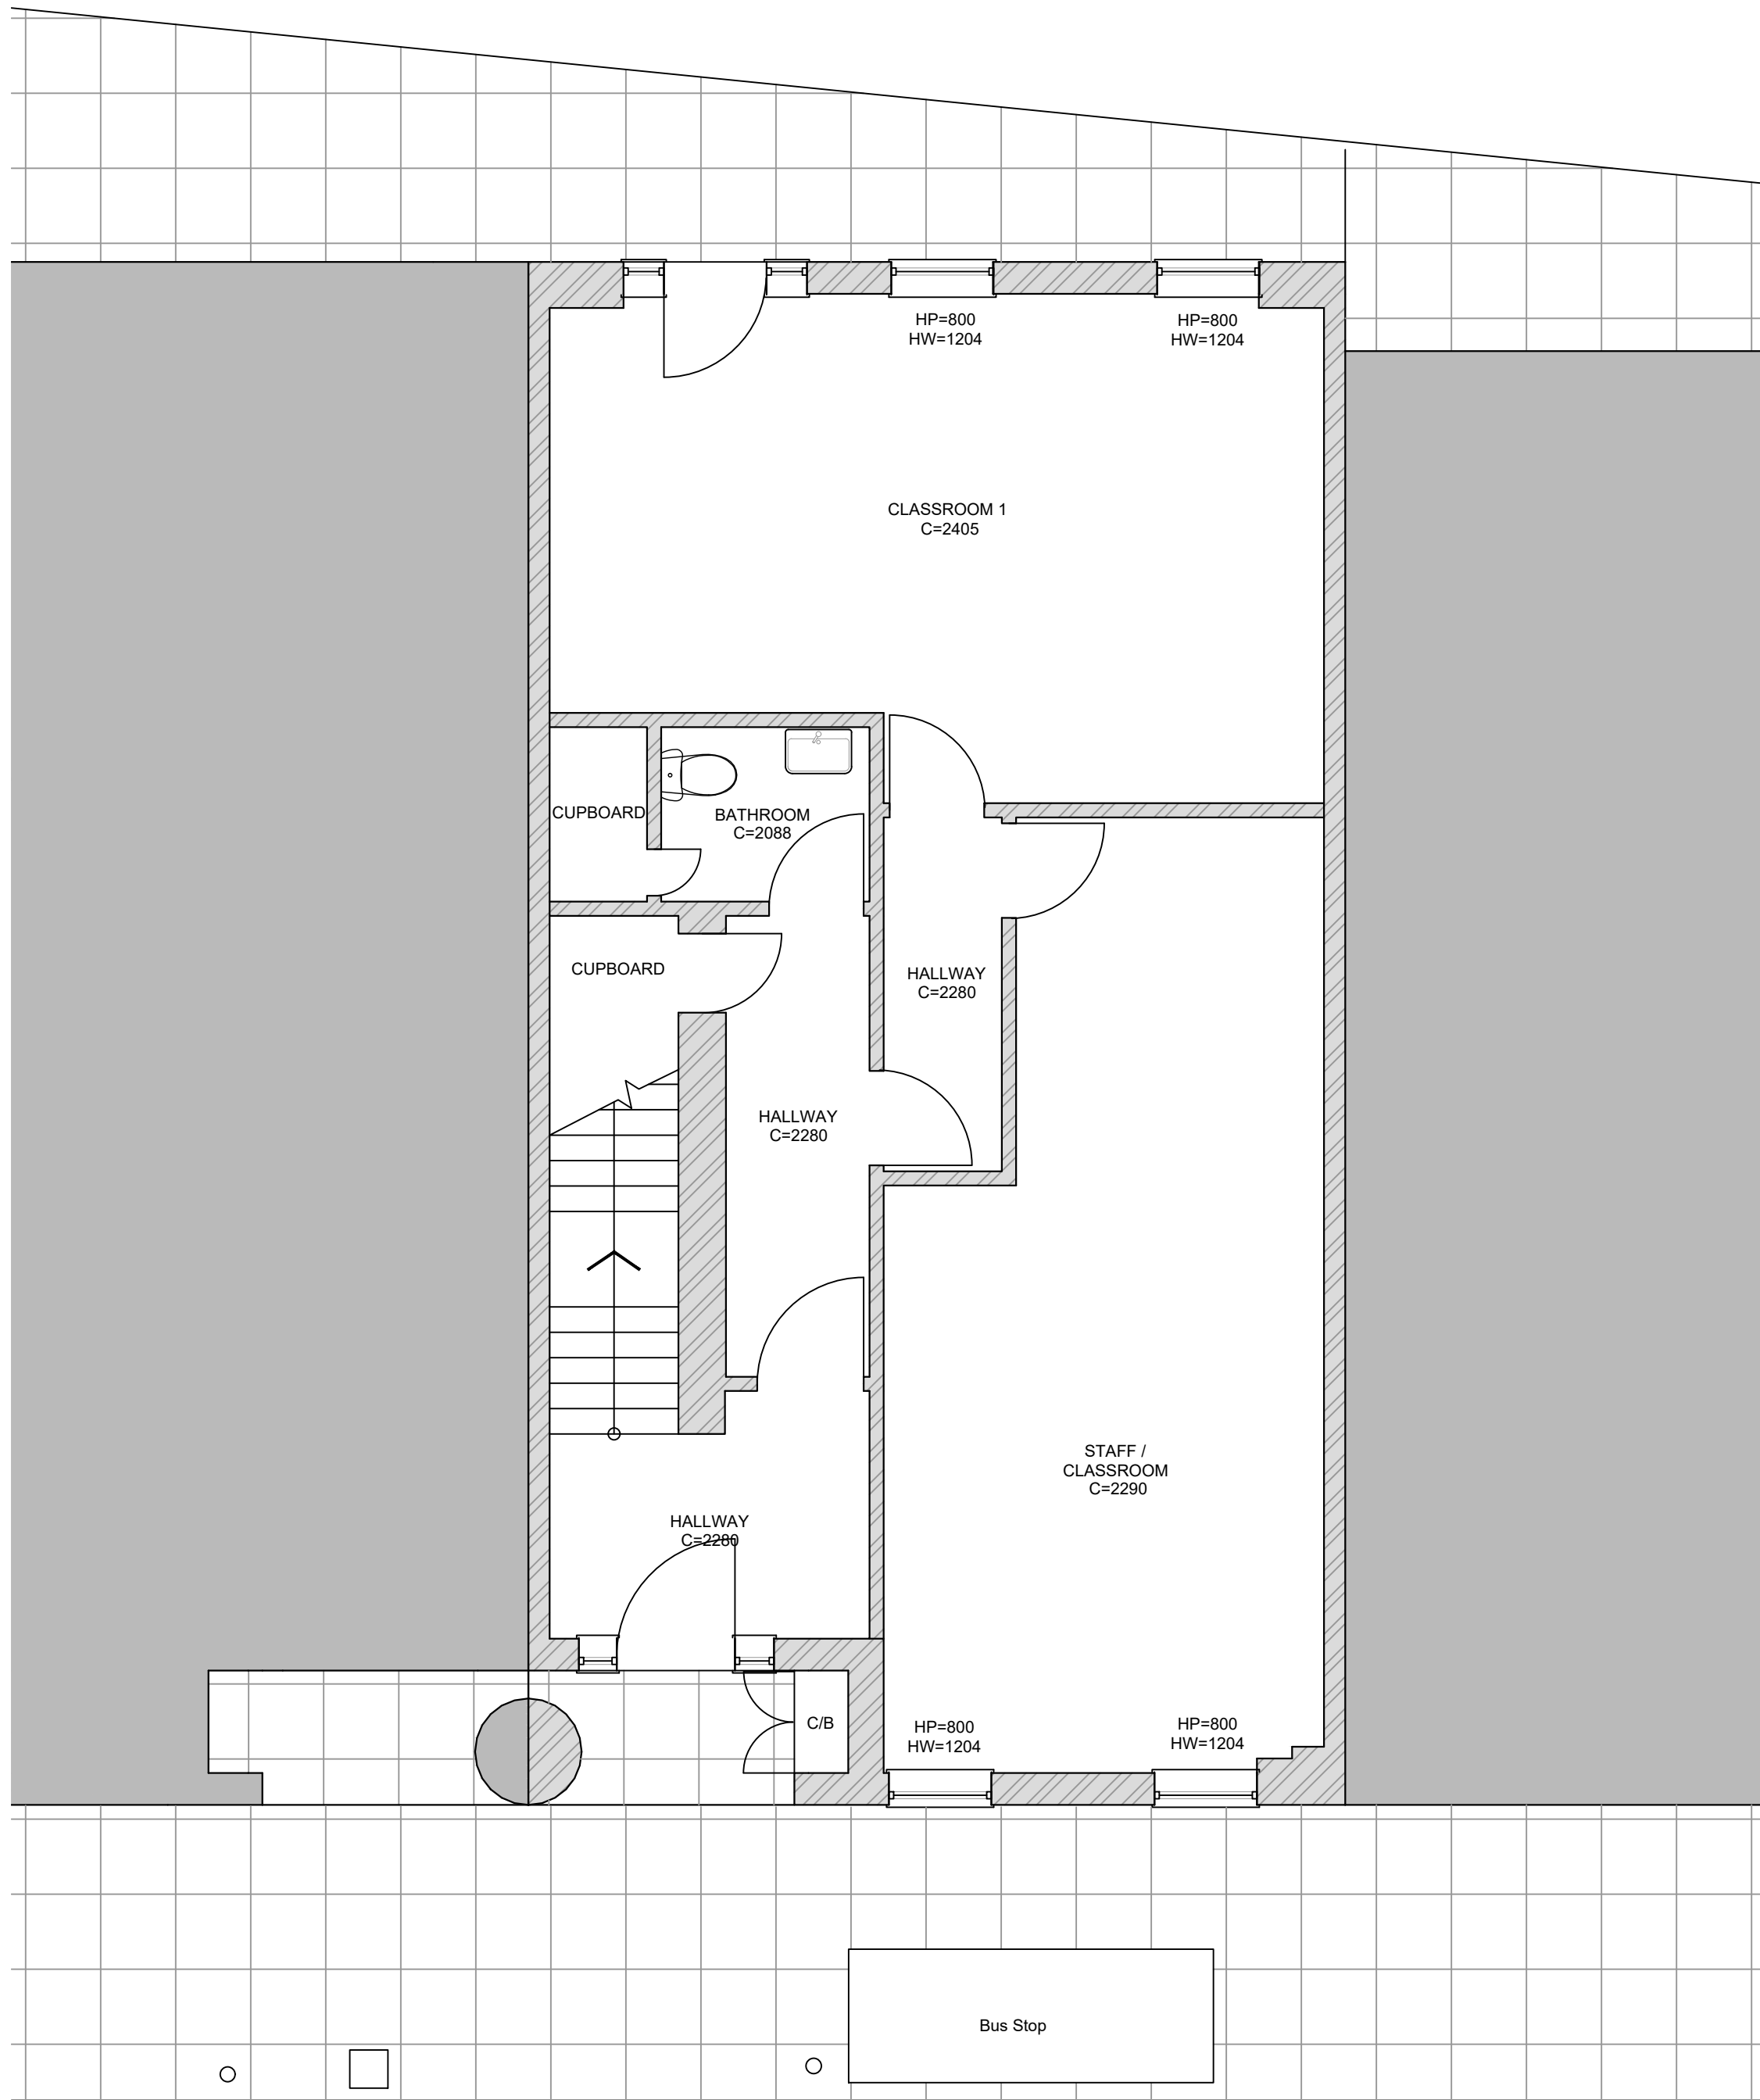

GROUND FLOOR PLAN

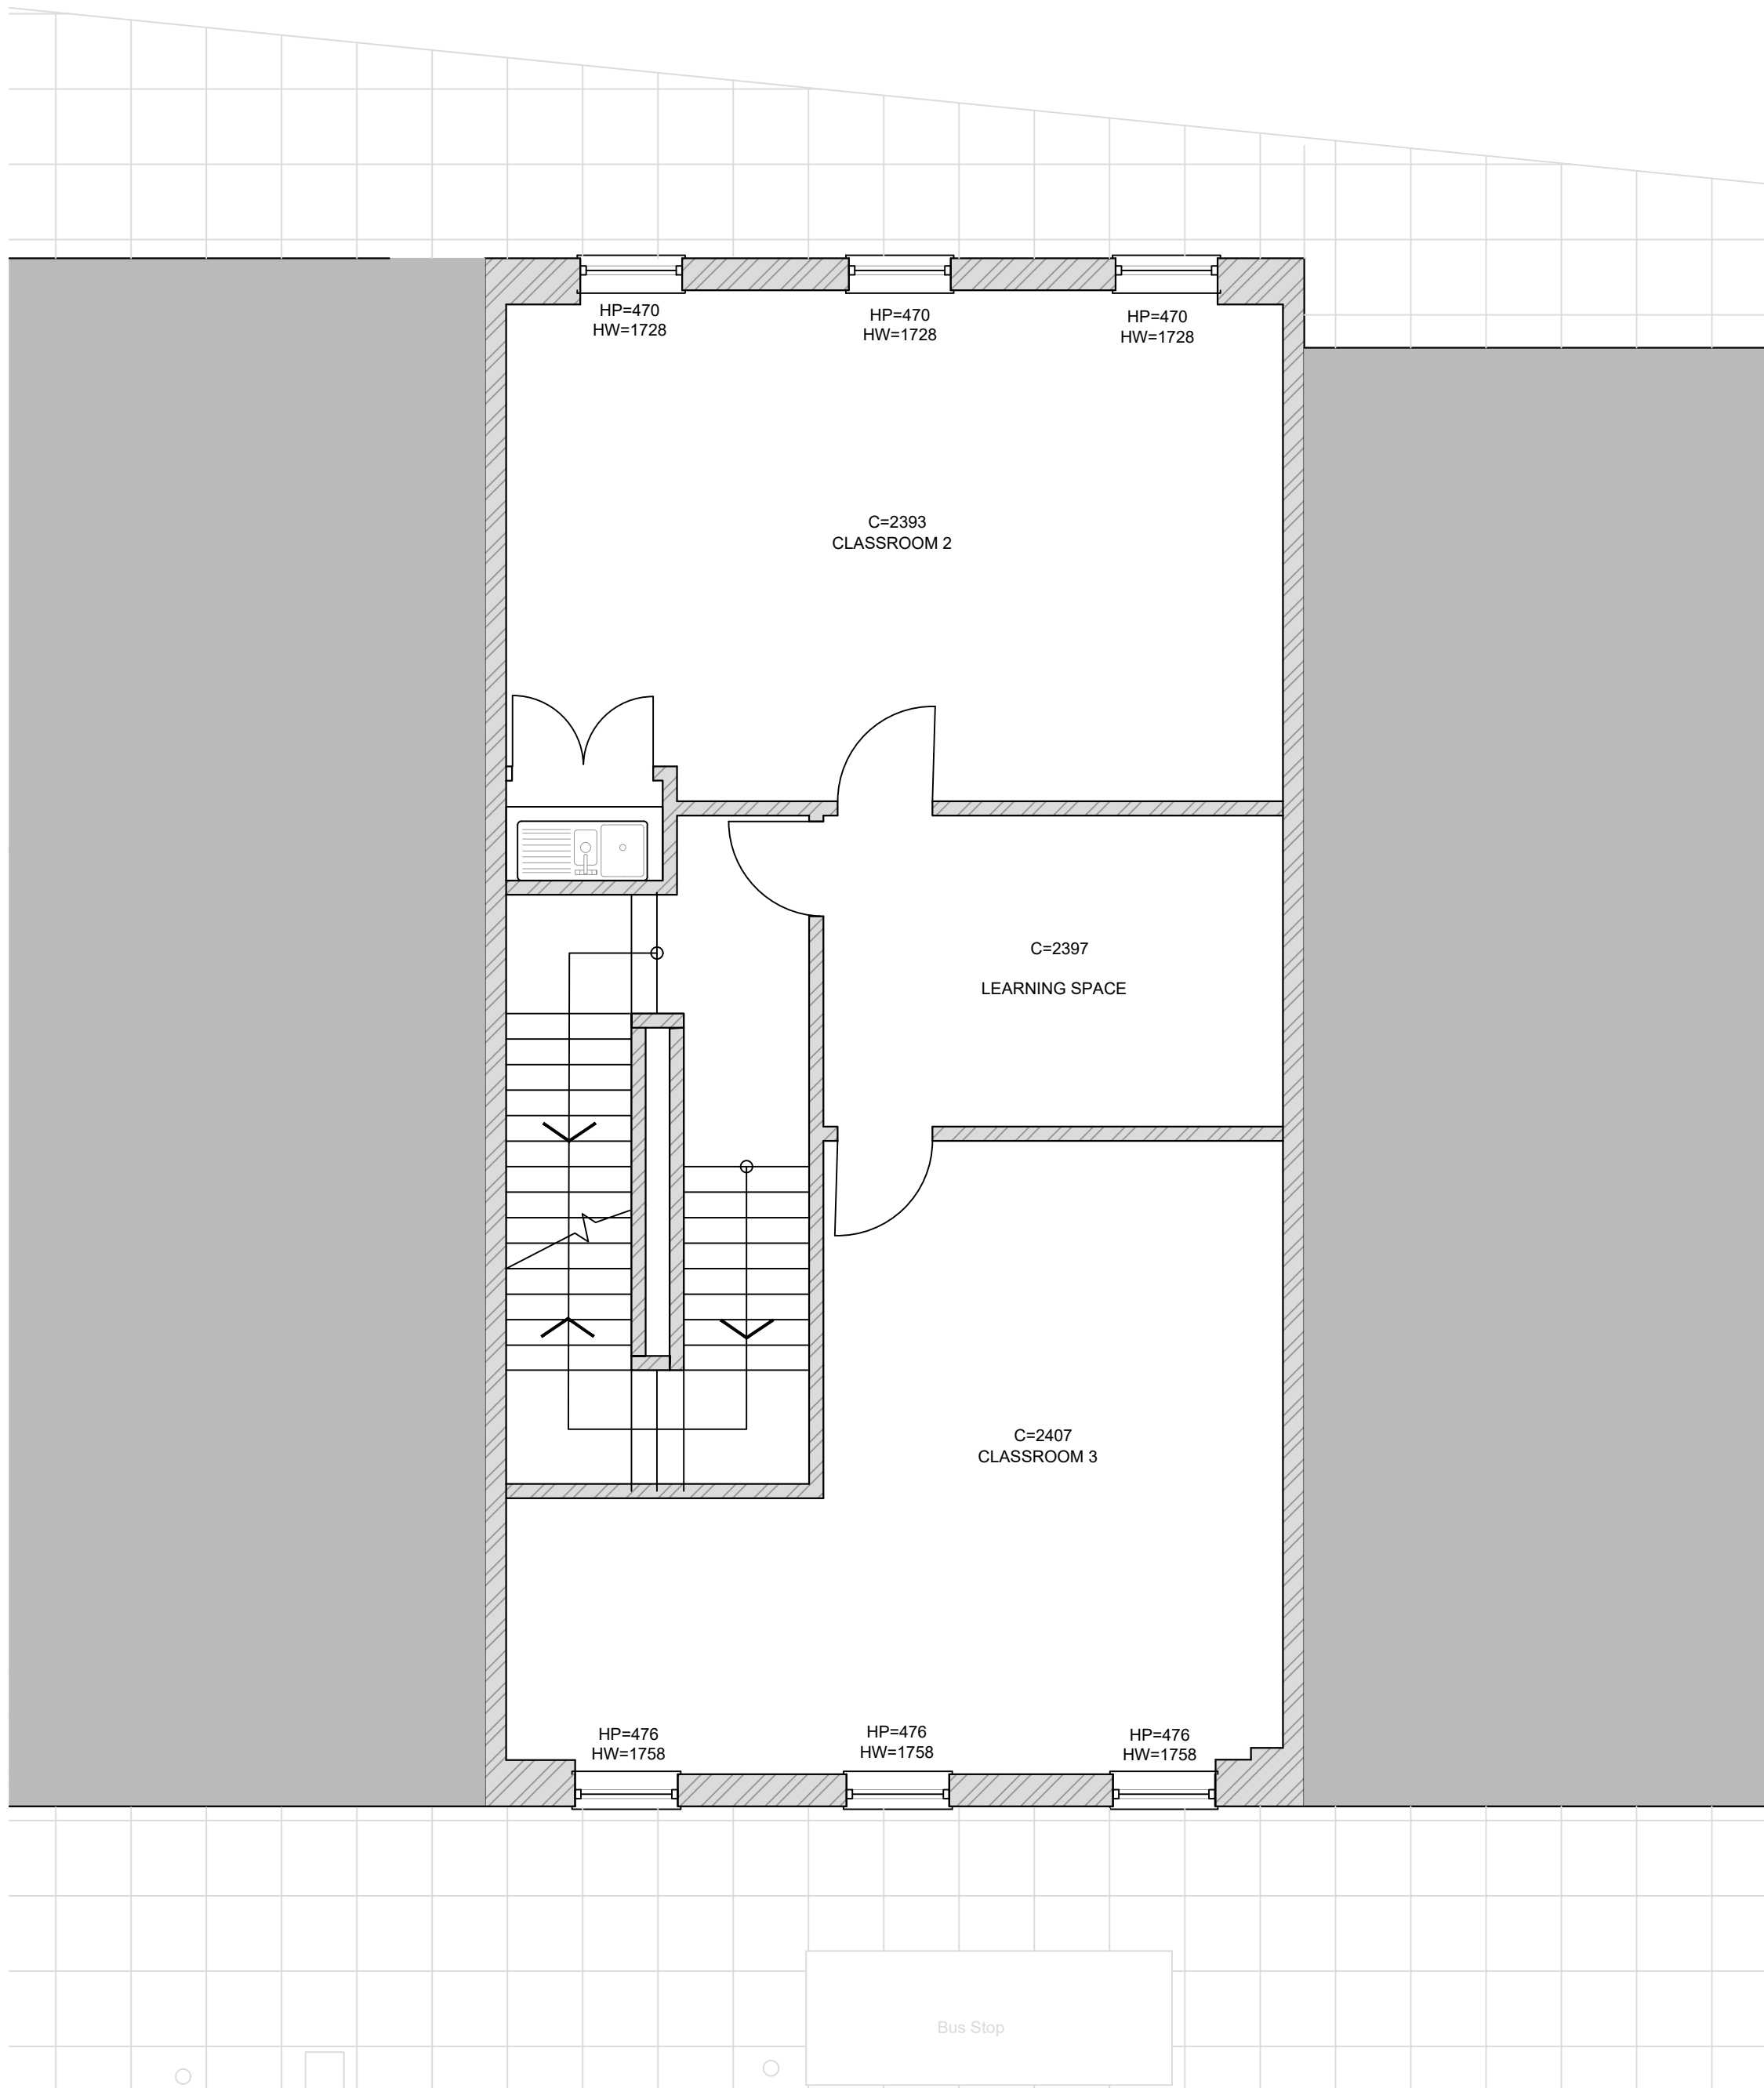

FIRST FLOOR PLAN

DRAWING, CONSTRUCTION AND MATERIAL NOTES :

1. THE COPYRIGHT OF THIS DRAWING IS VESTED IN PRINGLEDISIGN+ LIMITED AND IT MAY NOT BE REPRODUCED IN WHOLE OR PART OR USED FOR THE MANUFACTURE OF ANY ARTICLE WITHOUT THE EXPRESS PERMISSION OF THE COPYRIGHT HOLDERS.
2. BE CERTAIN TO WORK TO FIGURED DIMENSIONS ONLY.
3. THE DRAWING IS TO BE READ IN CONJUNCTION WITH ALL RELEVANT STRUCTURAL ENGINEERS, SERVICE ENGINEERS AND PRINGLEDISIGN+ DRAWINGS AND SPECIFICATIONS.
4. IF YOU ARE NOT CERTAIN OF ANYTHING INDICATED ON THE DRAWINGS ASK!


DRAWING KEY & SYMBOLS

- existing wall / structure (tbc if structural by engineer)
- proposed structural wall (tbc if structural by engineer)
- proposed partition (tbc if structural by engineer)
- existing foul water drainage run (tbc)
- proposed structural beam (tbc by the engineer)
- direction of staircase (arrow in upwards direction)

ABBREVIATIONS

- cbd cupboard
- ic inspection chamber
- rwp rain water pipe
- syp soil vent pipe
- rl roof light / window

SCALE BAR 1:50

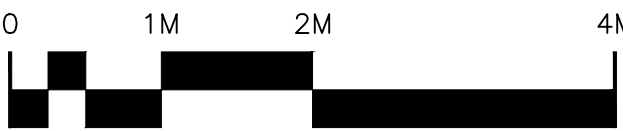

	Issue for review	CP	24.04.24
REV:	DESCRIPTION:	BY:	DATE:
STATUS: S U R V E Y			


PRINGLE.DESIGN

est. 2015 UK / SE


32 The Drive
Wallington
Surrey
SM6 9LX
Pringledesign@Outlook.com
0208 432 2864

CLIENT: Islington Centre for English

SITE:	98 White Lion Street London N1 9PF		
TITLE:	EXISTING FLOOR PLANS (sheet 01 of 02)		
SCALE AT A1: 1:50	DATE: 24/04/24	DRAWN: CP	CHECKED: CP
PROJECT NO: PD-0438	DRAWING NO: A1-03	REVISION: *	

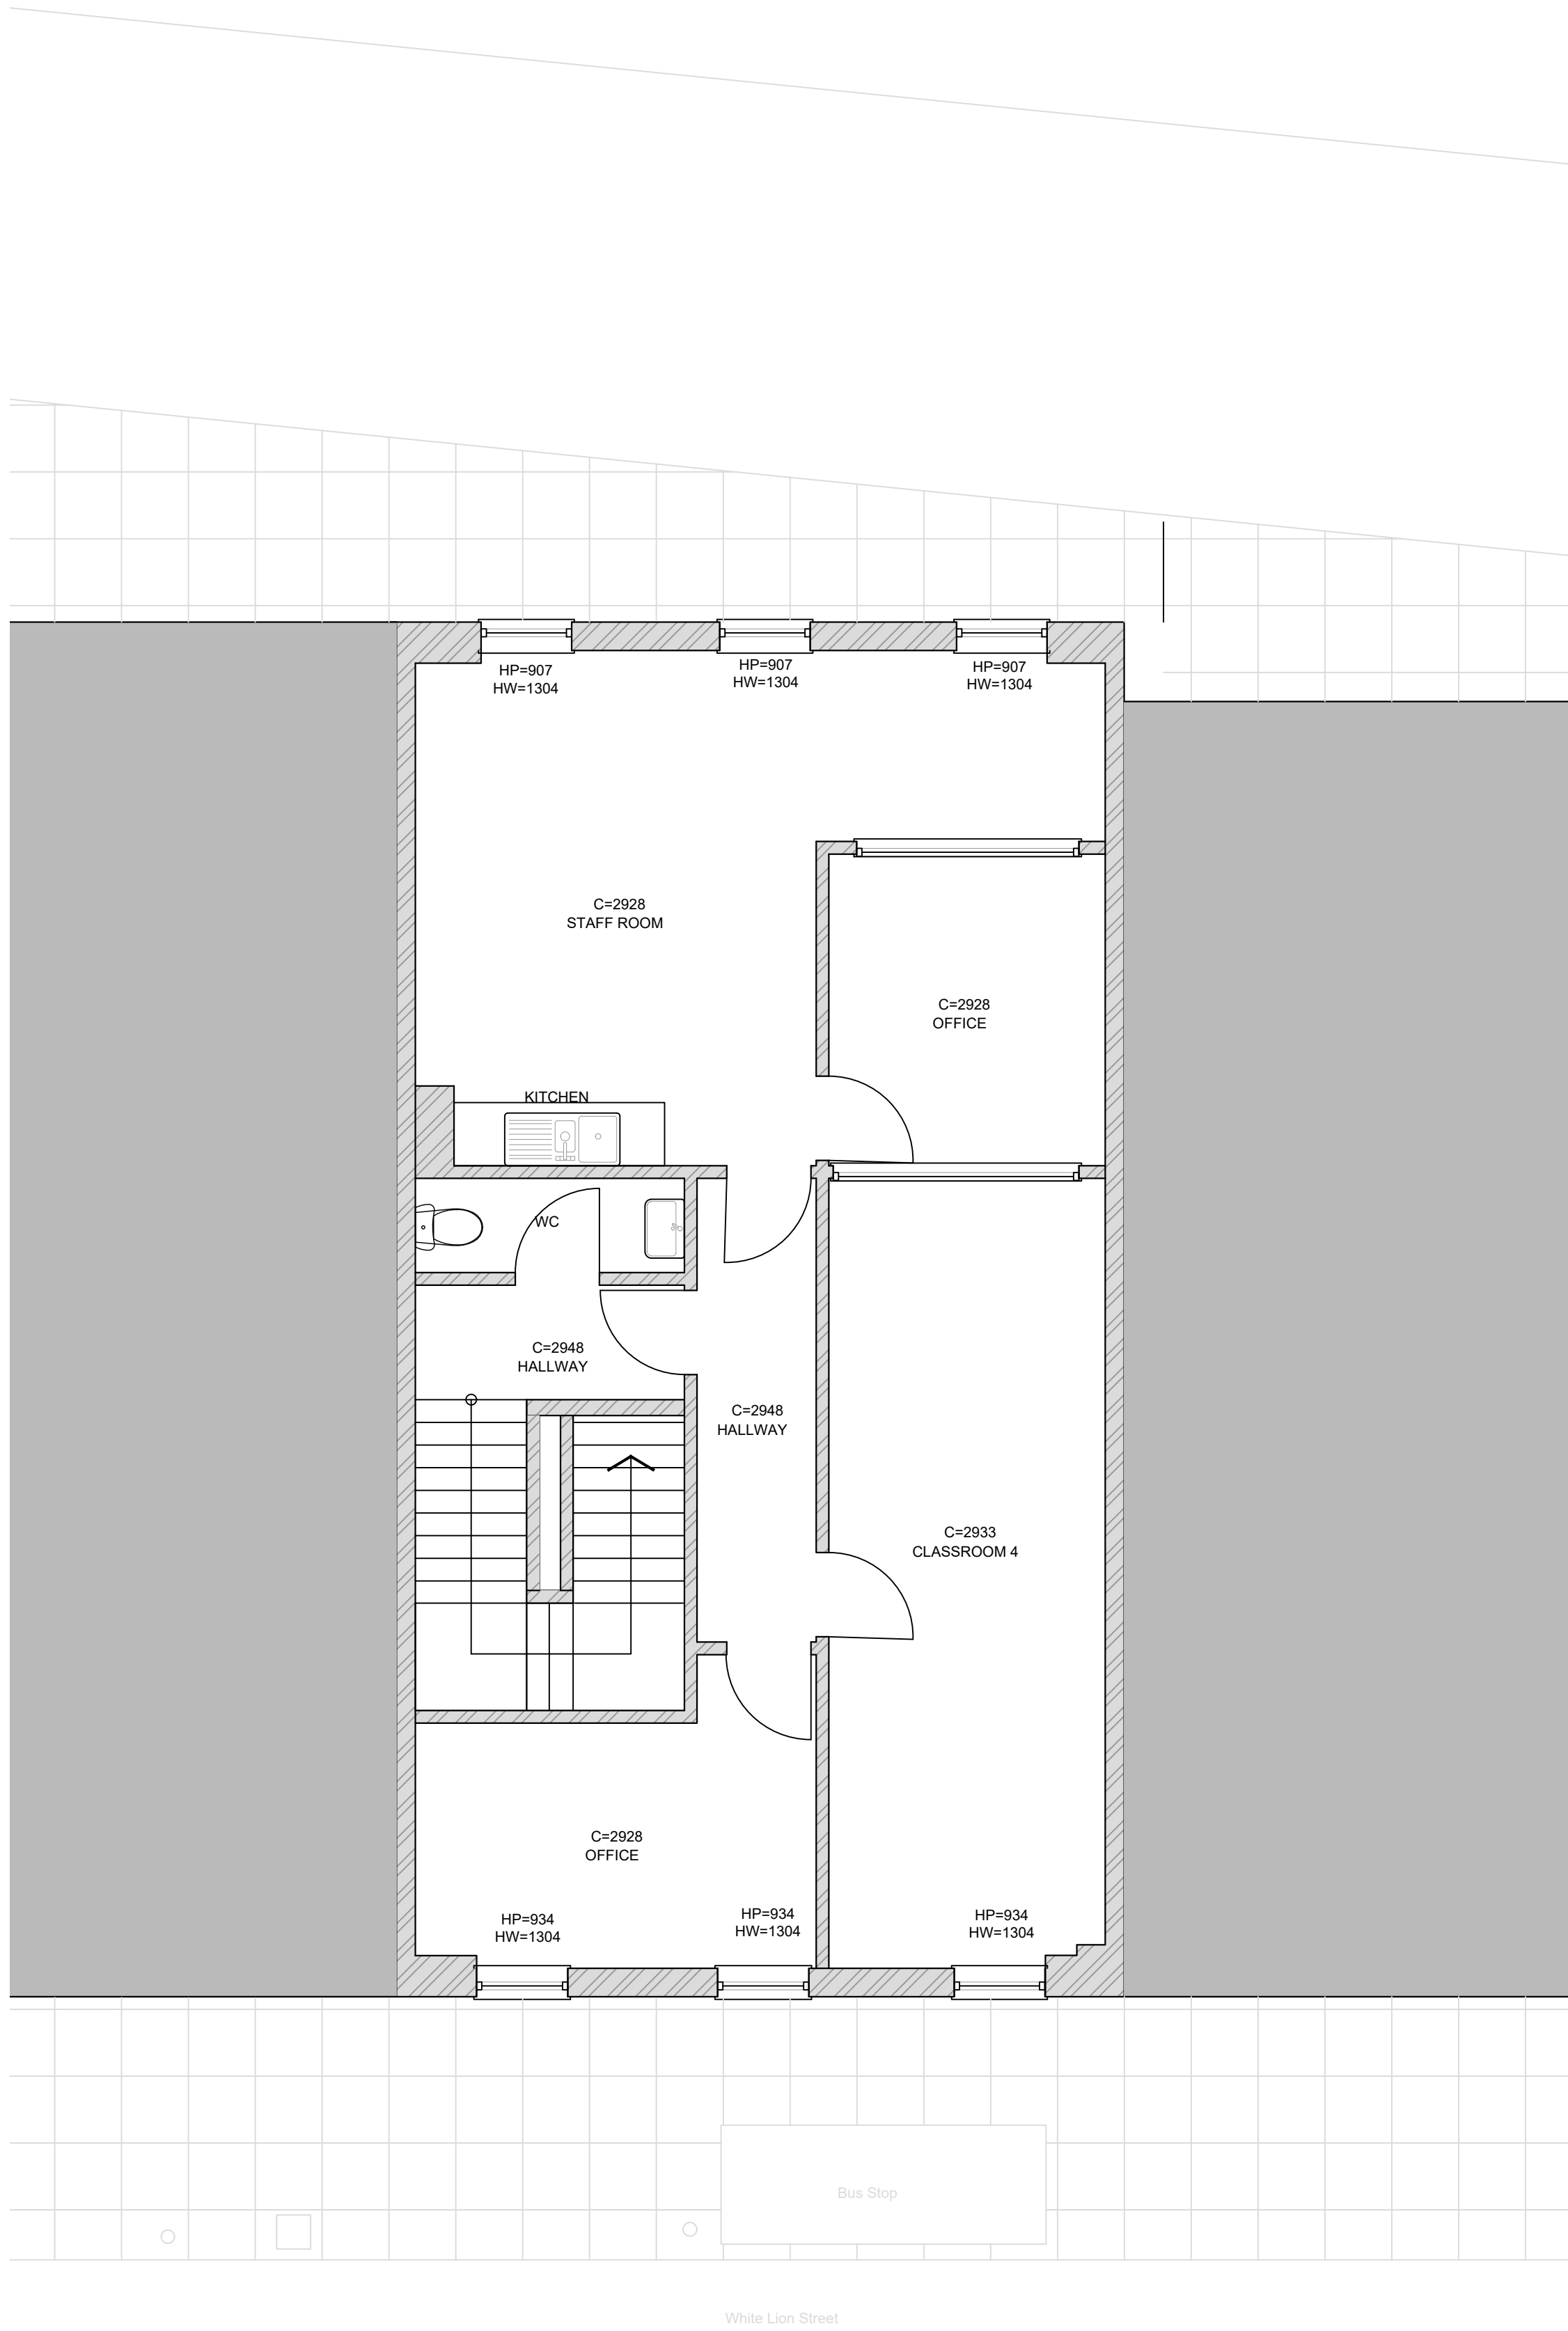

SECOND FLOOR PLAN

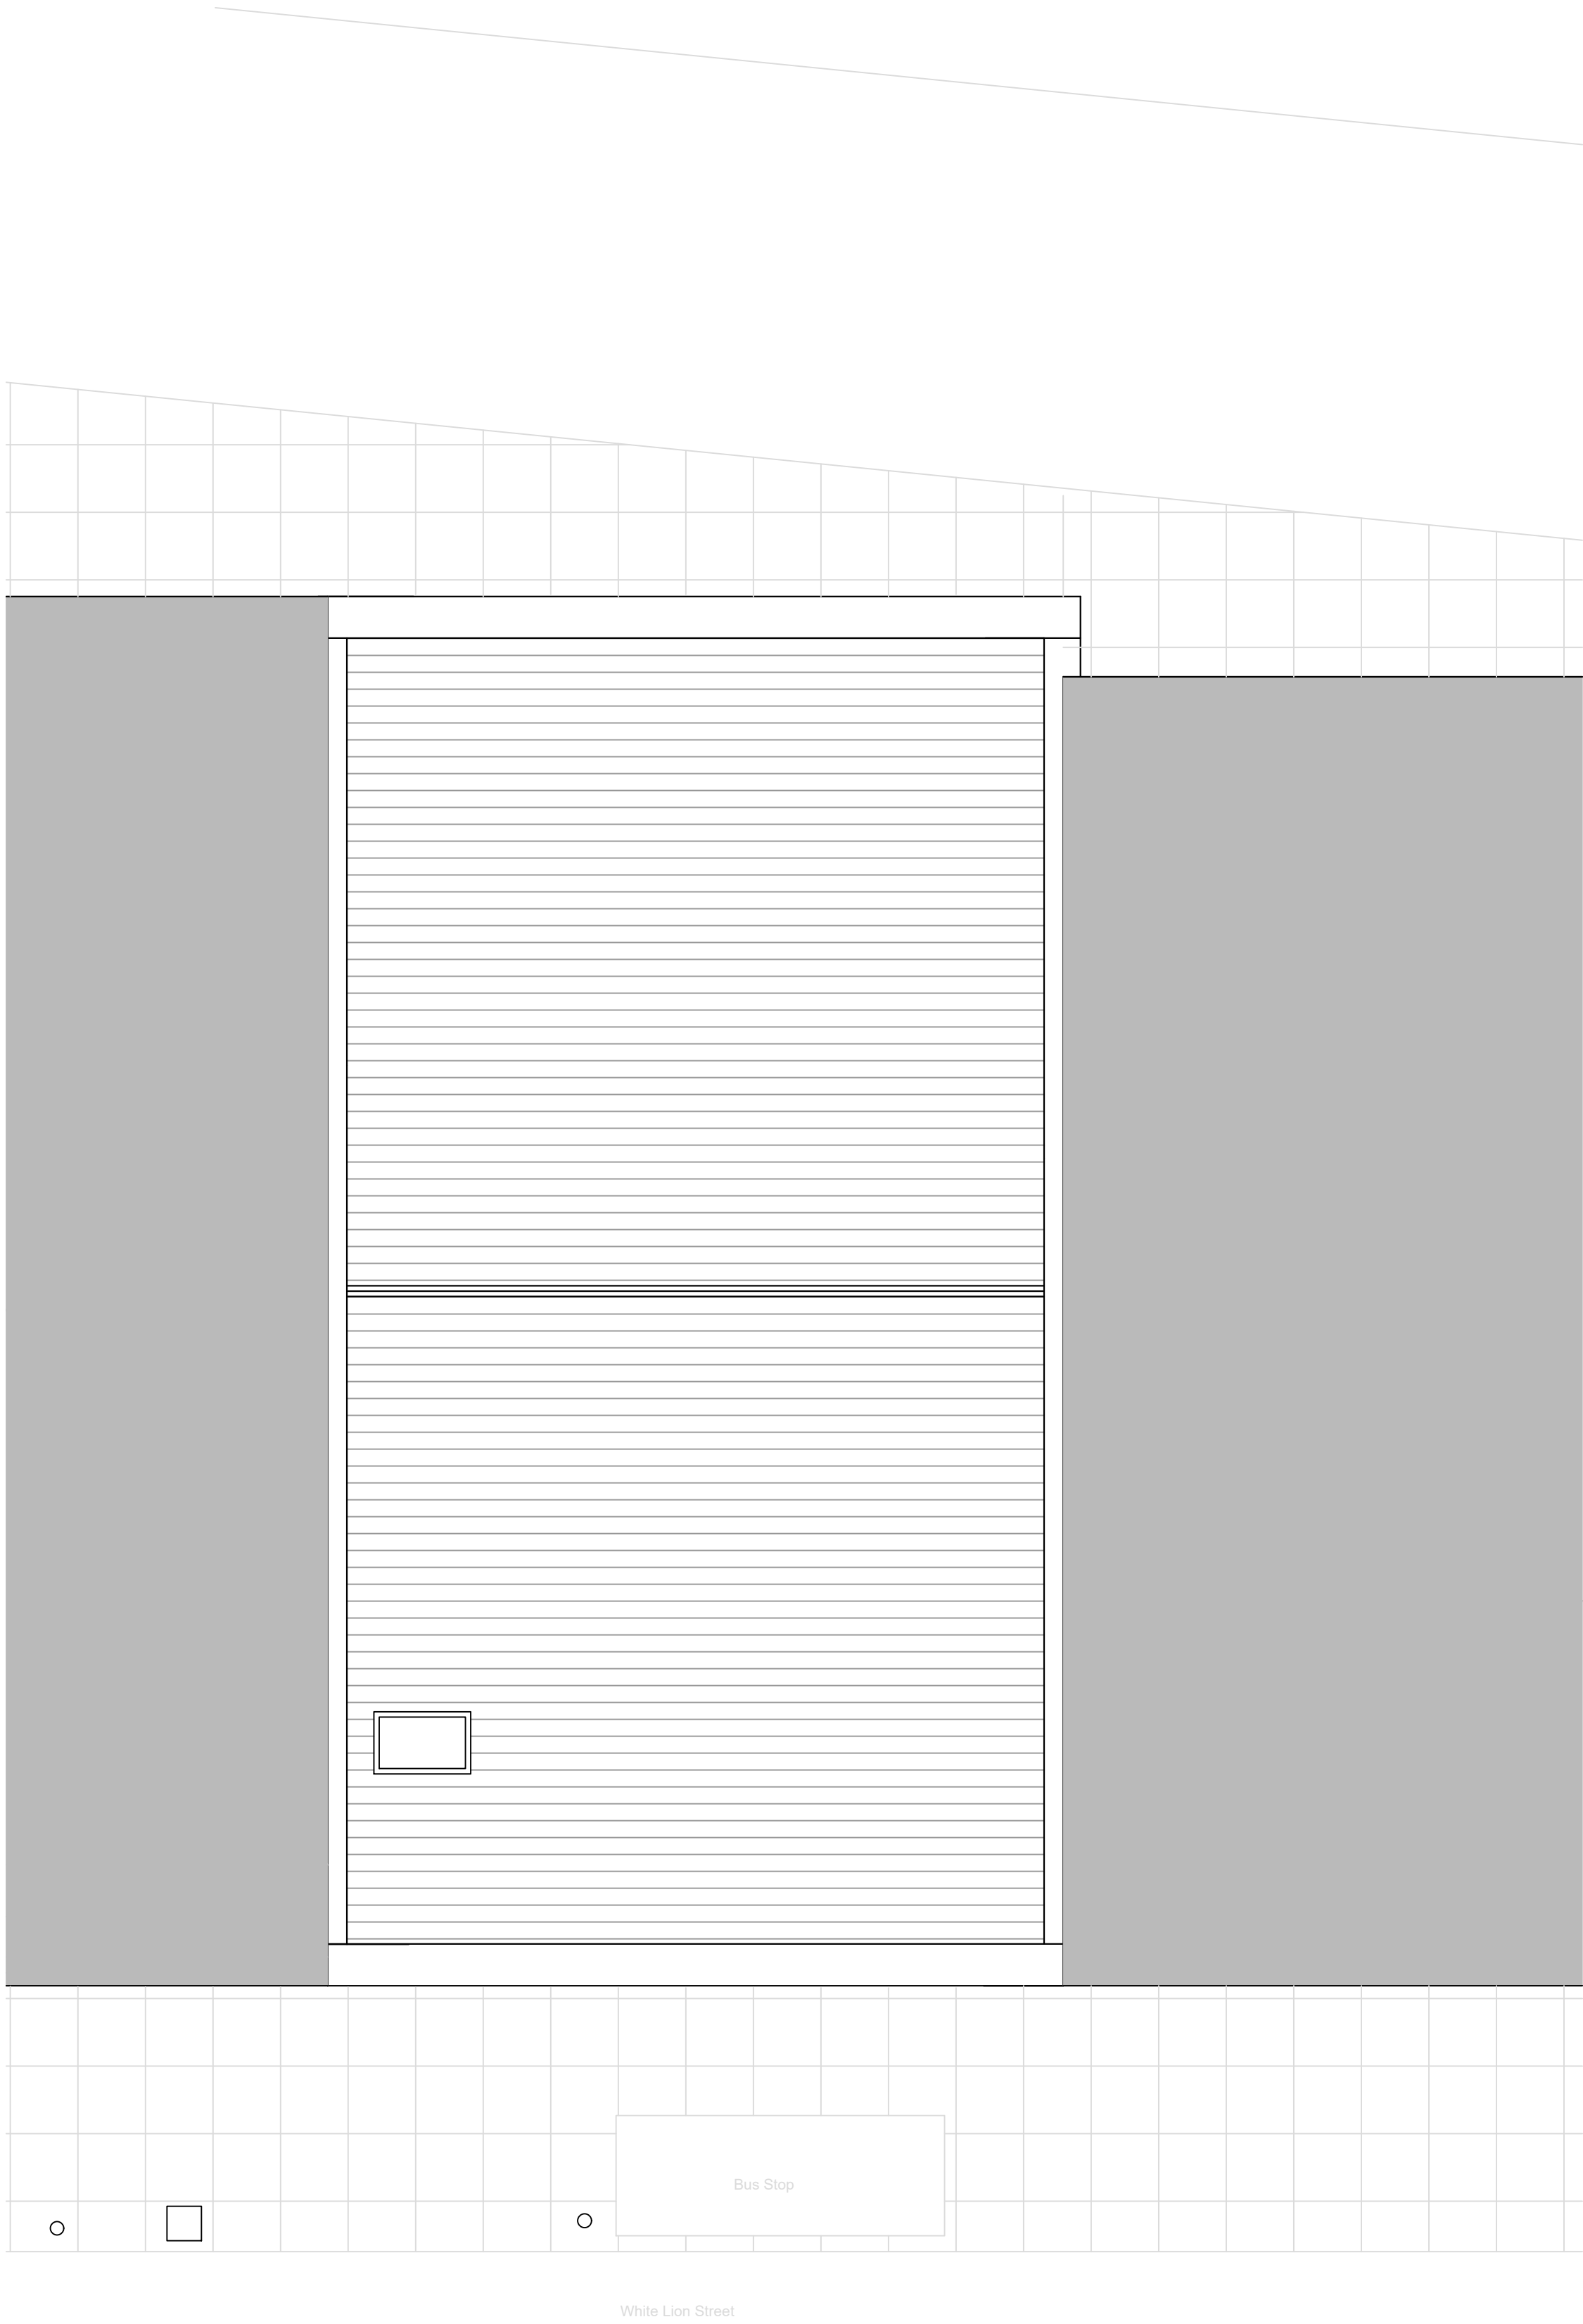

ROOF PLAN

DRAWING, CONSTRUCTION AND MATERIAL NOTES :

1. THE COPYRIGHT OF THIS DRAWING IS VESTED IN PRINGLEDISIGN+ LIMITED AND IT MAY NOT BE REPRODUCED IN WHOLE OR PART OR USED FOR THE MANUFACTURE OF ANY ARTICLE WITHOUT THE EXPRESS PERMISSION OF THE COPYRIGHT HOLDERS.
2. BE CERTAIN TO WORK TO FIGURED DIMENSIONS ONLY.
3. THE DRAWING IS TO BE READ IN CONJUNCTION WITH ALL RELEVANT STRUCTURAL ENGINEERS, SERVICE ENGINEERS AND PRINGLEDISIGN+ DRAWINGS AND SPECIFICATIONS.
4. IF YOU ARE NOT CERTAIN OF ANYTHING INDICATED ON THE DRAWINGS ASK!


DRAWING KEY & SYMBOLS

- existing wall / structure (tbc if structural by engineer)
- proposed structural wall (tbc if structural by engineer)
- proposed partition (tbc if structural by engineer)
- existing foul water drainage run (tbc)
- proposed structural beam (tbc by the engineer)
- direction of staircase (arrow in upwards direction)

ABBREVIATIONS

- cbd cupboard
- ic inspection chamber
- rwp rain water pipe
- syp soil vent pipe
- rl roof light / window

SCALE BAR 1:50

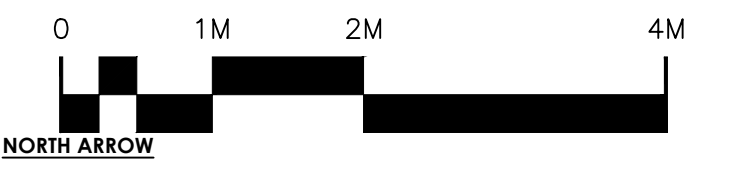

*	Issue for review	CP	24.04.24
REV:	DESCRIPTION:	BY:	DATE:
STATUS:			
S	U	R	V
E	Y		

PRINGLE.DESIGN

est. 2015 UK / SE

32 The Drive
Wallington
Surrey
SM6 9LX
Pringledesign@Outlook.com
0208 432 2864

CLIENT: Islington Centre for English

SITE: 98 White Lion Street
London
N1 9PF

TITLE: EXISTING FLOOR PLANS
(sheet 02 of 02)

SCALE AT A1: 1:50	DATE: 24/04/24	DRAWN: TW	CHECKED: CP
PROJECT NO: PD-0438	DRAWING NO: A1-04	REVISION: *	



FRONT ELEVATION



REAR ELEVATION

DRAWING, CONSTRUCTION AND MATERIAL NOTES :

1. THE COPYRIGHT OF THIS DRAWING IS VESTED IN PRINGLEDESIGN+ LIMITED AND IT MAY NOT BE REPRODUCED IN WHOLE OR PART OR USED FOR THE MANUFACTURE OF ANY ARTICLE WITHOUT THE EXPRESS PERMISSION OF THE COPYRIGHT HOLDERS.
2. BE CERTAIN TO WORK TO FIGURED DIMENSIONS ONLY.
3. THIS DRAWING IS TO BE READ IN CONJUNCTION WITH ALL RELEVANT STRUCTURAL ENGINEERS, SERVICE ENGINEERS AND PRINGLEDESIGN+ DRAWINGS AND SPECIFICATIONS.
4. IF YOU ARE NOT CERTAIN OF ANYTHING INDICATED ON THE DRAWINGS ASK!


DRAWING KEY & SYMBOLS

-  existing wall / structure (tbc if structural by engineer)
-  proposed structural wall (tbc if structural by engineer)
-  proposed partition (tbc if structural by engineer)
-  existing foul water drainage run (tbc)
-  proposed structural beam (tbc by the engineer)
-  direction of staircase (arrow in upwards direction)

ABBREVIATIONS

- cbd cupboard
- ic inspection chamber
- rwp rain water pipe
- svp soil vent pipe
- rl roof light / window

SCALE BAR 1:50

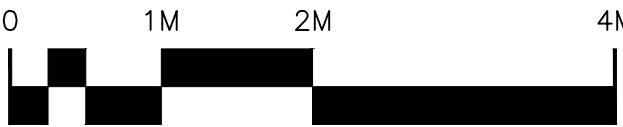

*	Issue for review	CP	24.04.24
REV:	DESCRIPTION:	BY:	DATE:
STATUS:			
S	U	R	V
E	Y		

PRINGLE.DESIGN

est. 2015 UK / SE

32 The Drive
Wallington
Surrey
SM6 9LX
Pringledesign@Outlook.com
0208 432 2864

CLIENT: Islington Centre for English

SITE: 98 White Lion Street
London
N1 9PF

TITLE: EXISTING ELEVATIONS

SCALE AT A1: 1:50	DATE: 24/04/24	DRAWN: TW	CHECKED: CPCP
PROJECT NO: PD-0438	DRAWING NO: A1-05	REVISION: *	