bdg

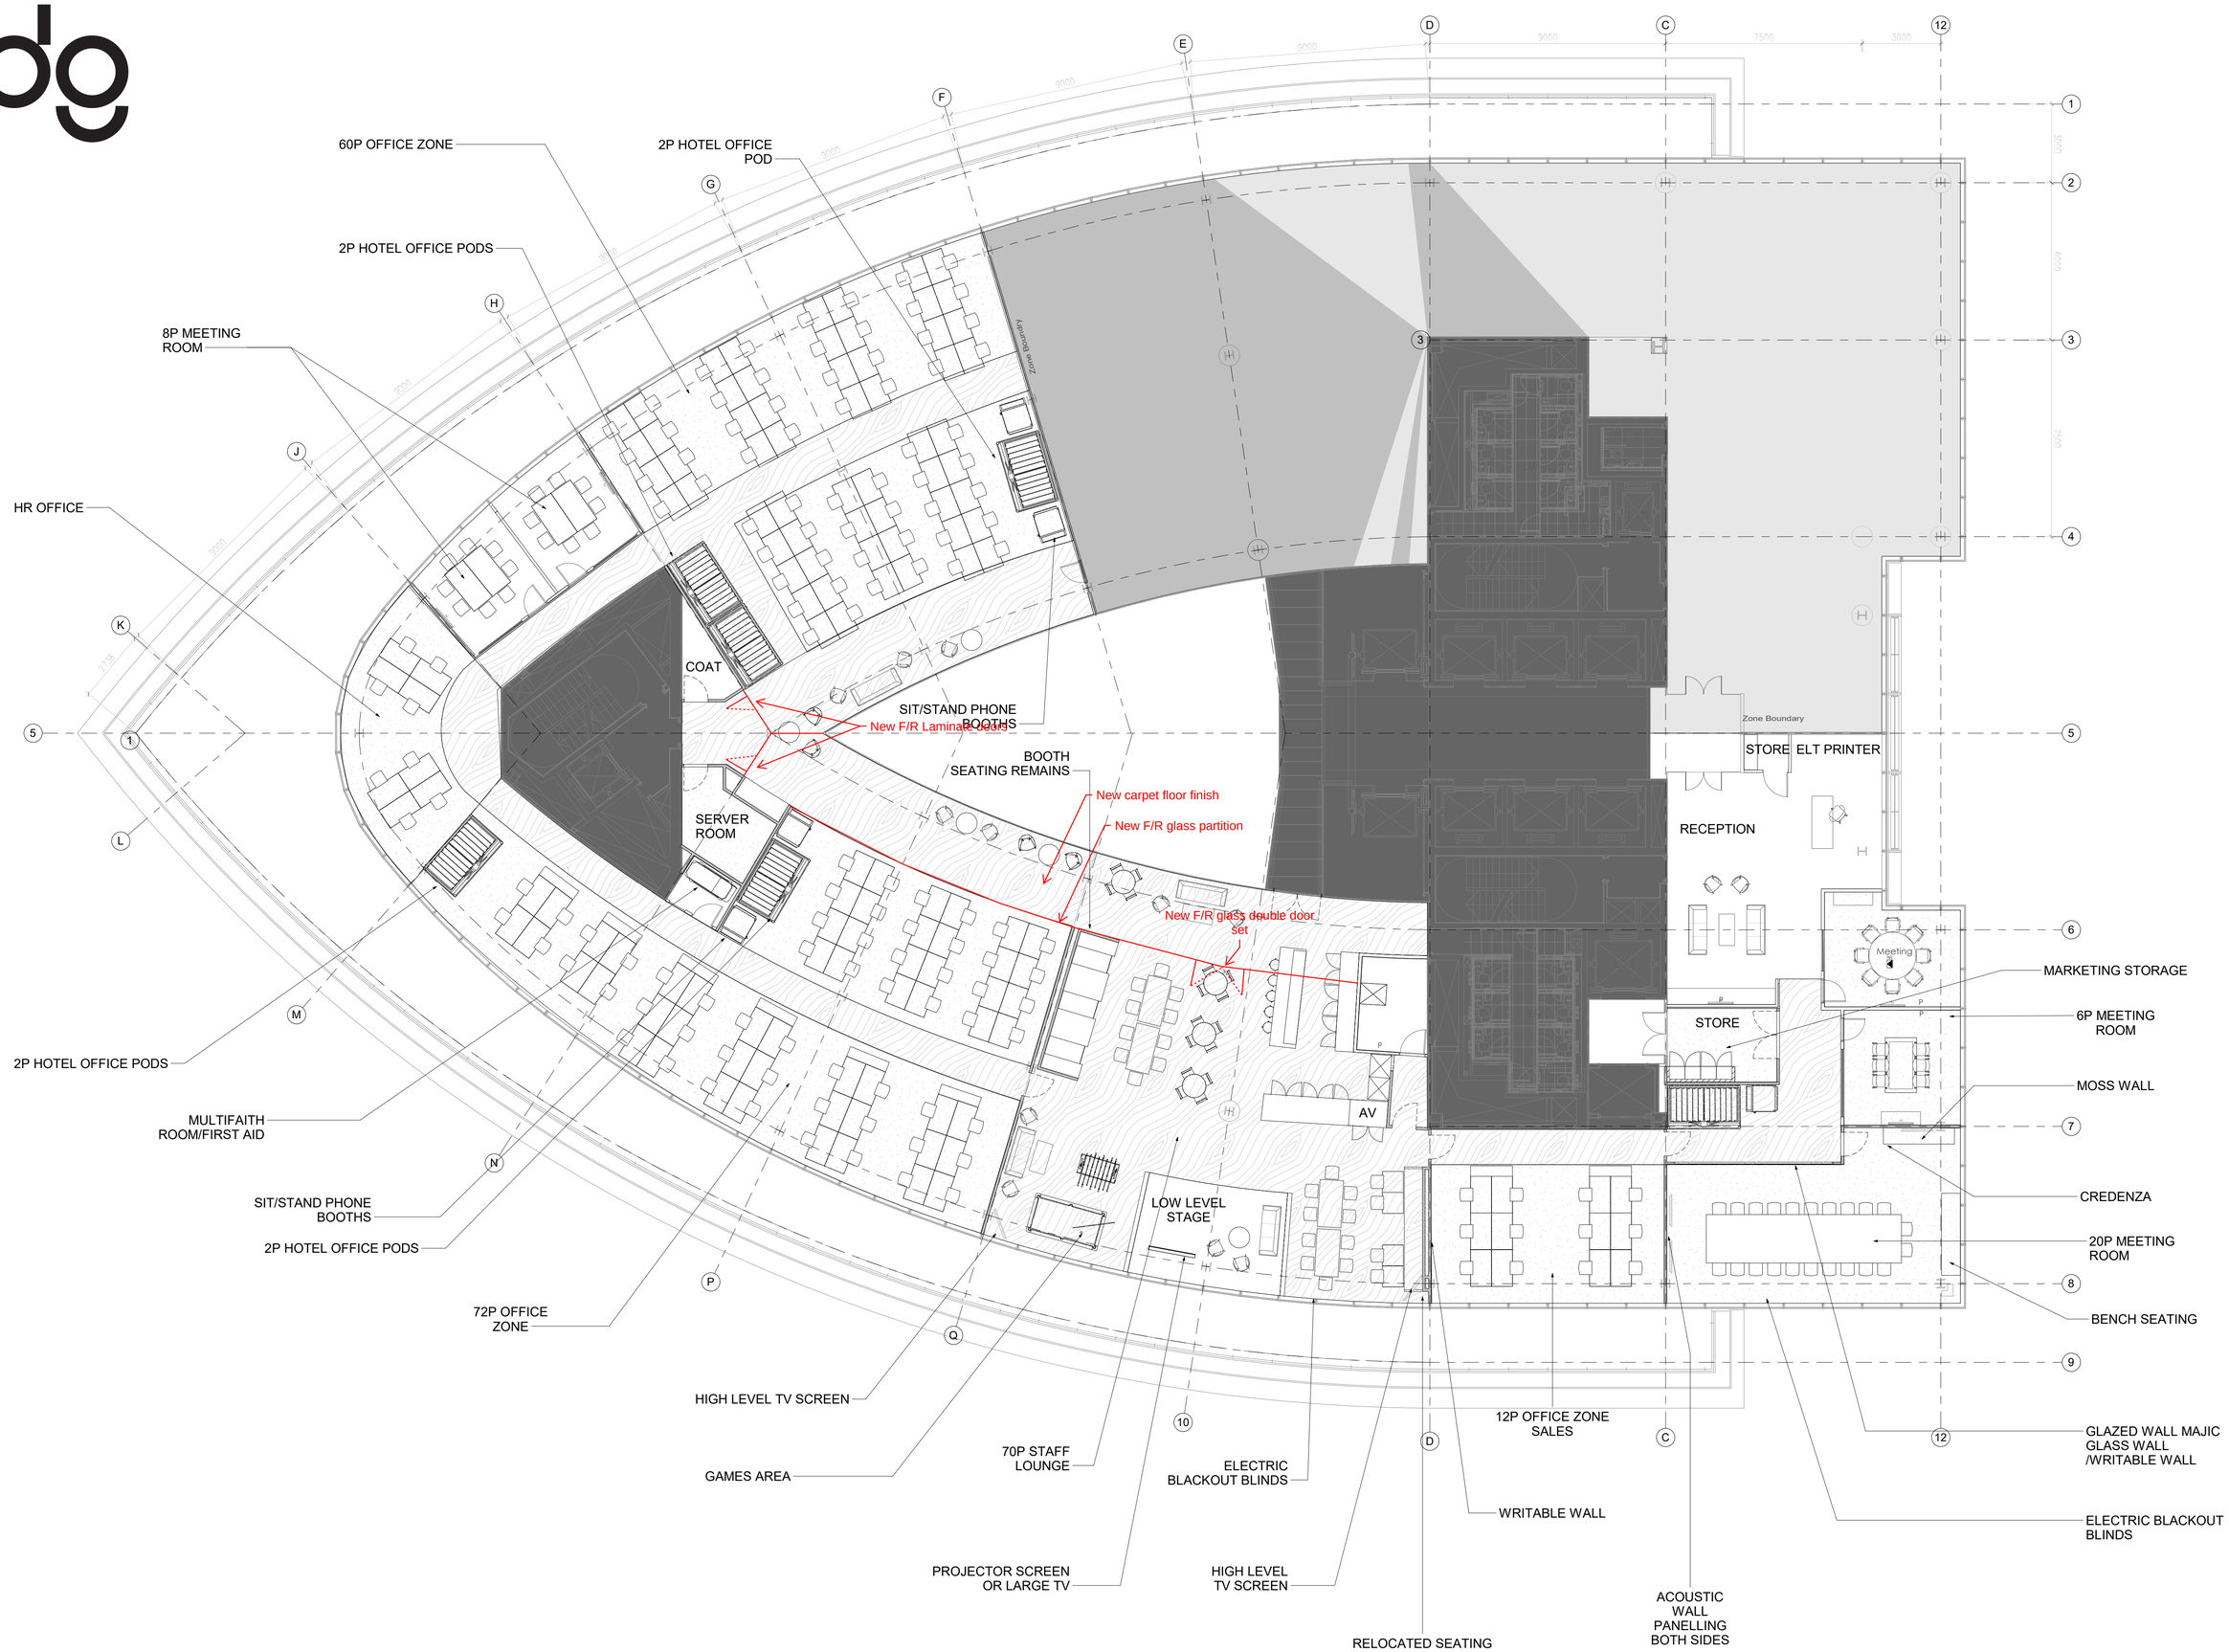
60P OFFICE ZONE
2P HOTEL OFFICE POD
2P HOTEL OFFICE PODS
8P MEETING ROOM
HR OFFICE
COAT
SIT/STAND PHONE BOOTHS
New F/R Laminate doors
BOOTH SEATING REMAINS
New carpet floor finish
New F/R glass partition
SERVER ROOM
New F/R glass double door set
Zone Boundary
STORE
ELT PRINTER
RECEPTION
Meeting
MARKETING STORAGE
6P MEETING ROOM
MOSS WALL
STORE
AV
CREDENZA
20P MEETING ROOM
BENCH SEATING
2P HOTEL OFFICE PODS
MULTIFAITH ROOM/FIRST AID
SIT/STAND PHONE BOOTHS
2P HOTEL OFFICE PODS
LOW LEVEL STAGE
72P OFFICE ZONE
HIGH LEVEL TV SCREEN
GAMES AREA
70P STAFF LOUNGE
ELECTRIC BLACKOUT BLINDS
12P OFFICE ZONE SALES
WRITABLE WALL
GLAZED WALL MAJIC GLASS WALL /WRITABLE WALL
ELECTRIC BLACKOUT BLINDS
PROJECTOR SCREEN OR LARGE TV
HIGH LEVEL TV SCREEN
RELOCATED SEATING
ACOUSTIC WALL PANELLING BOTH SIDES