


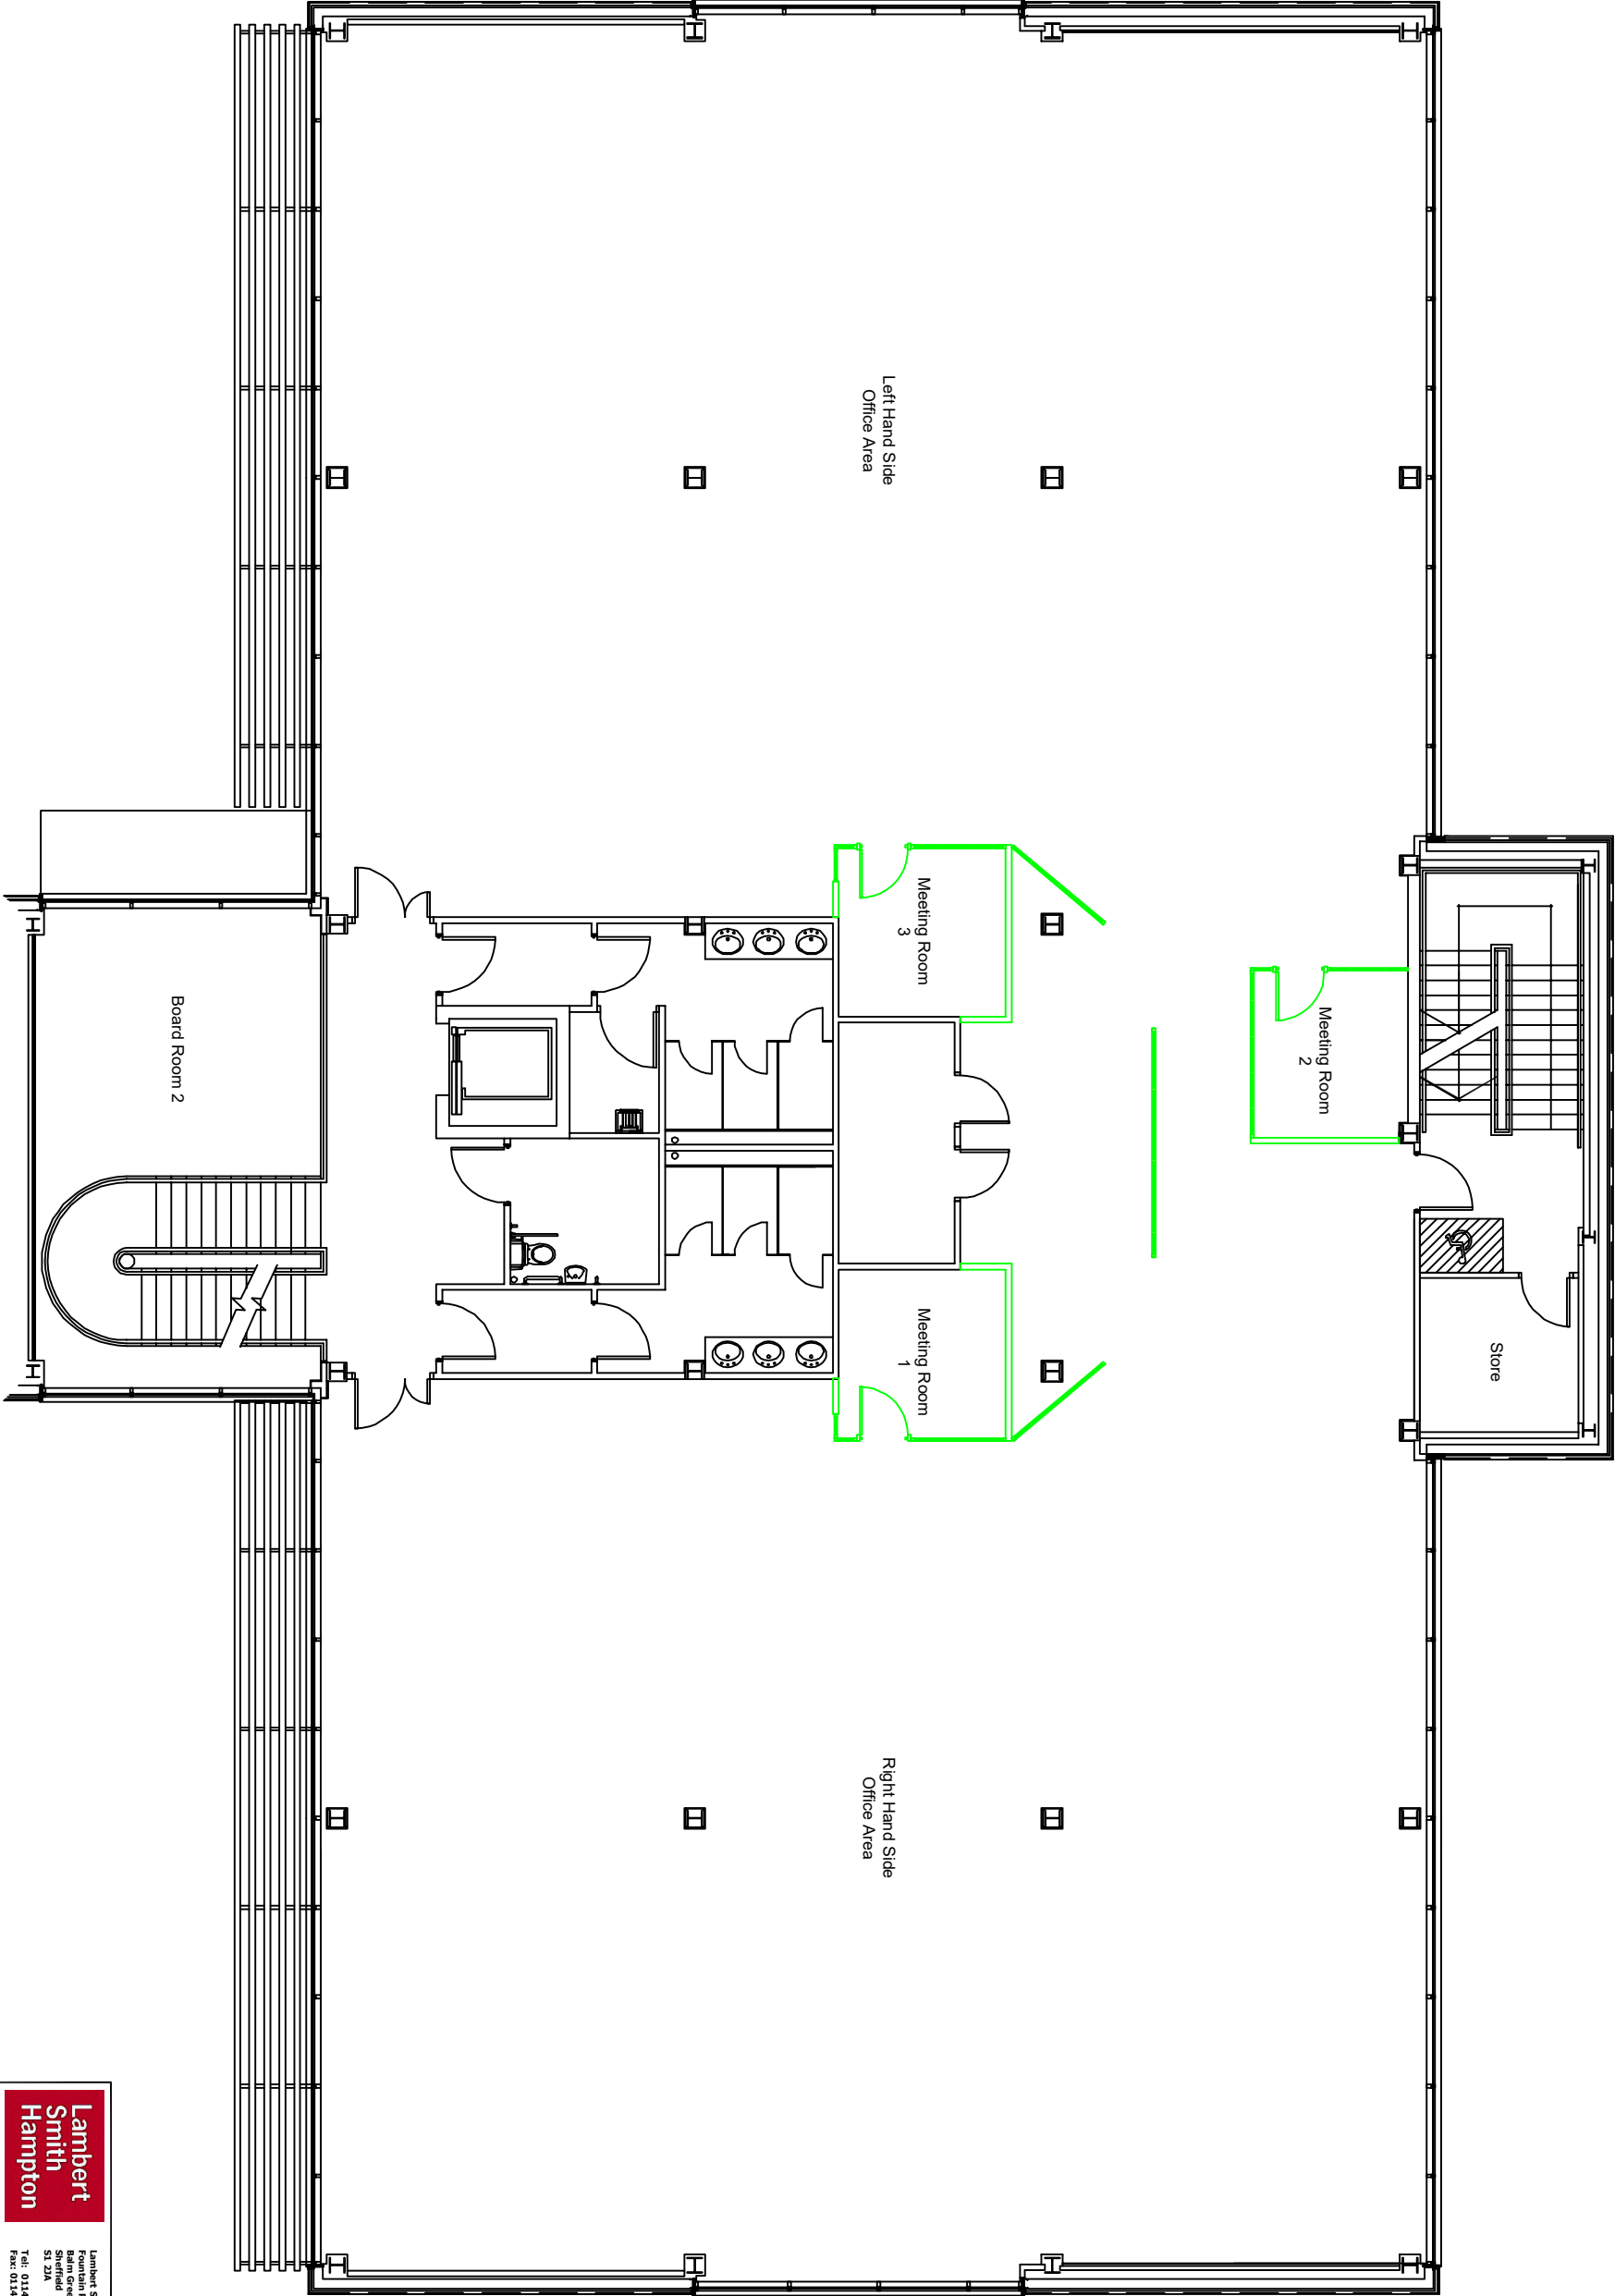

Lambert Smith Hampton
Foundation Precinct
Sheffield
S1 2JA
Tel: 0114 275 3762
Fax: 0114273 8963

Site Name:
UNIT 2 EUROPA VIEW

Title:
INDICATIVE FIRST FLOOR LAYOUT PLAN

Date:
28.06.11

Scale:
A3 @ NTS

Dwg No:
ESBLD2010.015-002