


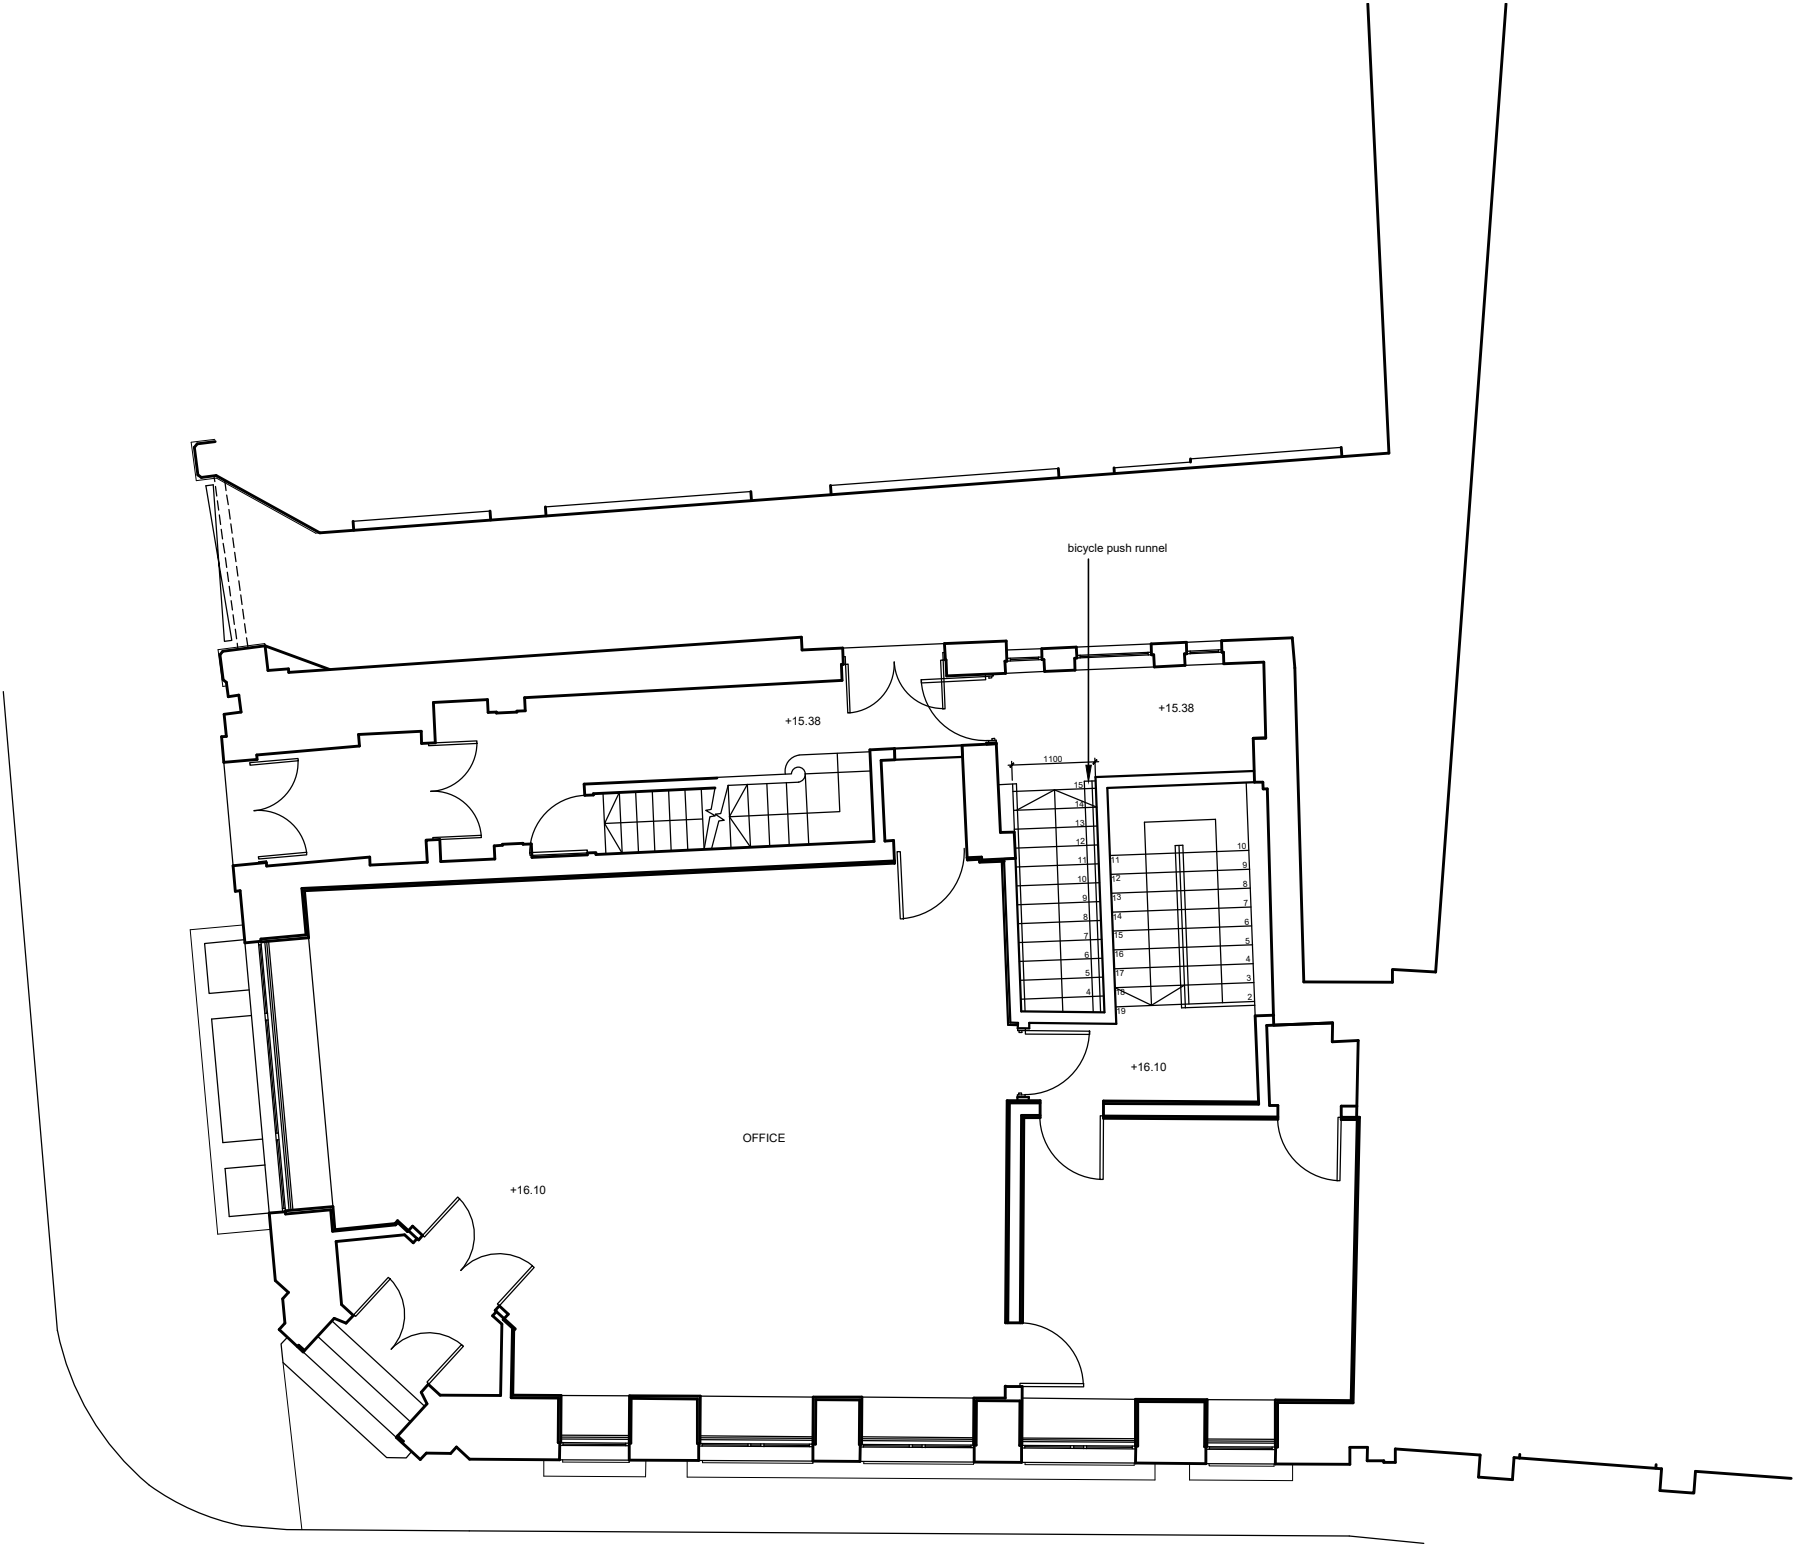

Ground Floor Plan

notes

A 29.01.26 Bicycle push runnel added

ARTURUS

ARCHITECTS LLP

Arturus Architects LLP, Brentwood, 48 Eastfield, Bristol, BS9 4BE
+44(0)117 962 0994 | www.arturus.co.uk | mailbox@arturus.co.uk
client

Hepburn Estates Ltd
52 Broad Street

Proposed
Ground Floor Plan

project no.	drawing no.	revision	scale
4111	(08)213	A	1:100@A3
date	status	drawn/checked	
28.10.25	planning	gm/rg	

Responsibility is not accepted for errors made by others in scaling this drawing.
Use figured dimensions only. This drawing is copyright. ©2024 Arturus Architects LLP.